


PARENT PARCEL: 06-24-083-102-046

CHILD PARCEL: 06-24-083-102-048 & -049

STARTING POINT: **UNCOMBINATION**

22-04842-U

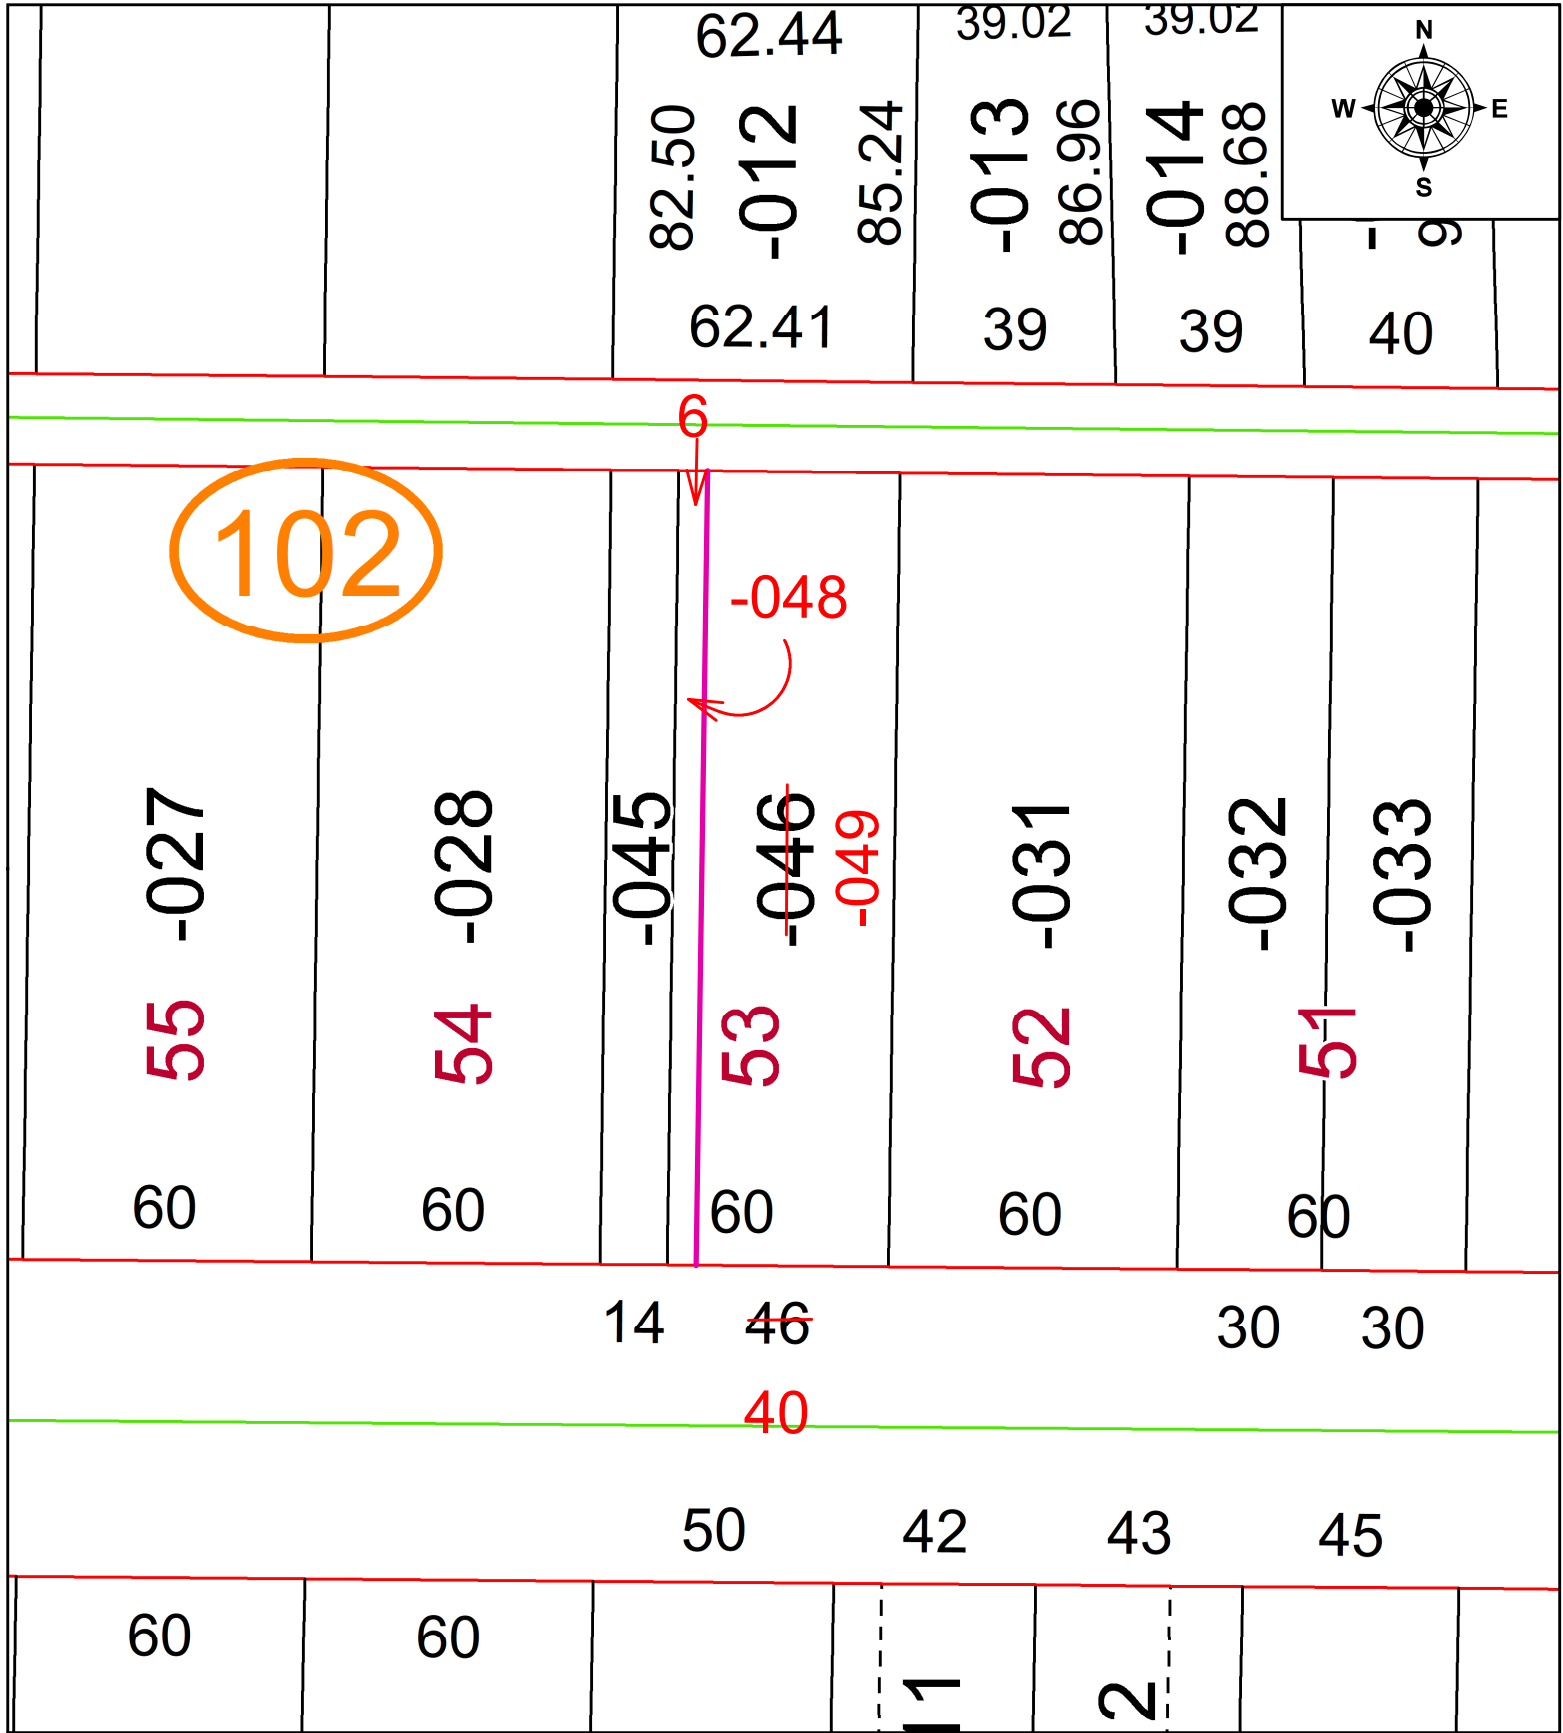

SPLITS/DEEDS PROCESSED
LORAIN COUNTY TAX MAP DEPARTMENT
226 MIDDLE AVE. ELYRIA, OH

SURVEYED BY:	N/A
CLOSURE:	N/A
MAP PAGE(S):	06-80
APPROVED BY:	AC DATE: 4/21/2022
SCALE:	1" = 40' PRIOR INSTRUMENT: 2022- 0859404