
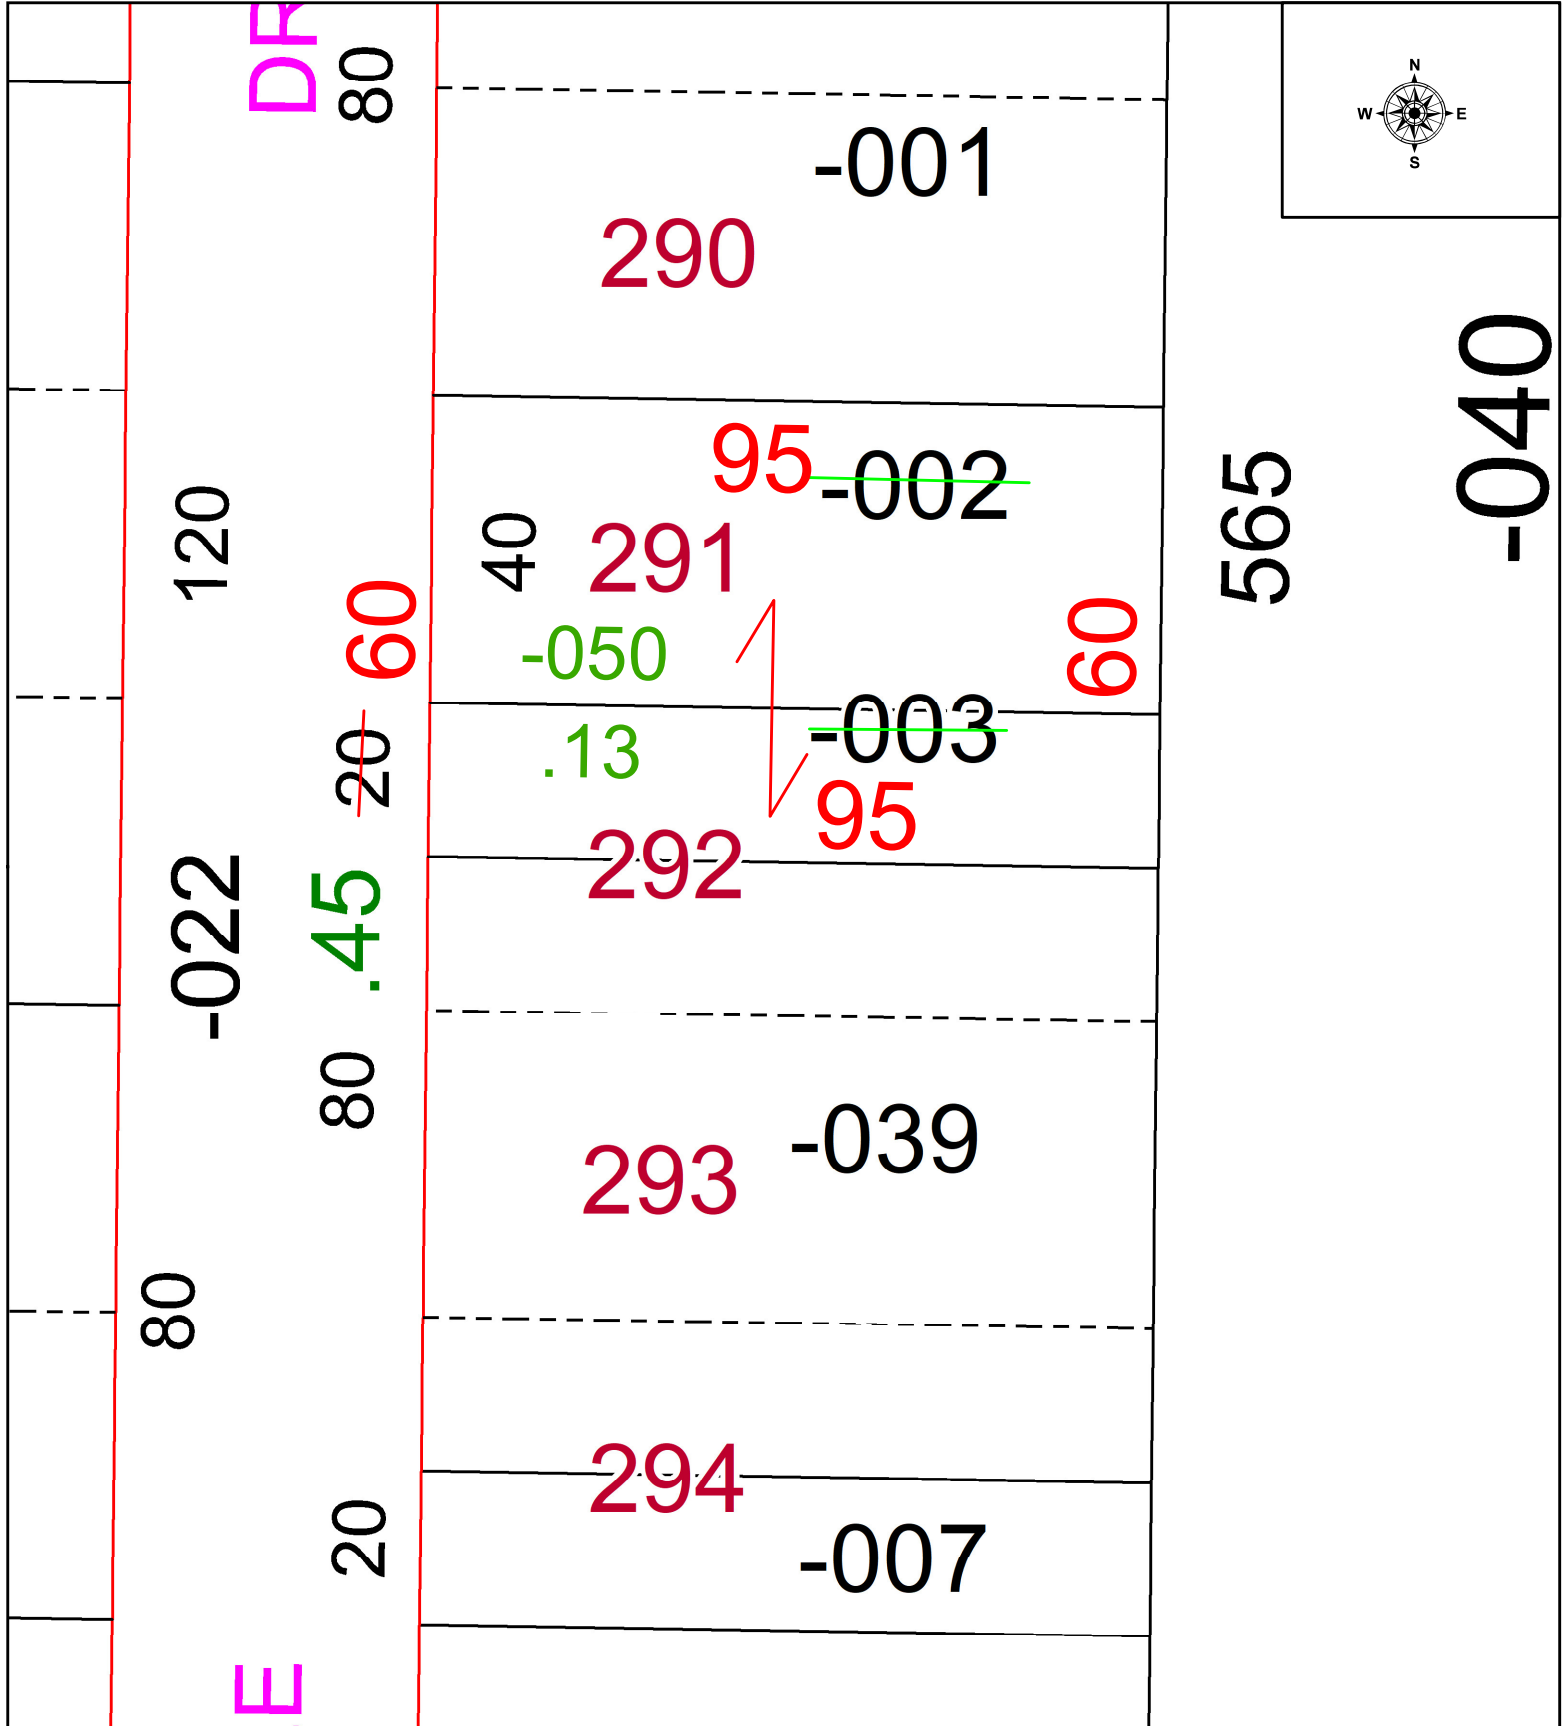


PARENT PARCEL: 04-00-018-130-002 & -003

CHILD PARCEL: 04-00-018-130-050

STARTING POINT: IRON PIPE @ WEST LINE OF BEACHDALE DR & NORTH LINE OF LAKE RD

24-04844

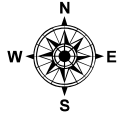

SPLITS/DEEDS PROCESSED
 LORAIN COUNTY TAX MAP DEPARTMENT
 226 MIDDLE AVE. ELYRIA, OH

SURVEYED BY: JAMES SAYLER SURVEY # 51158
 CLOSURE: 1: INF
 MAP PAGE(S): 04-00-018
 APPROVED BY: WRZ DATE: 4/11/2024
 SCALE: 1" = 25 PRIOR INSTRUMENT: #2017-0636373