


PARENT PARCEL: 12-00-096-000-051

CHILD PARCEL: **AC. CORR. PER PRIOR DEED VOL. 206 PG. 776**

STARTING POINT: CL OF S.R. 82 & HAWKE RD.

22-04845-A

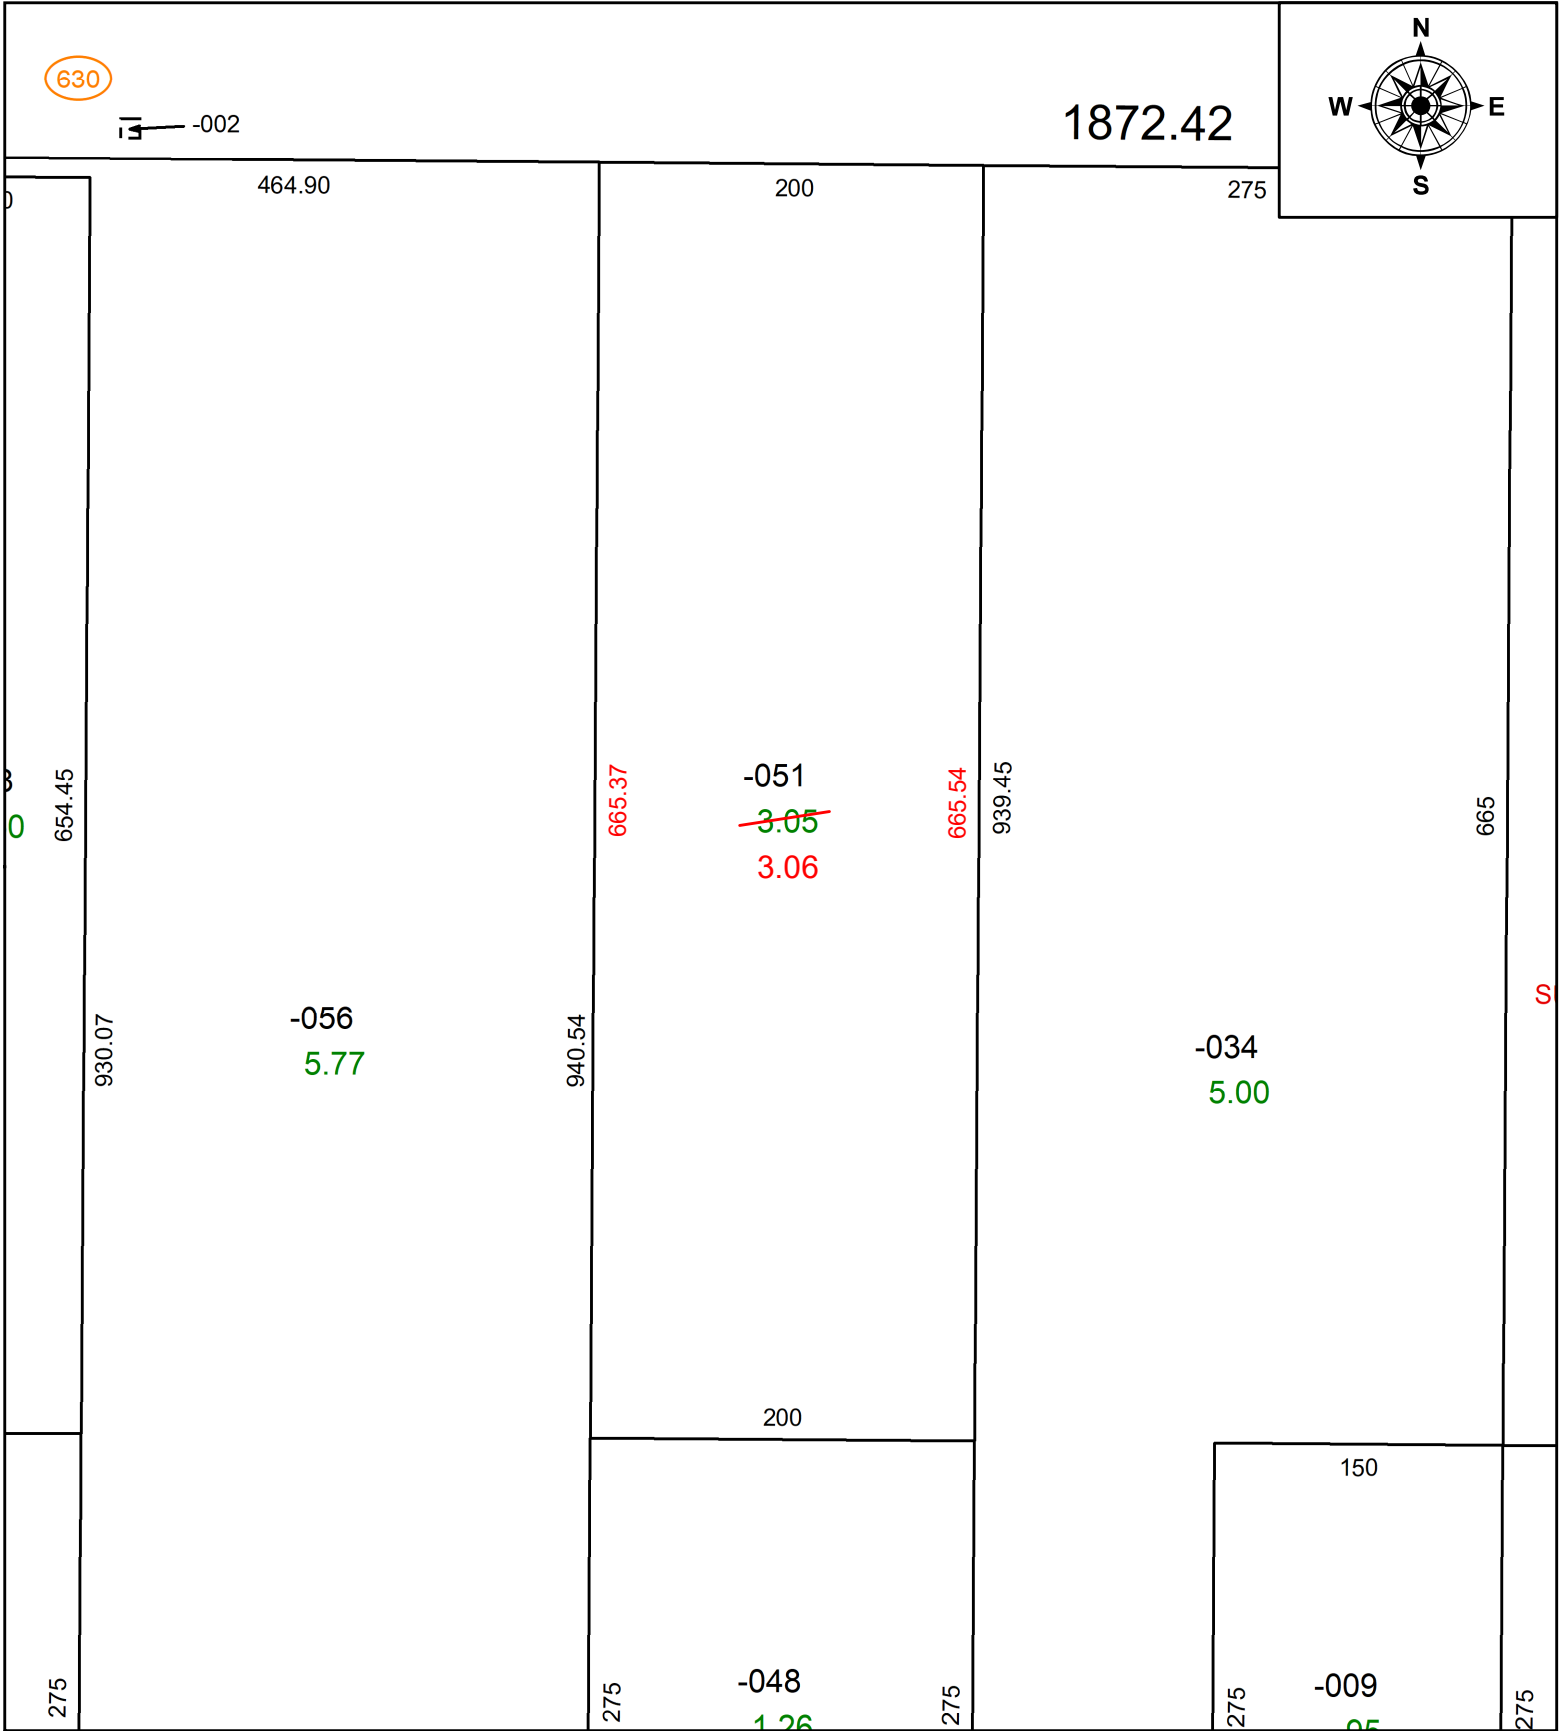

SPLITS/DEEDS PROCESSED
 LORAIN COUNTY TAX MAP DEPARTMENT
 226 MIDDLE AVE. ELYRIA, OH

SURVEYED BY: _____ N/A
 CLOSURE: _____ N/A
 MAP PAGE(S): _____ 12-00-096
 APPROVED BY: _____ DMA DATE: 4/25/2022
 SCALE: 1" = 100' PRIOR INSTRUMENT: D.V. 206 PG. 776