




PARENT PARCEL: 05-00-064-000-005

CHILD PARCEL: N/A

AC CORR. PER CHARLES WARYU

22-04848-A

STARTING POINT: INTERSECTION OF C/L OF OBERLIN RD & MIDDLE RIDGE RD AT A MONUMENT BOX

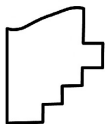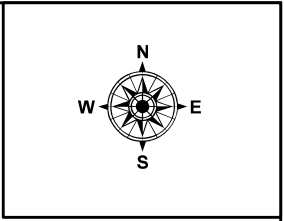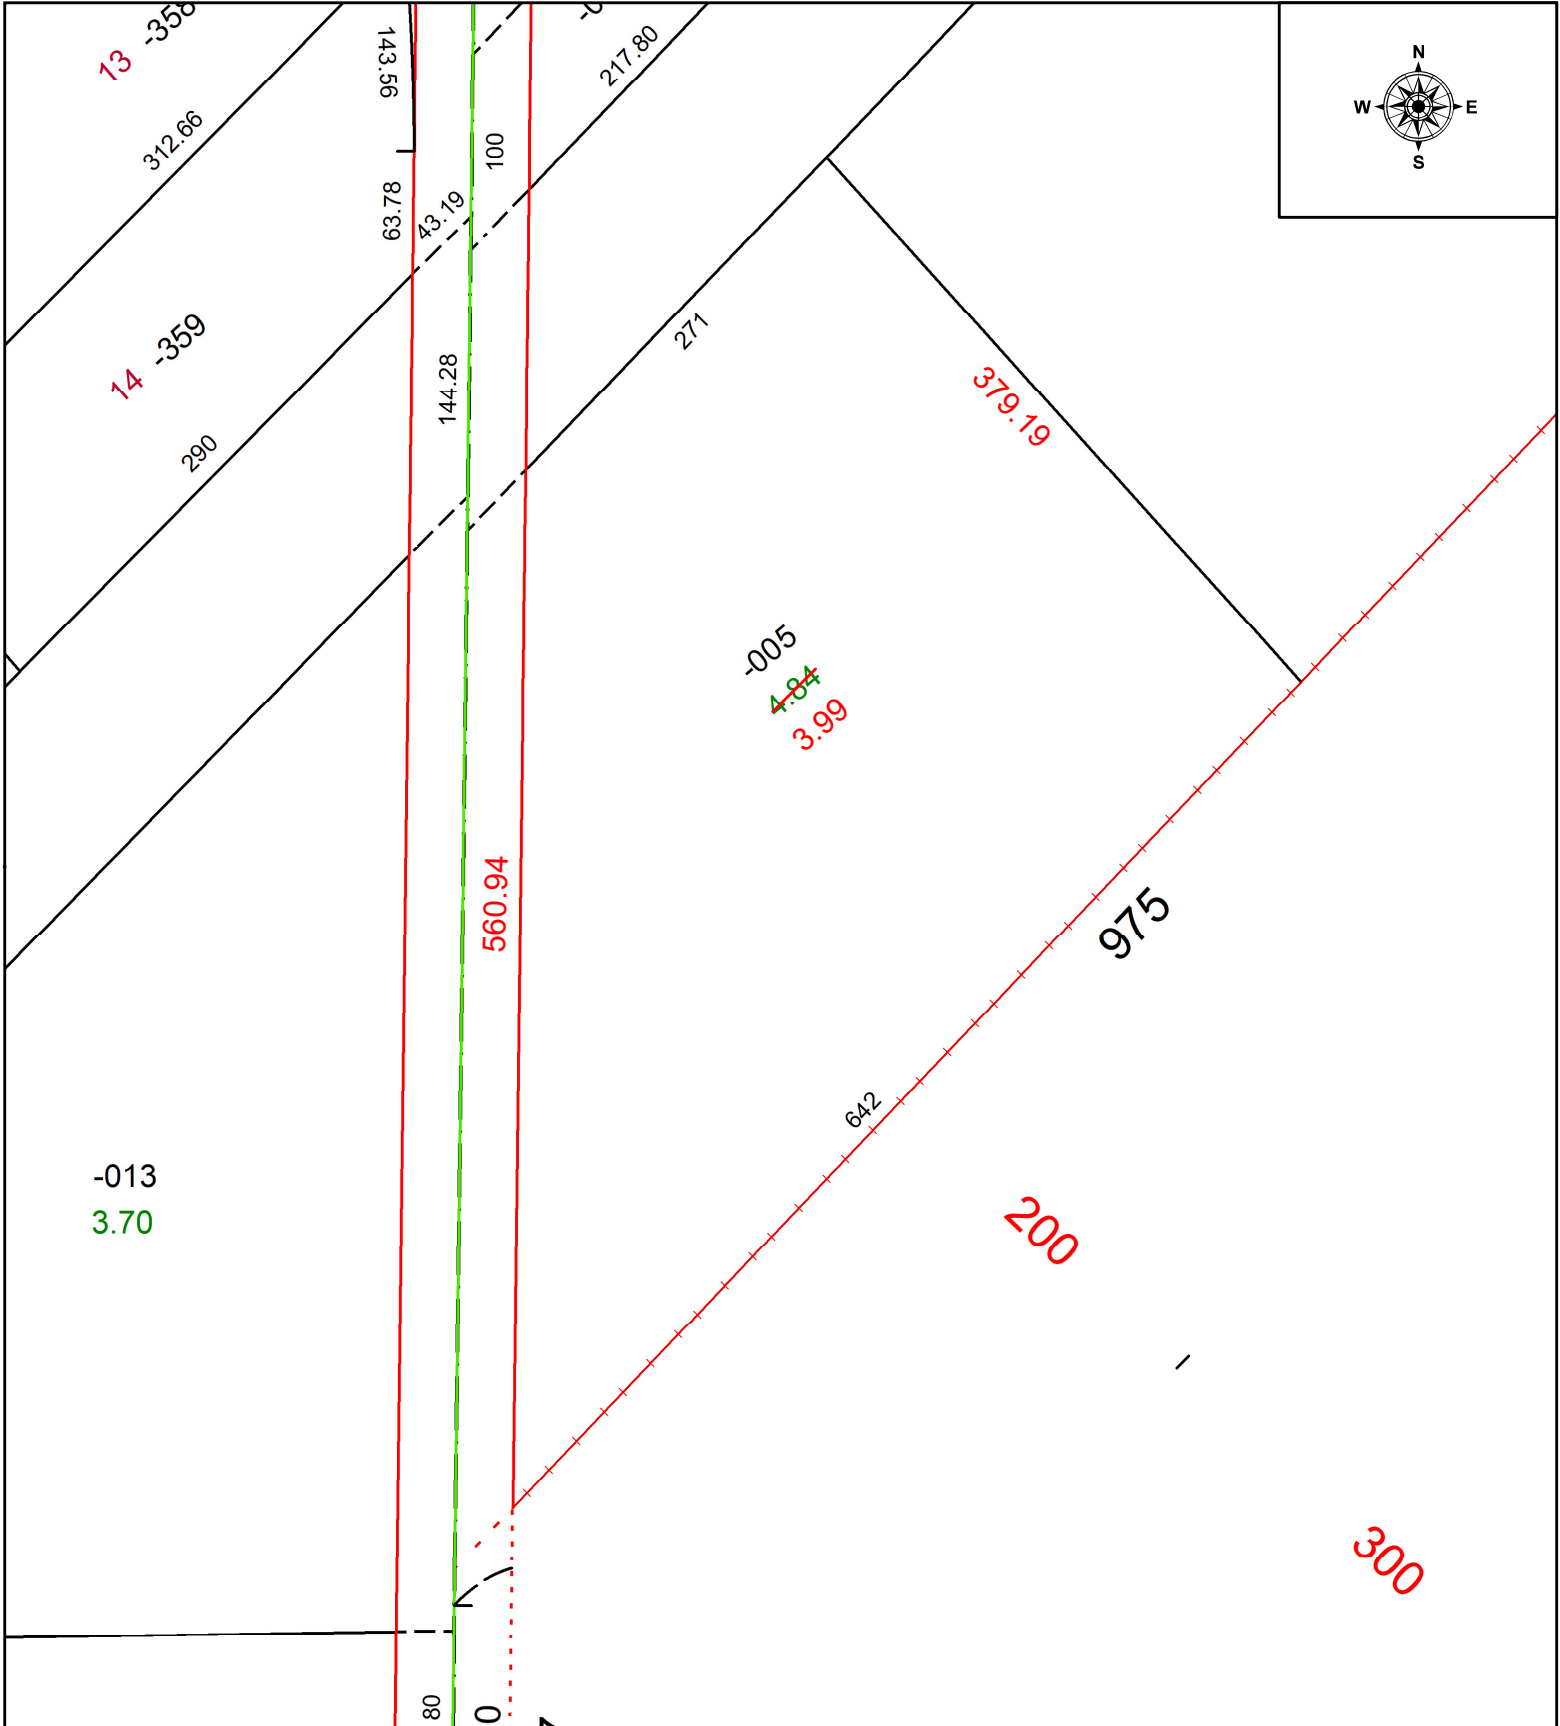

SPLITS/DEEDS PROCESSED
 LORAIN COUNTY TAX MAP DEPARTMENT
 226 MIDDLE AVE. ELYRIA, OH

SURVEYED BY: CHARLES WARYU

CLOSURE: 1: 288430

MAP PAGE(S): 05-00-064

APPROVED BY: WRZ DATE: 4/26/2022

SCALE: 1" = 100

PRIOR INSTRUMENT: DV 1264, PG. 70