
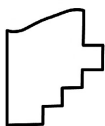
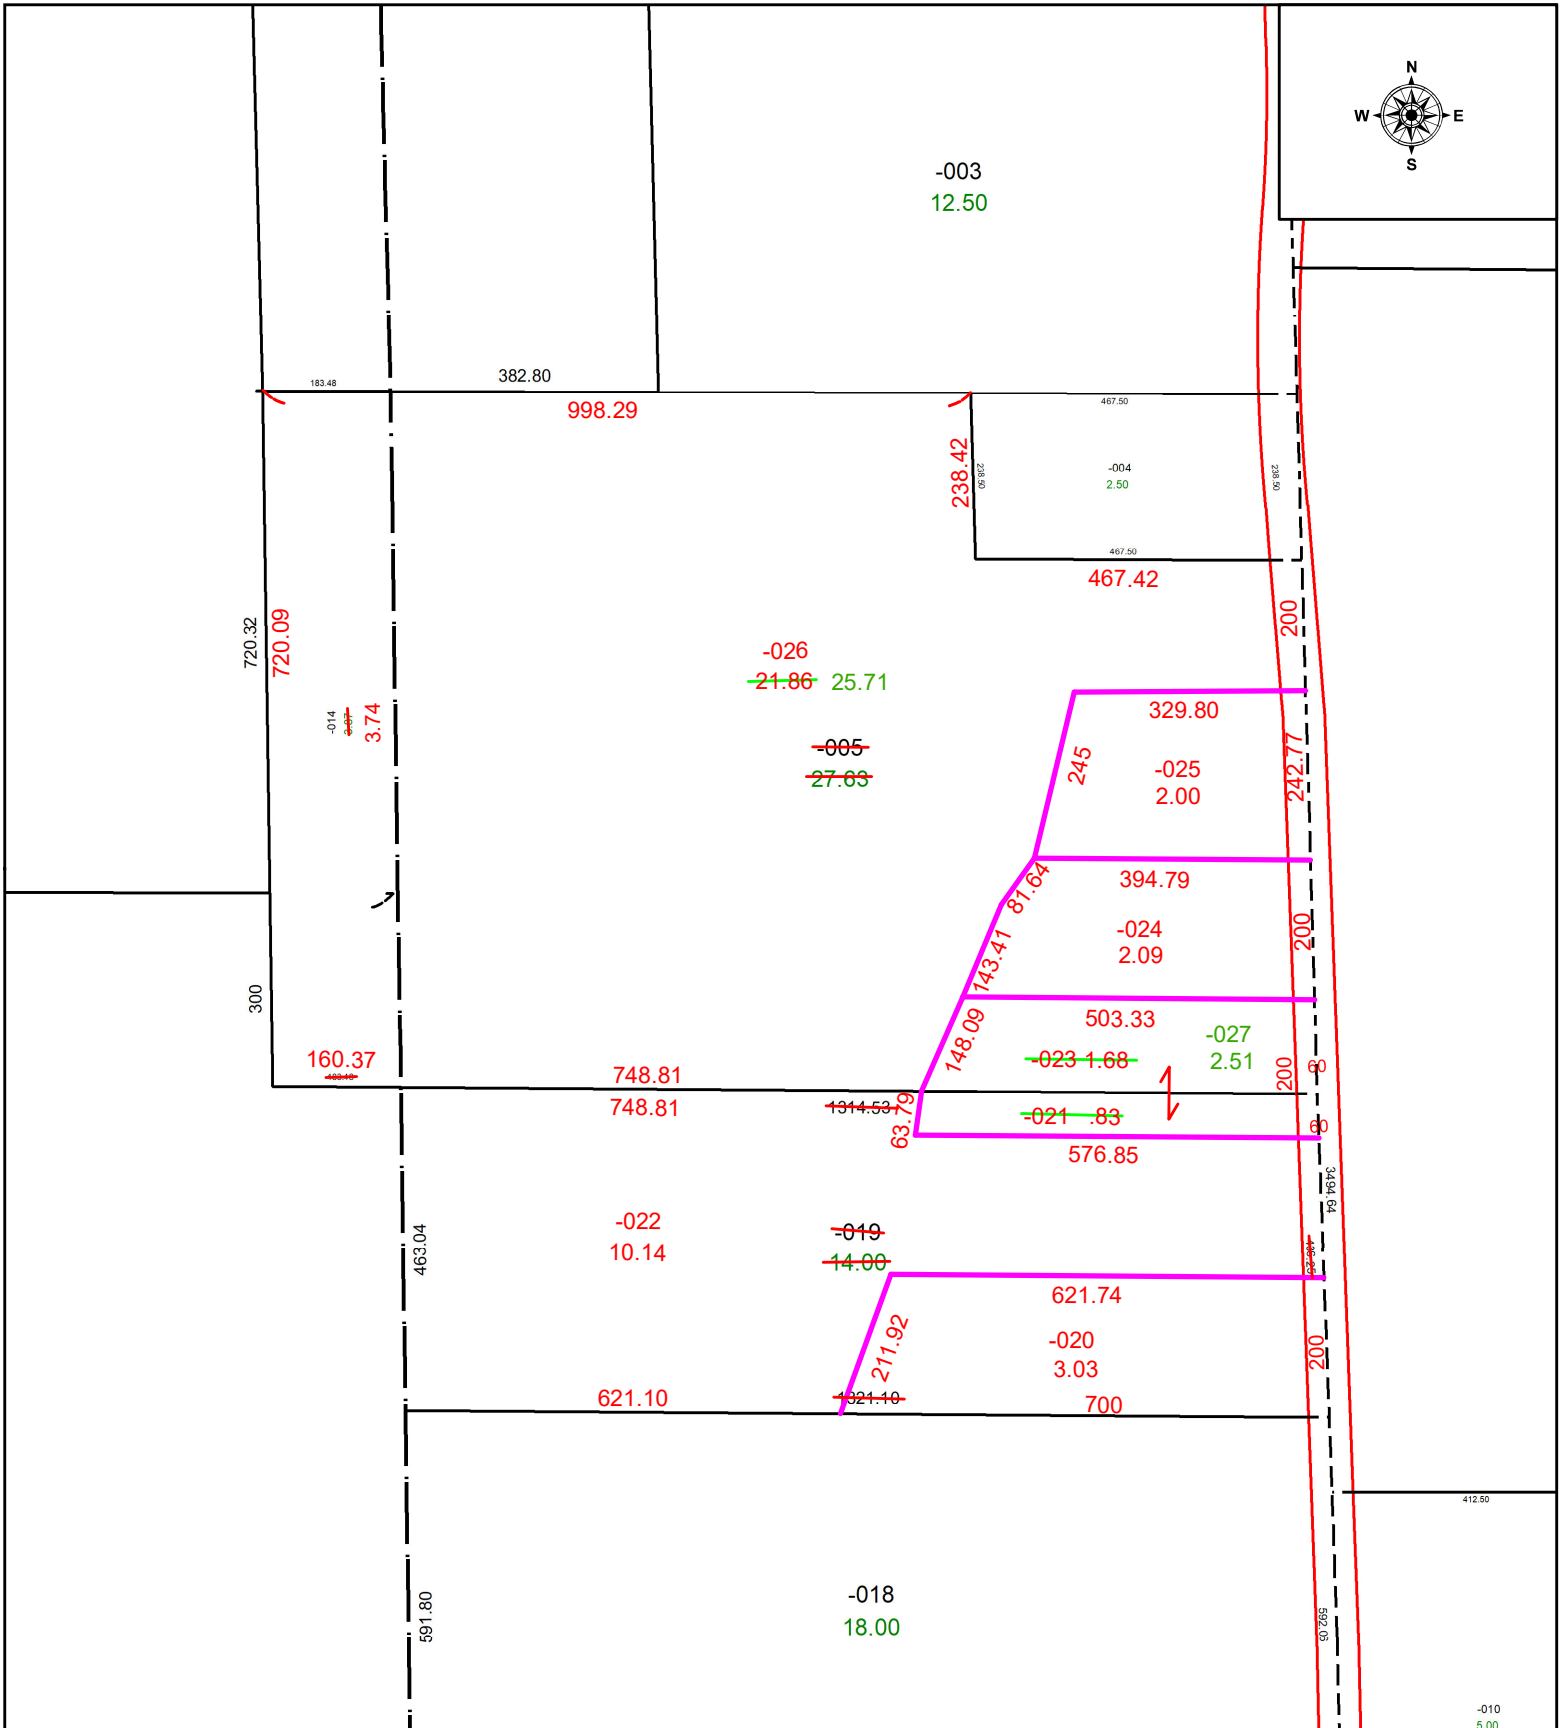


PARENT PARCEL: 08-00-102-000-005, -019, & 08-00-101-000-014 (S.T.)

CHILD PARCEL: 08-00-102-000-020 THRU -027 & 08-00-101-000-014 (S.T.)

STARTING POINT: IRON PIPE @ NORTHEASTERLY CORNER OF Q.L. 3 TRACT 15 & C/L OF GIFFORD RD. AC CORR PER SURVEYOR JOHN DECHANT JR.

24-04848

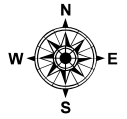

**SPLITS/DEEDS PROCESSED**  
LORAIN COUNTY TAX MAP DEPARTMENT  
226 MIDDLE AVE. ELYRIA, OH

SURVEYED BY: JOHN DECHANT JR. SURVEY # 51173  
CLOSURE: 1: 536462  
MAP PAGE(S): 08-00-102  
APPROVED BY: WRZ DATE: 4/26/2024  
SCALE: 1" = 275 PRIOR INSTRUMENT: #2023-0938328