


PARENT PARCEL: 04-00-010-115-021

CHILD PARCEL: **AC CORR PER SURVEY BY SEAN A. BOLAND**

22-04850-C

STARTING POINT: C/L OF DETROIT RD AND STONEY RIDGE

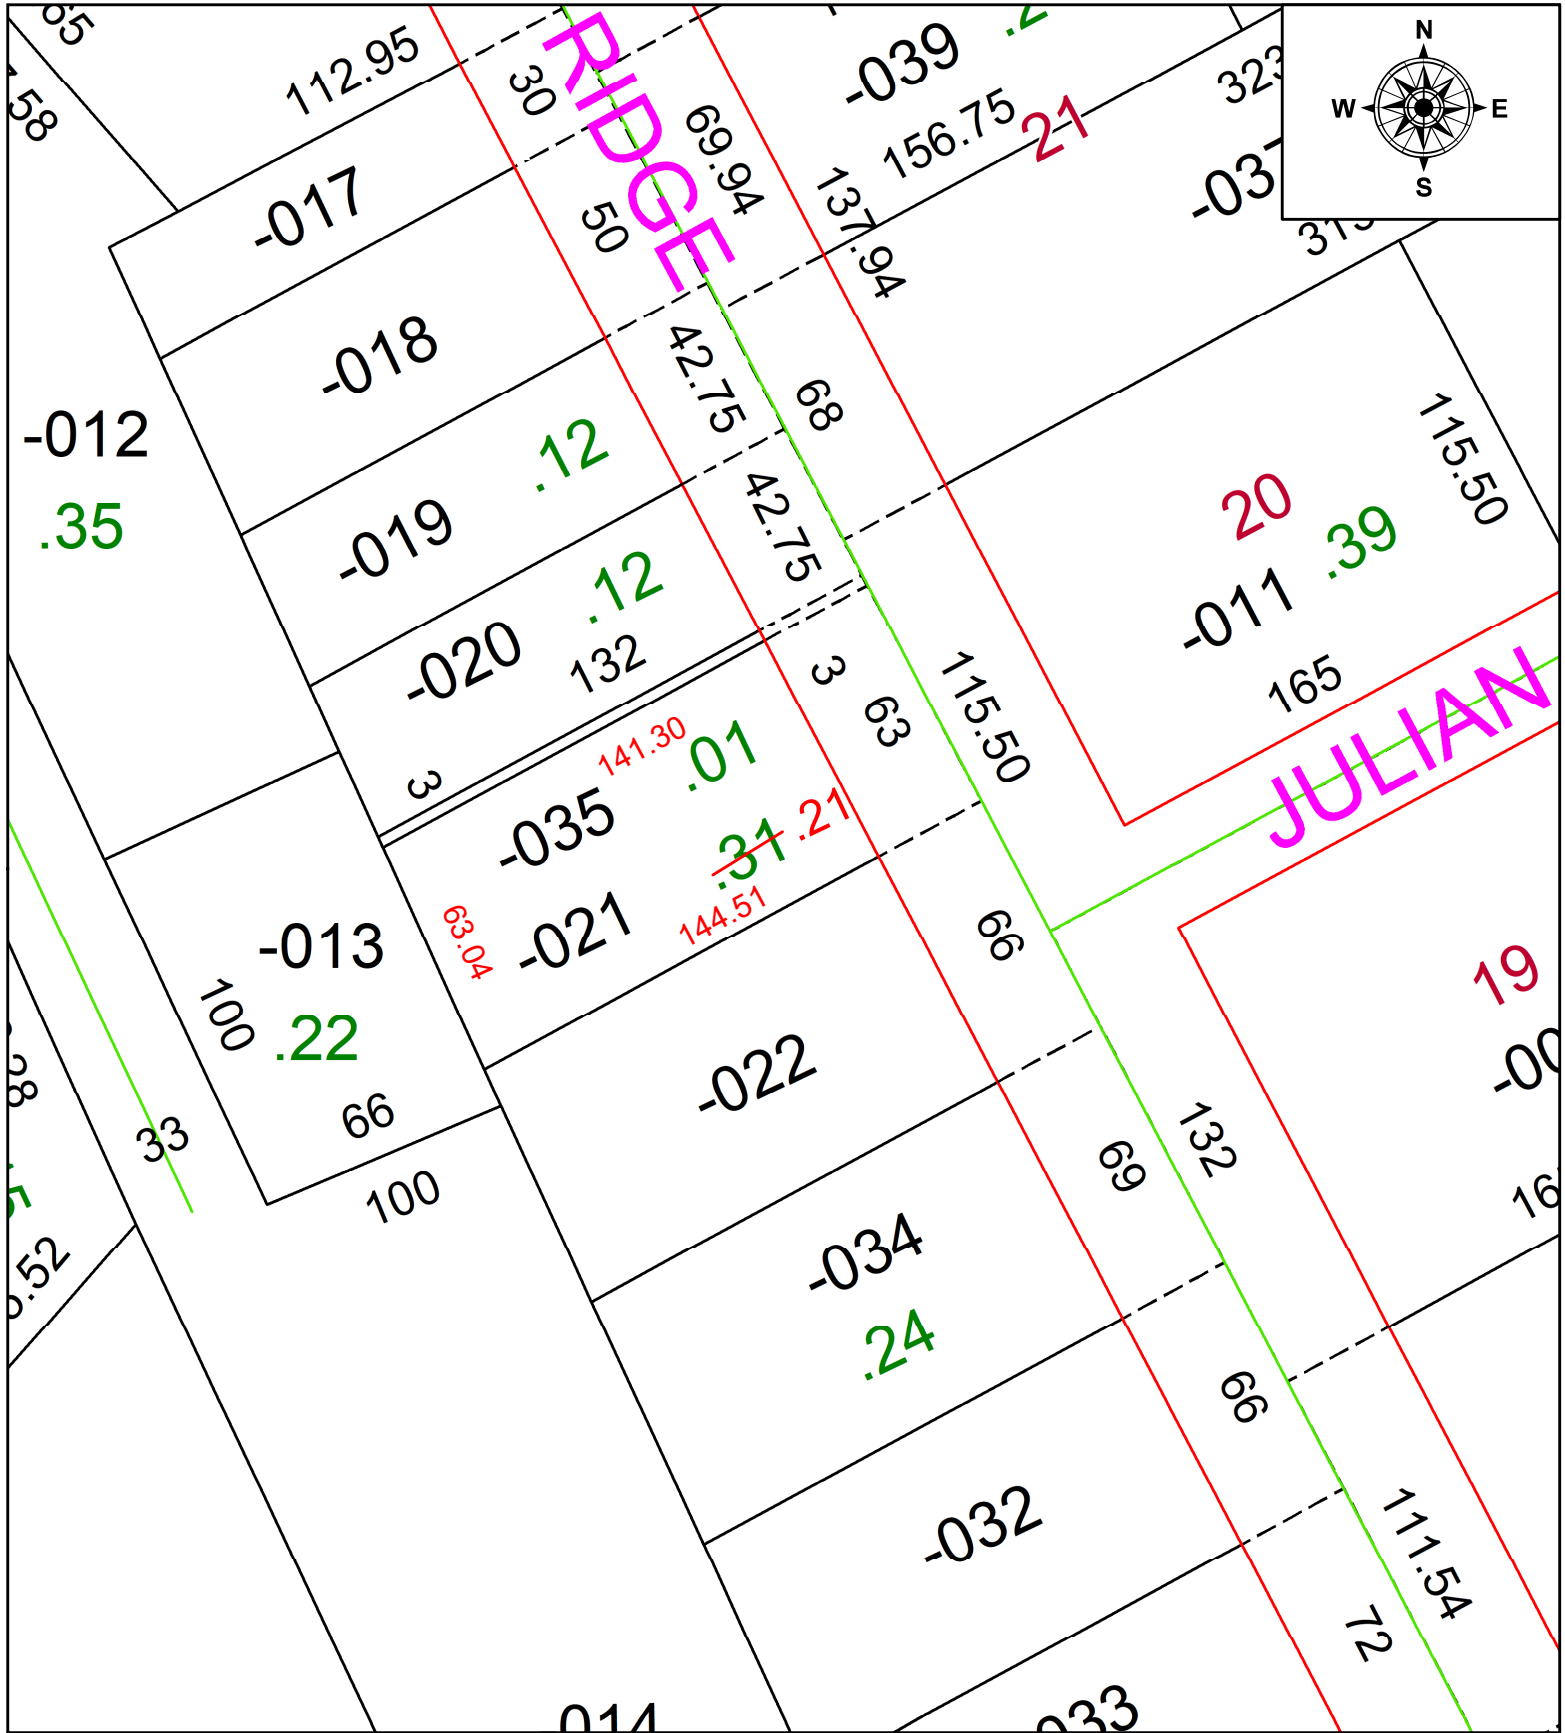

SPLITS/DEEDS PROCESSED
 LORAIN COUNTY TAX MAP DEPARTMENT
 226 MIDDLE AVE. ELYRIA, OH

SURVEYED BY:	SEAN A. BOLAND
CLOSURE:	1: 103807
MAP PAGE(S):	04-00-010-G
APPROVED BY:	AC DATE: 4/29/2022
SCALE:	1" = 50 PRIOR INSTRUMENT: 2022- 0865777