
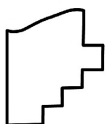


PARENT PARCEL: 09-00-021-000-035

CHILD PARCEL: 09-00-021-000-048 & -049

STARTING POINT: MONUMENT BOX @ NORTHEASTERLY CORNER OF O.L. 21 & C/LS OF RUSSIA RD & QUARRY RD

24-04854

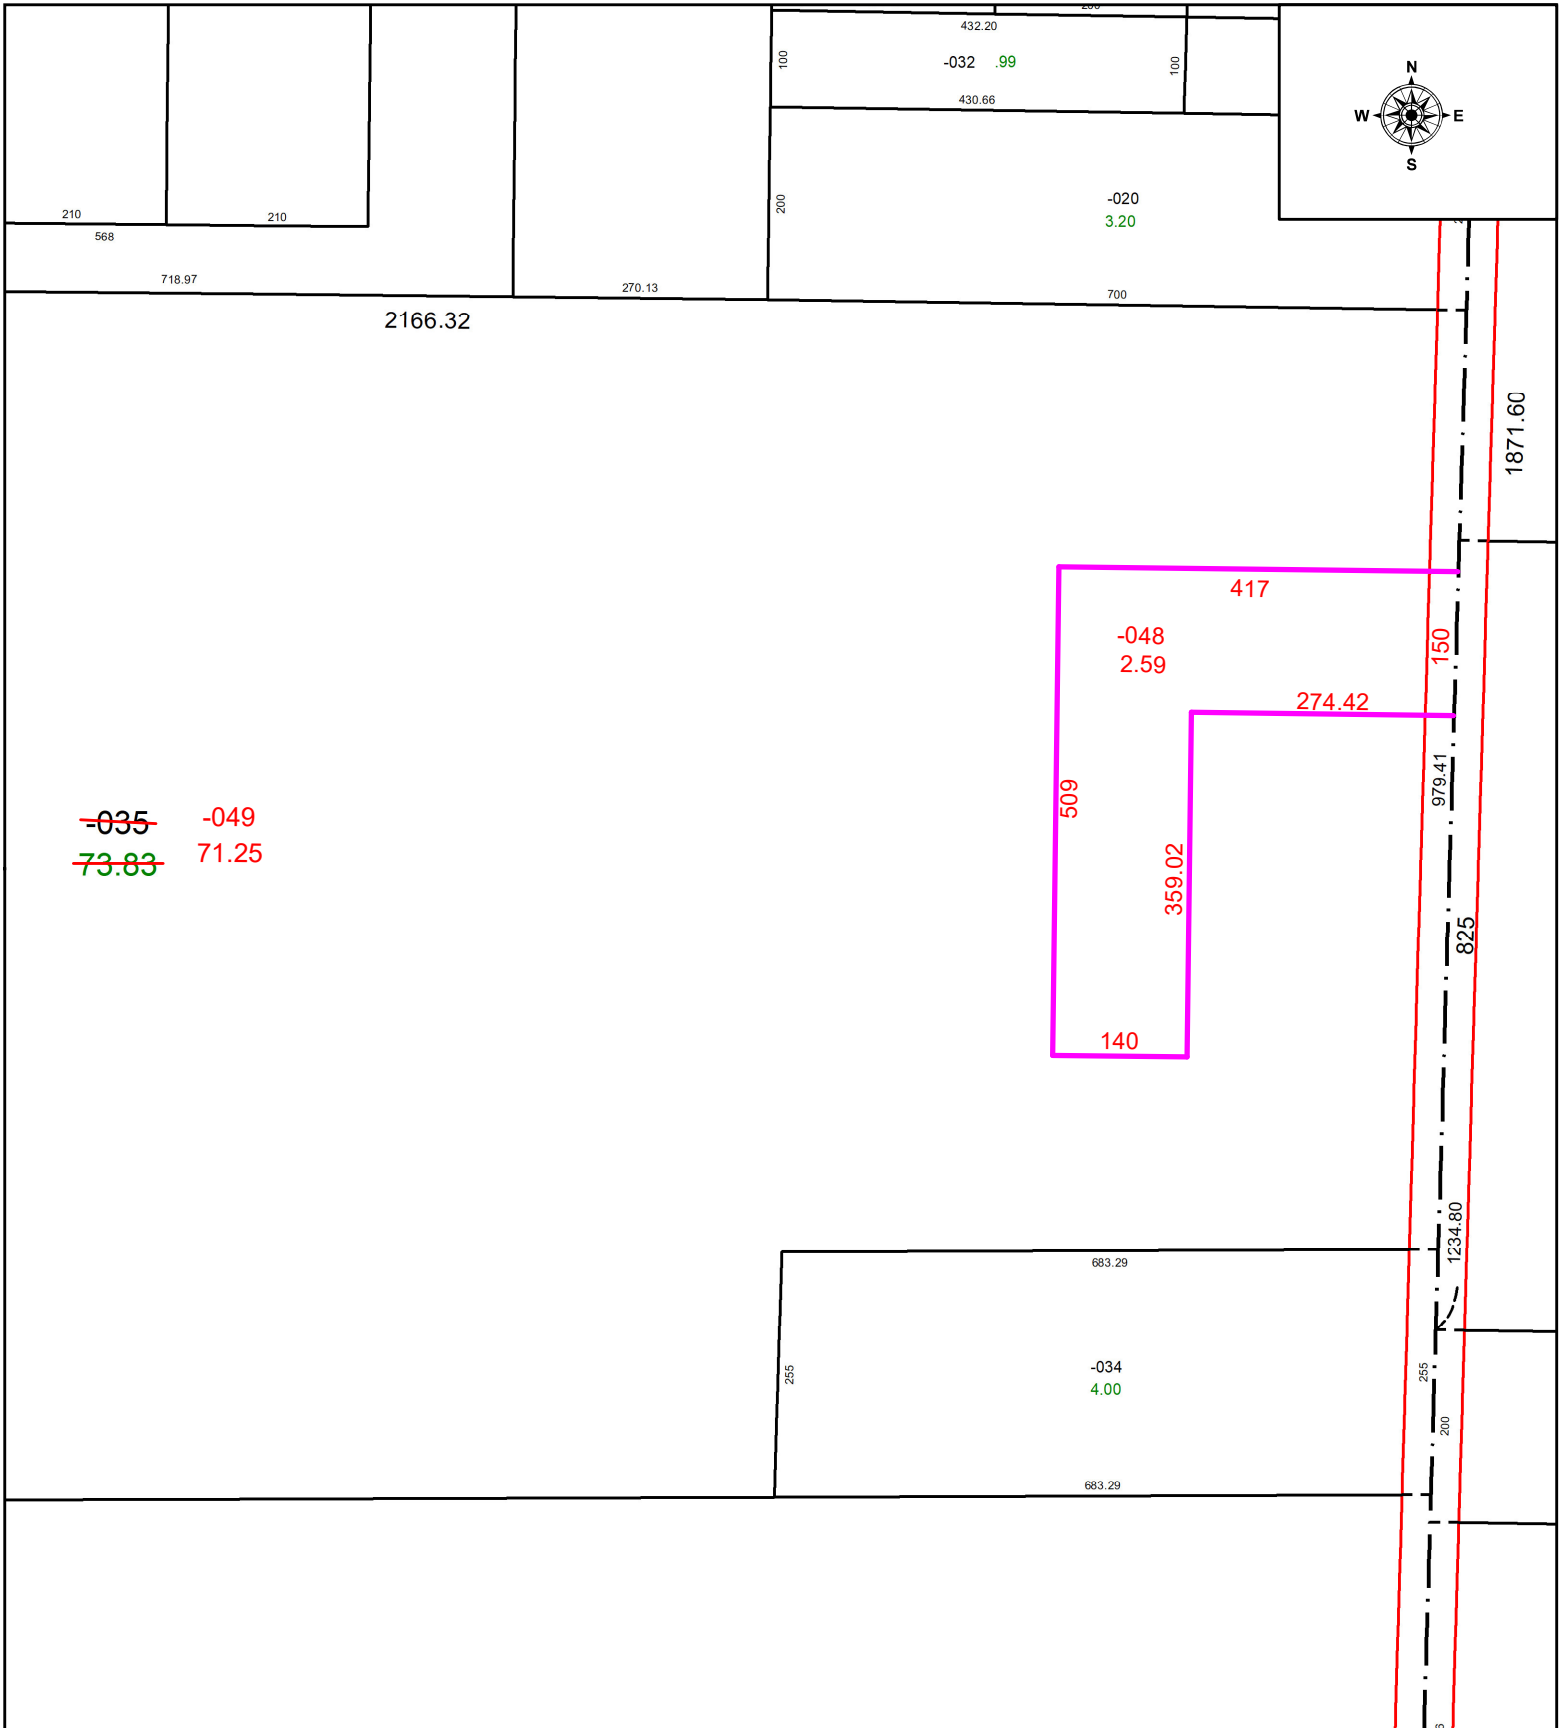

**SPLITS/DEEDS PROCESSED**  
 LORAIN COUNTY TAX MAP DEPARTMENT  
 226 MIDDLE AVE. ELYRIA, OH

SURVEYED BY: LOUIS GIFFELS SURVEY # 51179  
 CLOSURE: 1: 372768  
 MAP PAGE(S): 09-00-021  
 APPROVED BY: WRZ DATE: 5/9/2024  
 SCALE: 1" = 200 PRIOR INSTRUMENT: #2023-0907183