


PARENT PARCEL: 10-00-002-000-042


CHILD PARCEL: **AC. CORR. PER SURVEY DALE HAYWOOD**

STARTING POINT: CL OF MURRAY RIDGE RD. & INFIRMARY RD.

22-04856-A

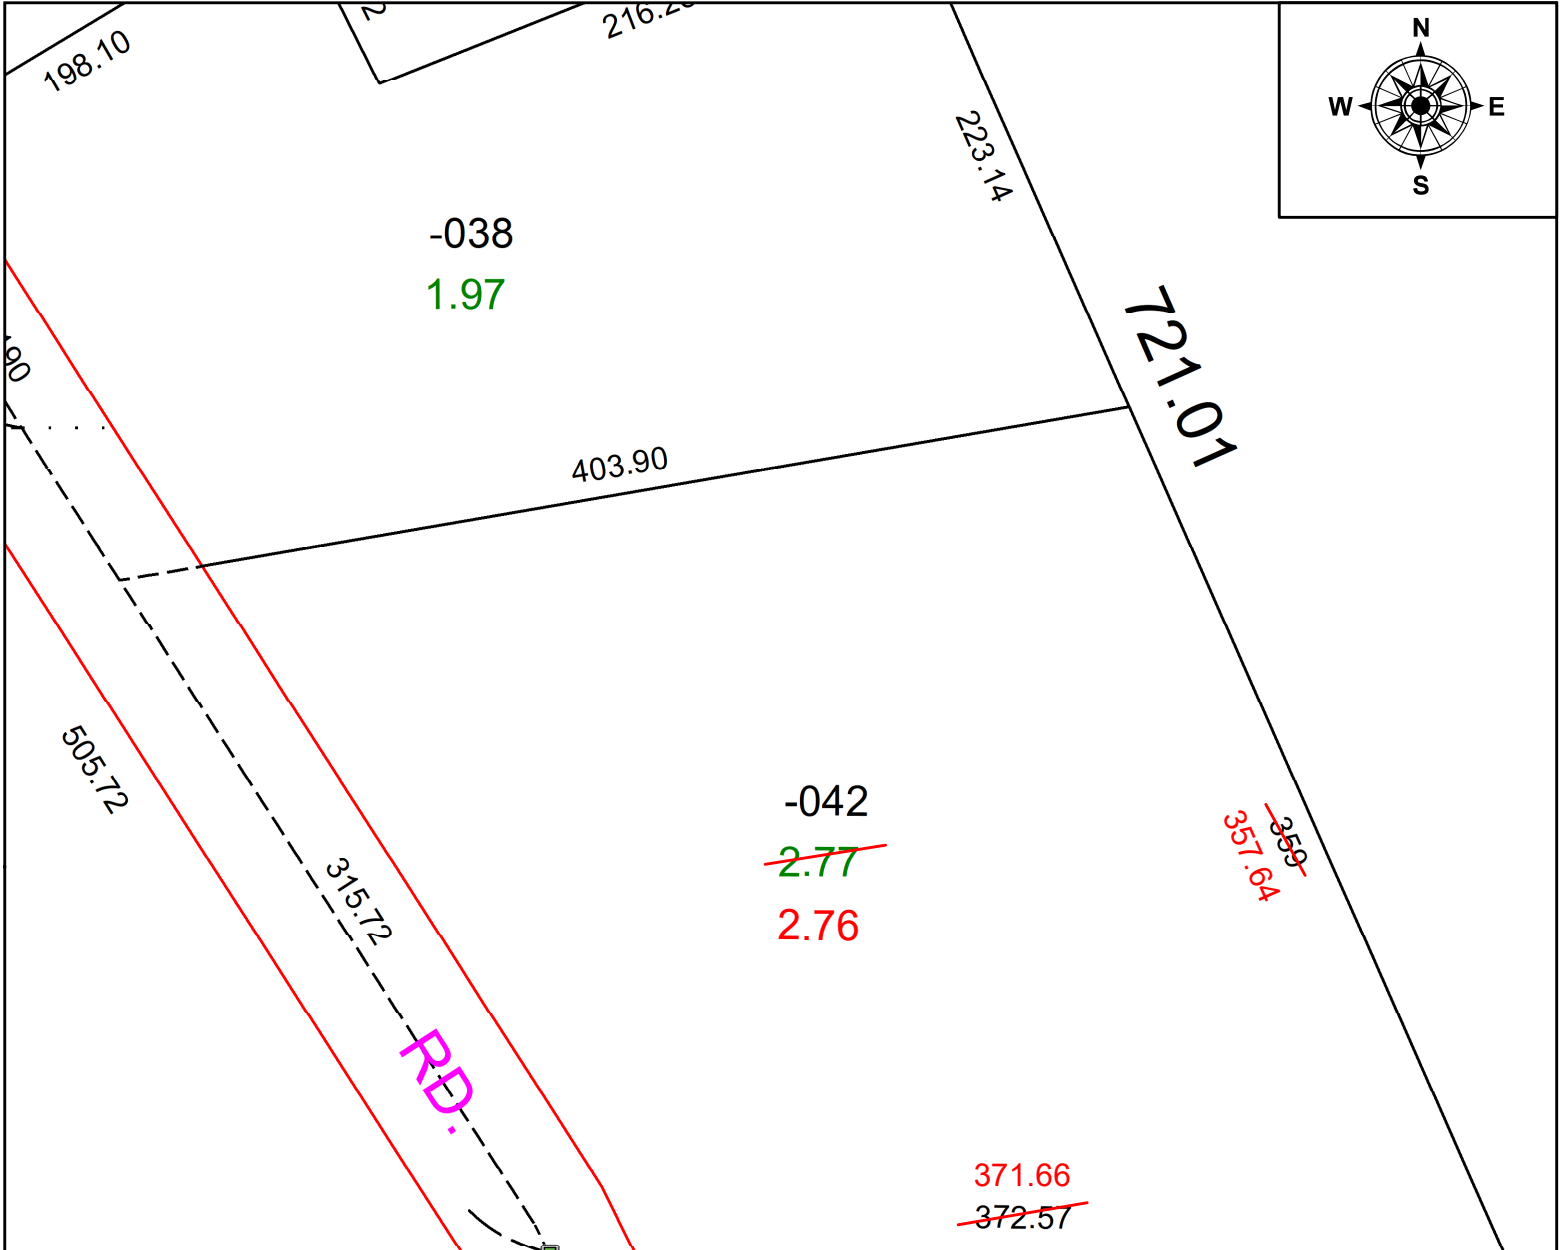

60 Murray Ridge Rd. Elyria

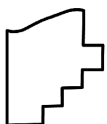

**SPLITS/DEEDS PROCESSED**  
LORAIN COUNTY TAX MAP DEPARTMENT  
226 MIDDLE AVE. ELYRIA, OH

SURVEYED BY:	DALE HAYWOOD
CLOSURE:	1: 89788
MAP PAGE(S):	10-00-002
APPROVED BY:	DMA
DATE:	5/6/2022
SCALE:	1" = 75'
PRIOR INSTRUMENT:	2014-0510409