


PARENT PARCEL: 18-00-030-000-020

CHILD PARCEL: **AC. CORR. PER SURVEY J.W. WARDEN**

STARTING POINT: S.E. CORNER OF O.L. 30

22-04860-A

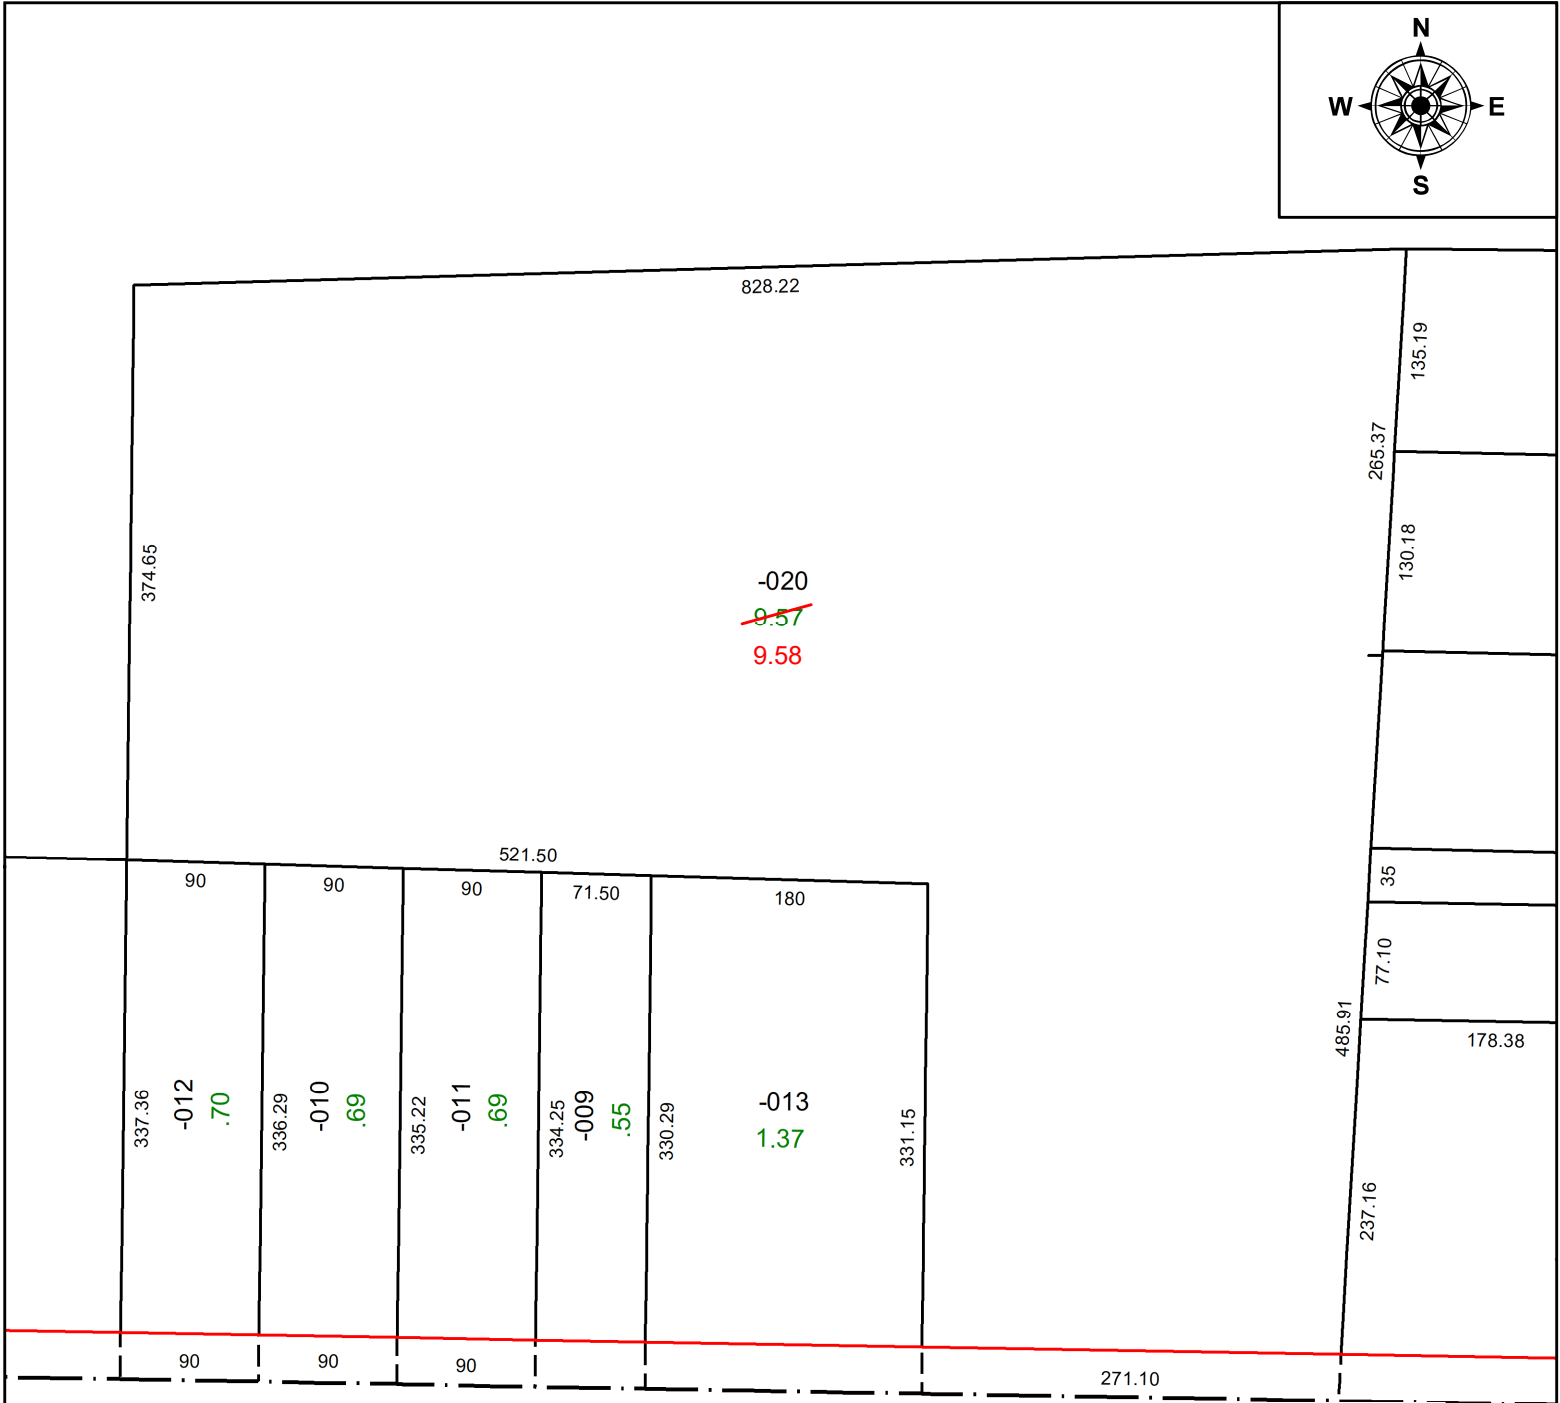

**SPLITS/DEEDS PROCESSED**  
 LORAIN COUNTY TAX MAP DEPARTMENT  
 226 MIDDLE AVE. ELYRIA, OH

**SURVEYED BY:** J.W. WARDEN  
**CLOSURE:** 1: 21987  
**MAP PAGE(S):** 18-00-030  
**APPROVED BY:** DMA **DATE:** 5/9/2022  
**SCALE:** 1" = 125' **PRIOR INSTRUMENT:** N/A