


PARENT PARCEL: 04-00-002-101-093

CHILD PARCEL: **AC CORR PER SURV BY MICHAEL P. SPELLACY**

22-04861-A

STARTING POINT: C/L OF COURSEVIEW DR AND MOON RD

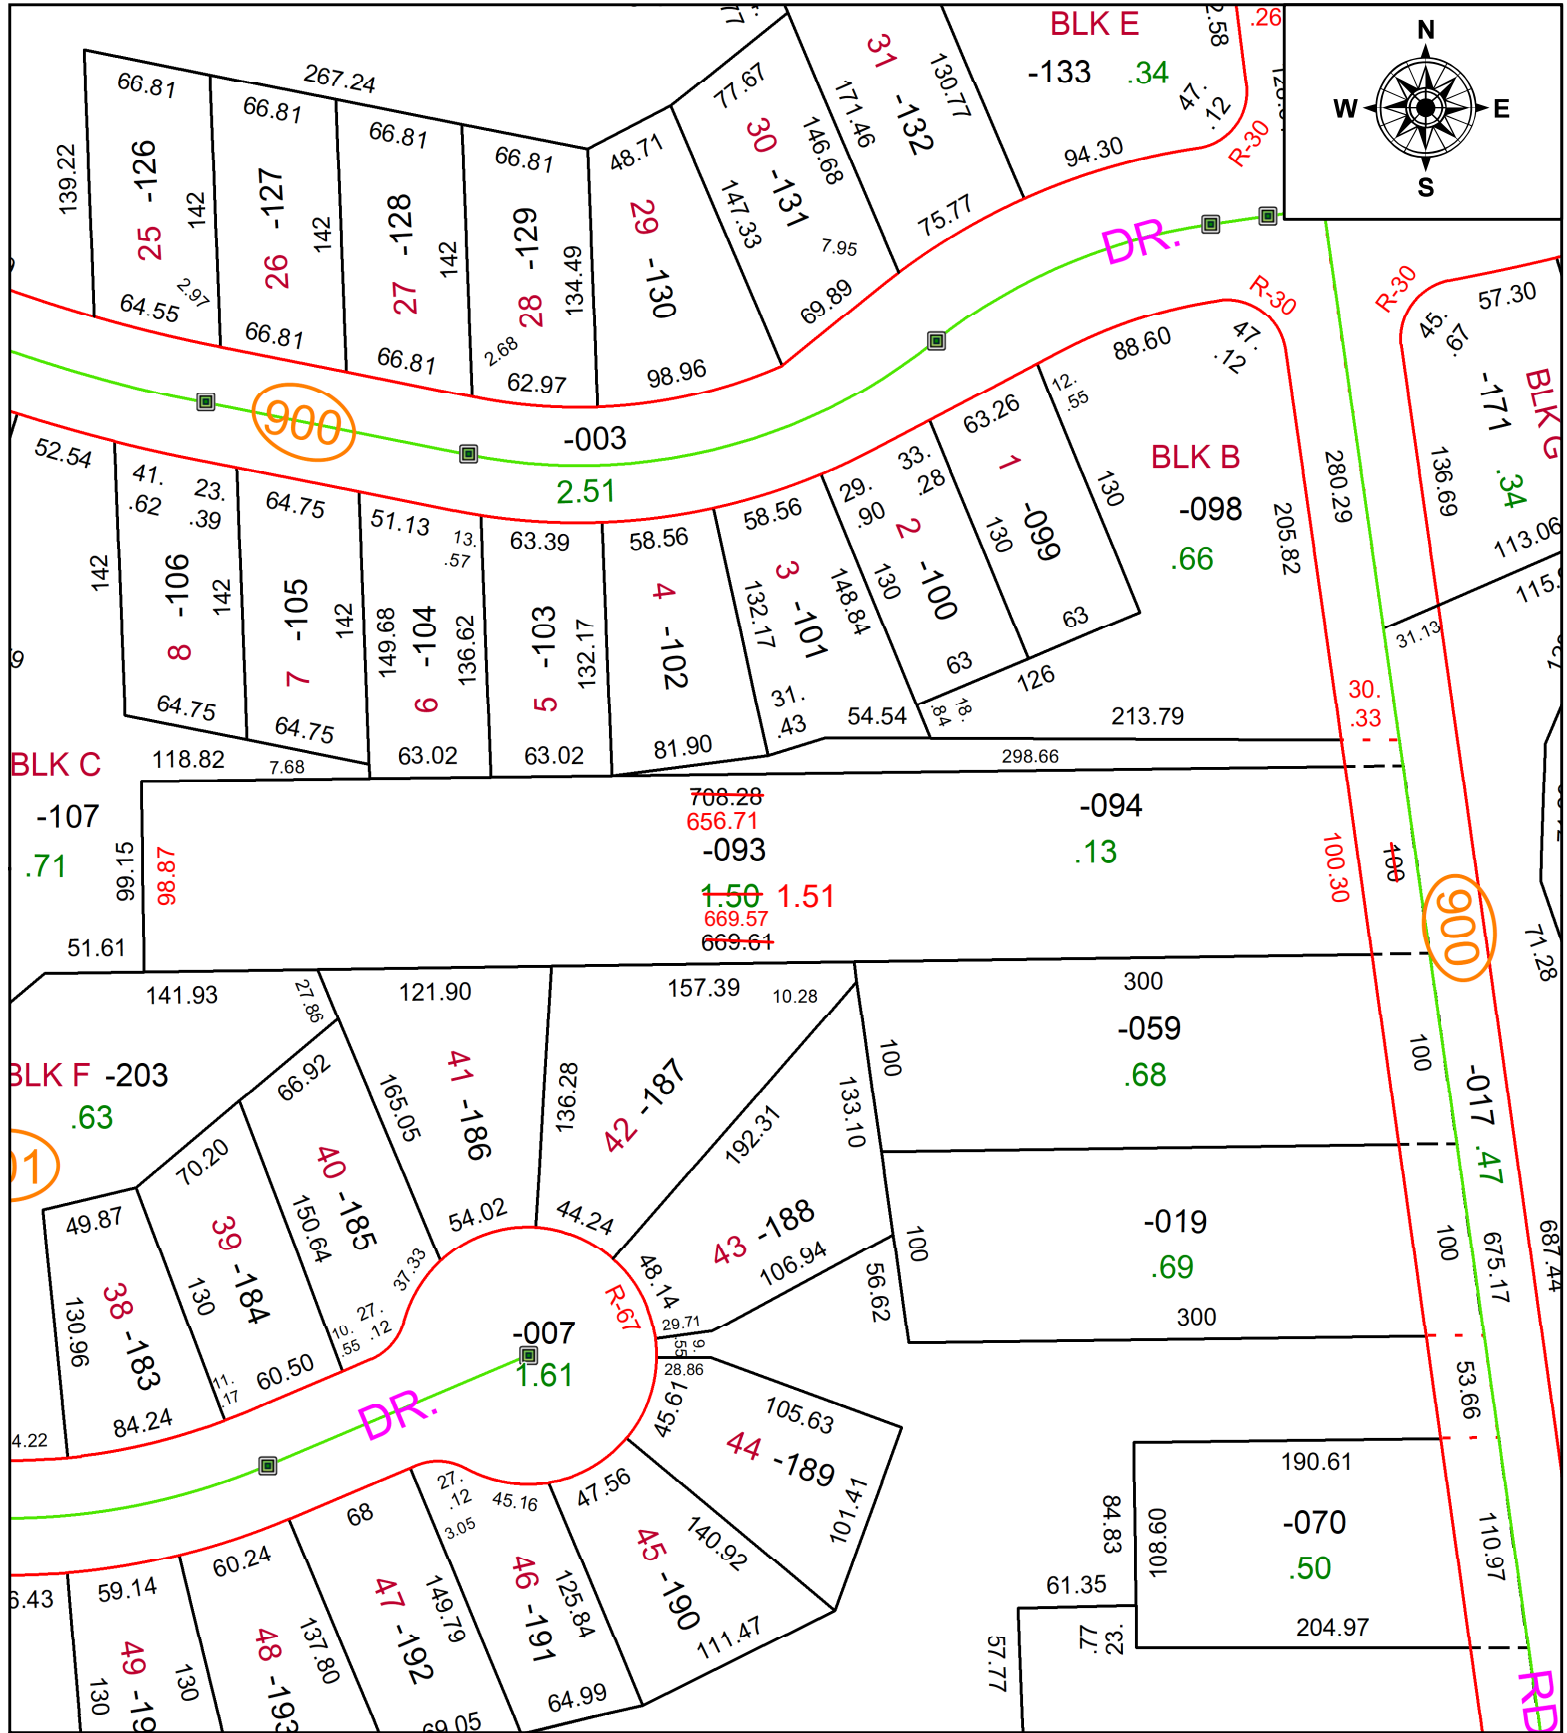

SPLITS/DEEDS PROCESSED
 LORAIN COUNTY TAX MAP DEPARTMENT
 226 MIDDLE AVE. ELYRIA, OH

SURVEYED BY: MICHAEL P. SPELLACY
CLOSURE: 1: 223277
MAP PAGE(S): 04-00-002
APPROVED BY: AC **DATE:** 5/12/2022
SCALE: 1" = 100 **PRIOR INSTRUMENT:** 2008-0274691