

PARENT PARCEL: 11-00-089-000-021 & -022



AC CORR PER SURVEYOR BRIAN SIEBENTHAL

CHILD PARCEL: 11-00-089-000-140

MAP CORRECTION ONLY FOR 11-00-088-000-047

24-04864

STARTING POINT: INTERSECTION OF C/L OF BUTTERNUT RIDGE RD & SOUTH LINE OF O.L. 89

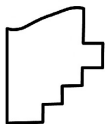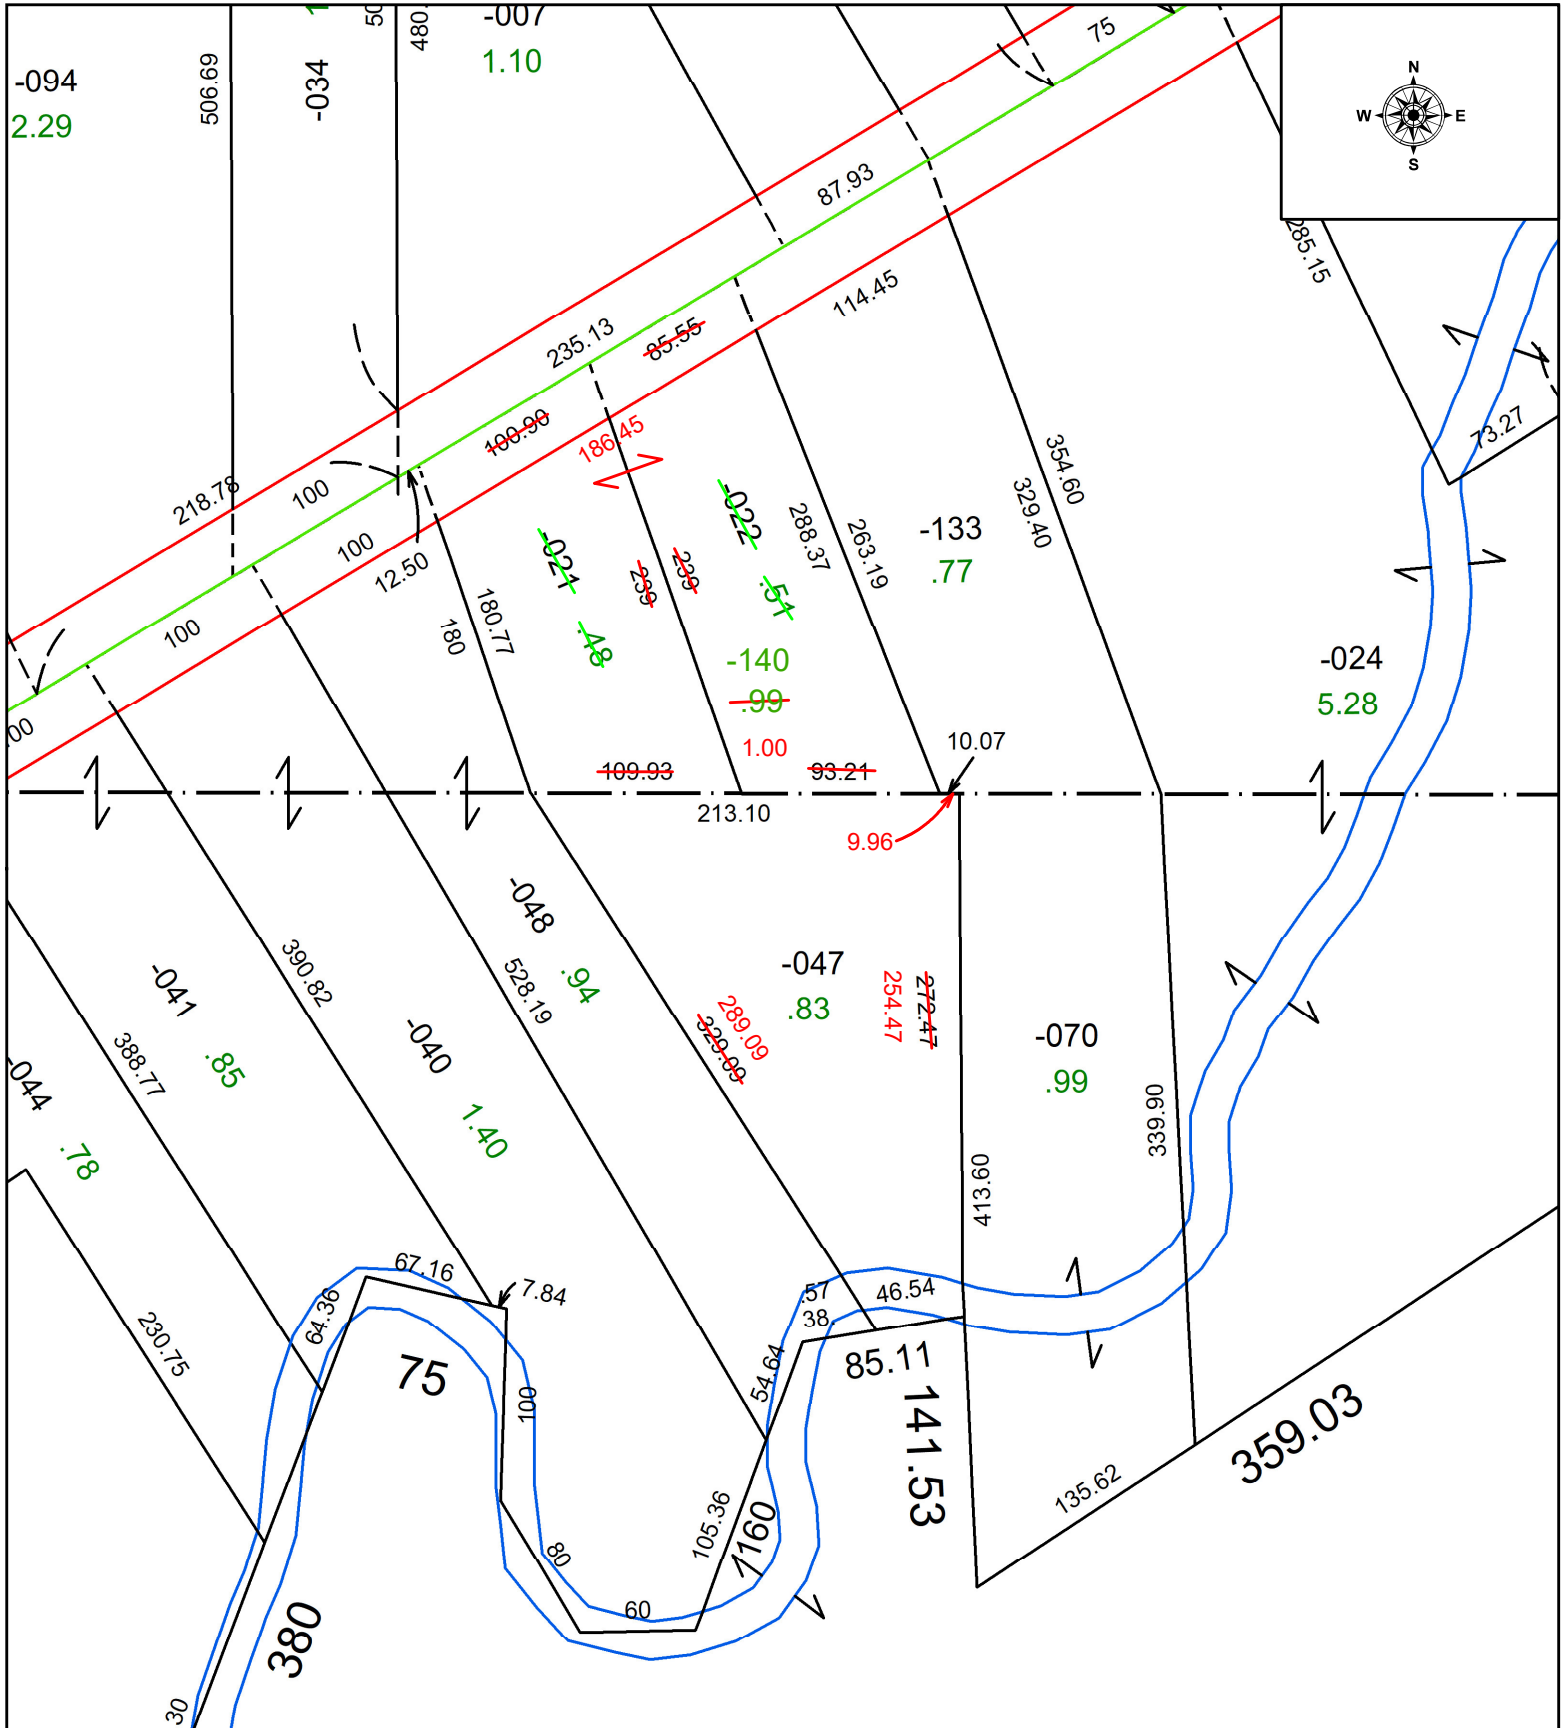

SPLITS/DEEDS PROCESSED
 LORAIN COUNTY TAX MAP DEPARTMENT
 226 MIDDLE AVE. ELYRIA, OH

SURVEYED BY: BRIAN SIEBENTHAL SURVEY # 51204
 CLOSURE: 1: 573149
 MAP PAGE(S): 11-00-088 & 11-00-089
 APPROVED BY: WRZ DATE: 6/12/2024
 SCALE: 1" = 100 PRIOR INSTRUMENT: #2021-0845636