


PARENT PARCEL: 11-00-010-000-019 & -021

CHILD PARCEL: 11-00-010-000-059, -060, & -061

STARTING POINT: INTERSECTION OF C/LS OF SPRAGUE RD & ROOT RD

24-04866

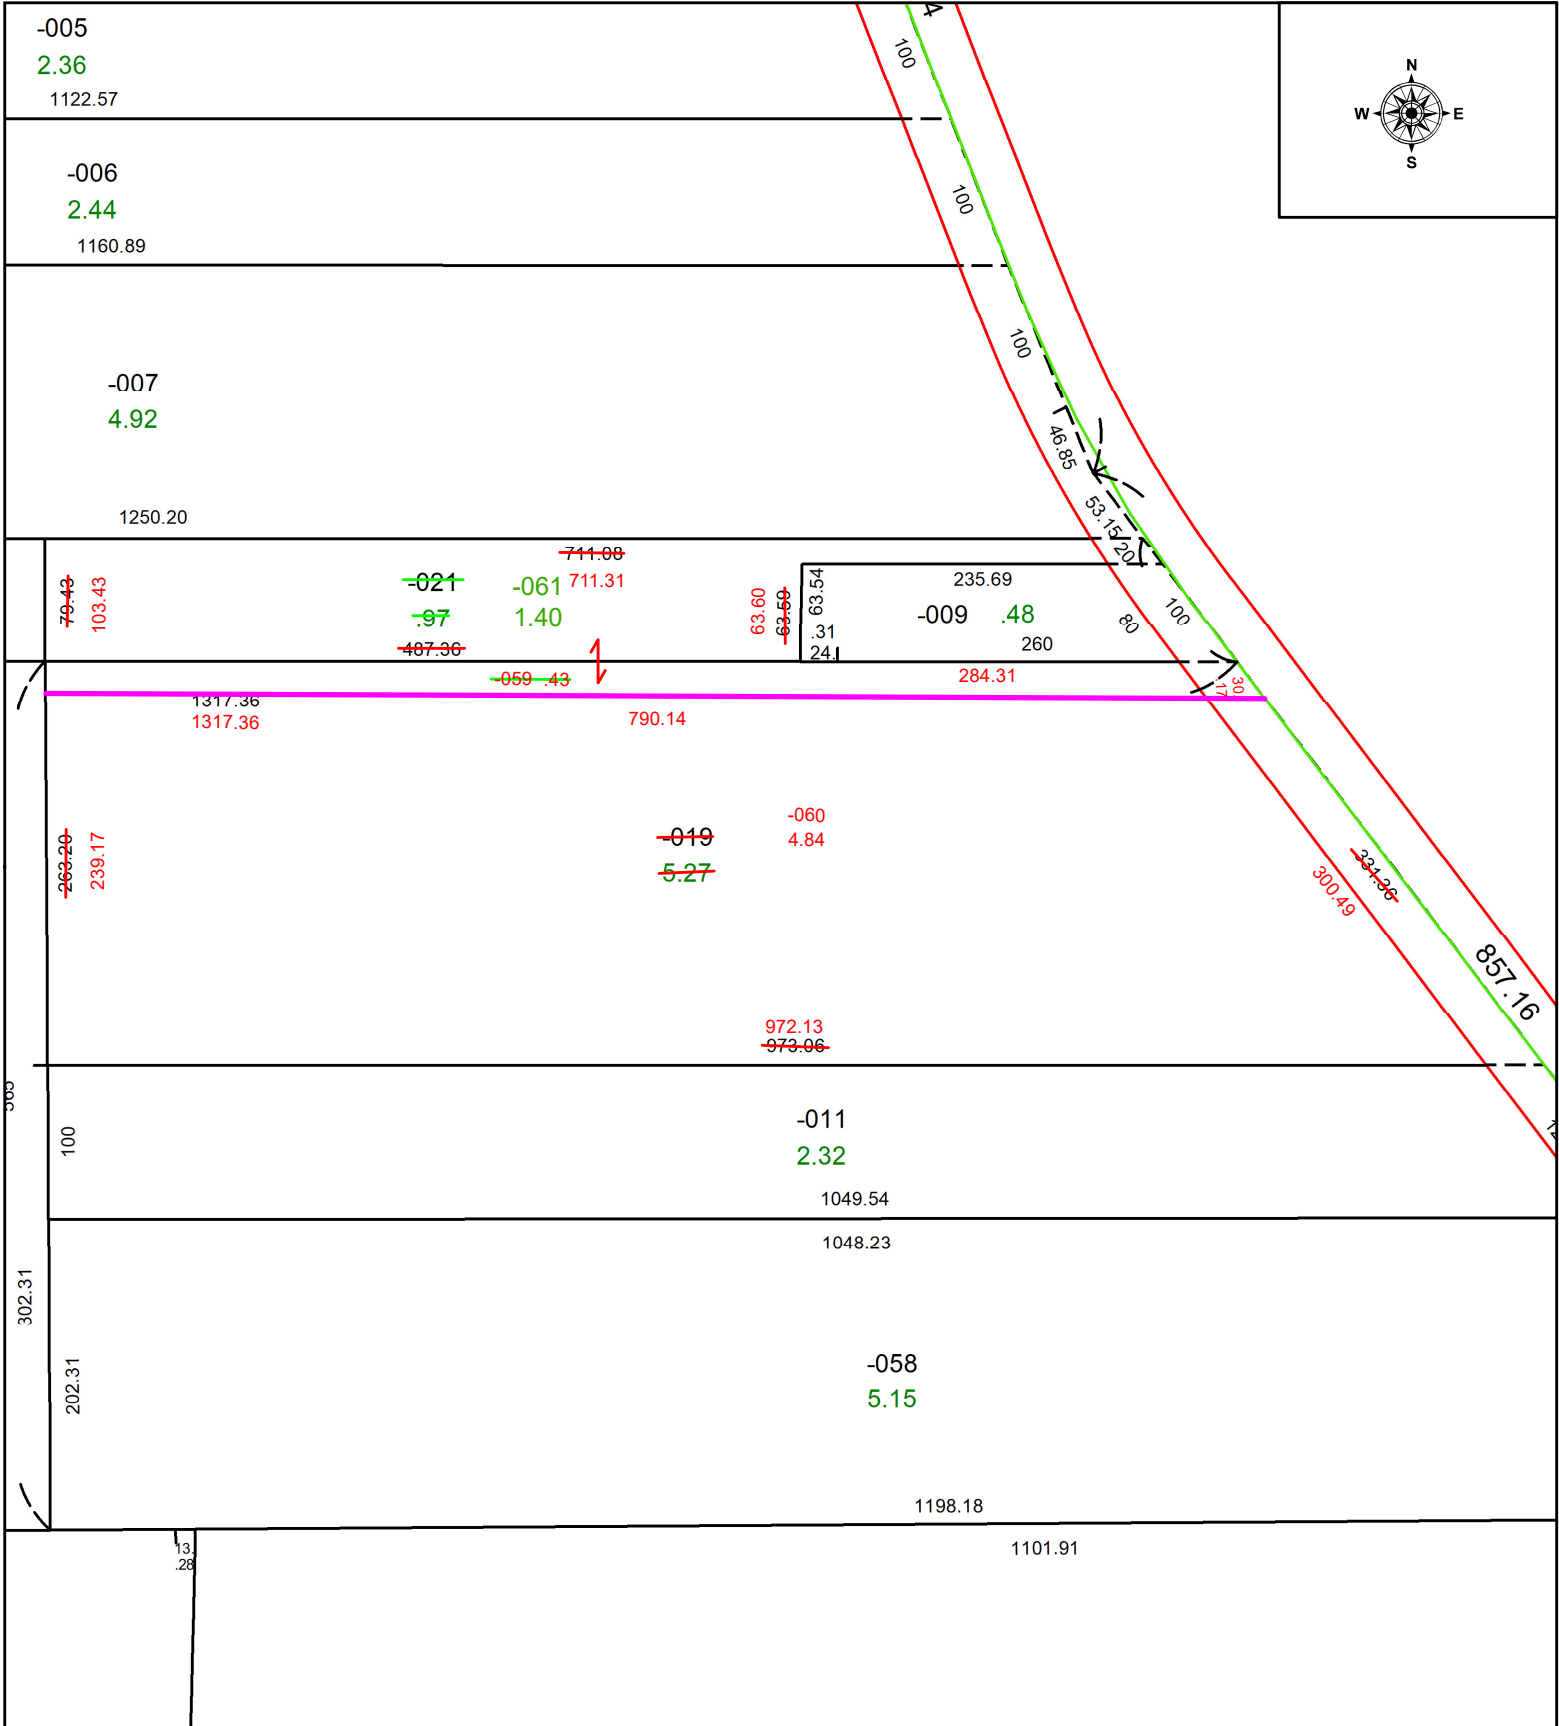

SPLITS/DEEDS PROCESSED
 LORAIN COUNTY TAX MAP DEPARTMENT
 226 MIDDLE AVE. ELYRIA, OH

SURVEYED BY: WILFREDO BARBOSA SURVEY # 51207
 CLOSURE: 1: 183552
 MAP PAGE(S): 11-00-010
 APPROVED BY: WRZ DATE: 6/13/2024
 SCALE: 1" = 125 PRIOR INSTRUMENT: #2024-0000998