
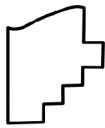


PARENT PARCEL: ADD TO DUPLICATE - PER ORD. 15-22

CHILD PARCEL: 03-00-037-111-073 1.00 A.

STARTING POINT: CL OF RICHELIEU AVE. & CL OF TREADWAY BLVD.

22-04867-V

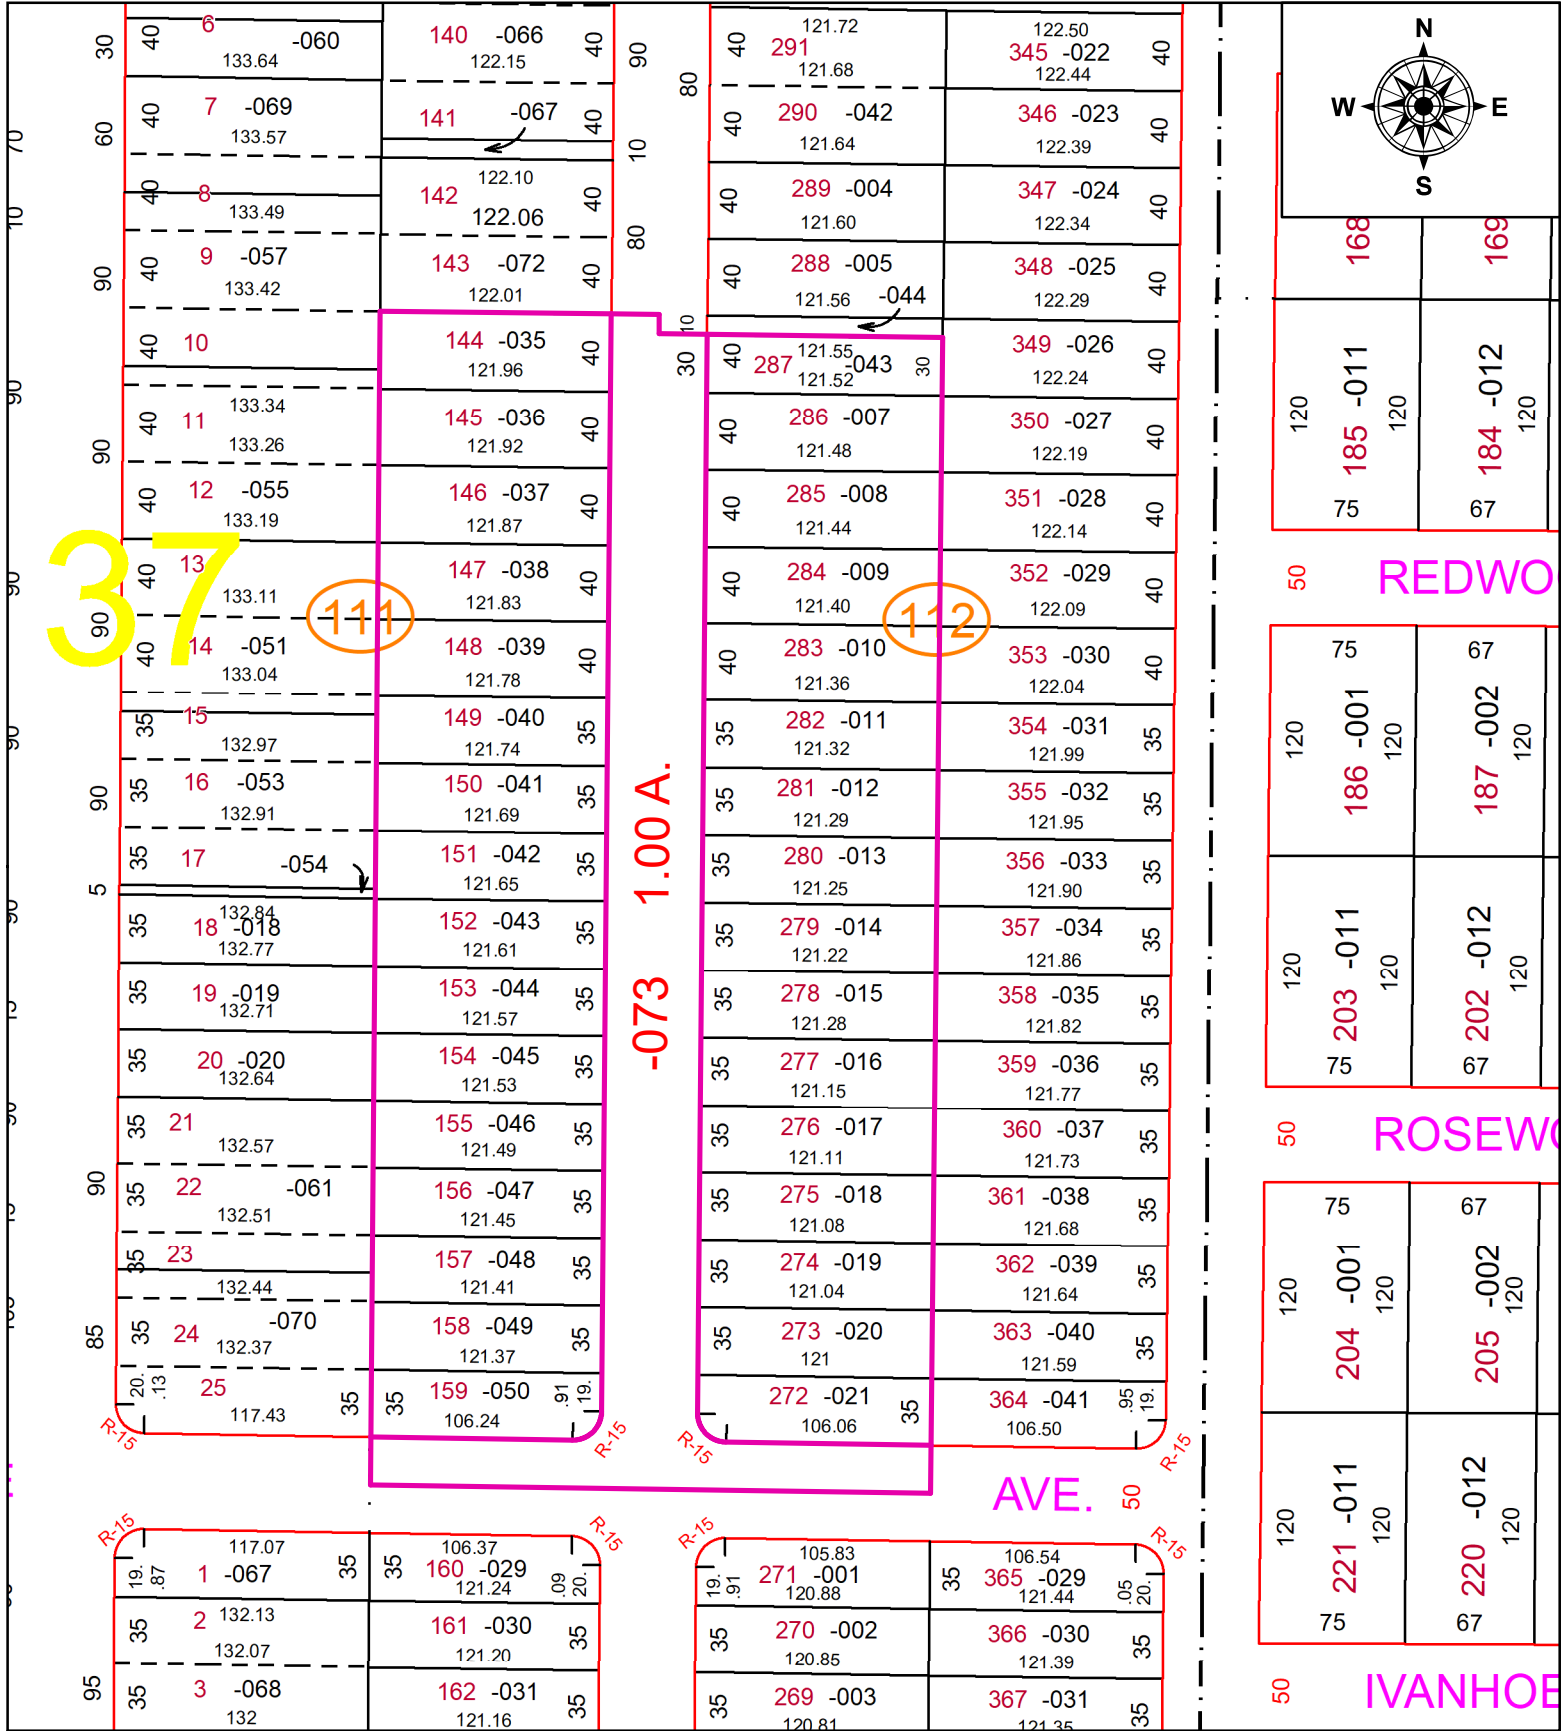

**SPLITS/DEEDS PROCESSED**  
 LORAIN COUNTY TAX MAP DEPARTMENT  
 226 MIDDLE AVE. ELYRIA, OH

SURVEYED BY: BRENT ANDERSON

CLOSURE: 1: 33,000

MAP PAGE(S): 12-00-033

APPROVED BY: TJS DATE: 6/13/2022

SCALE: 1" = 100' PRIOR INSTRUMENT: NA