
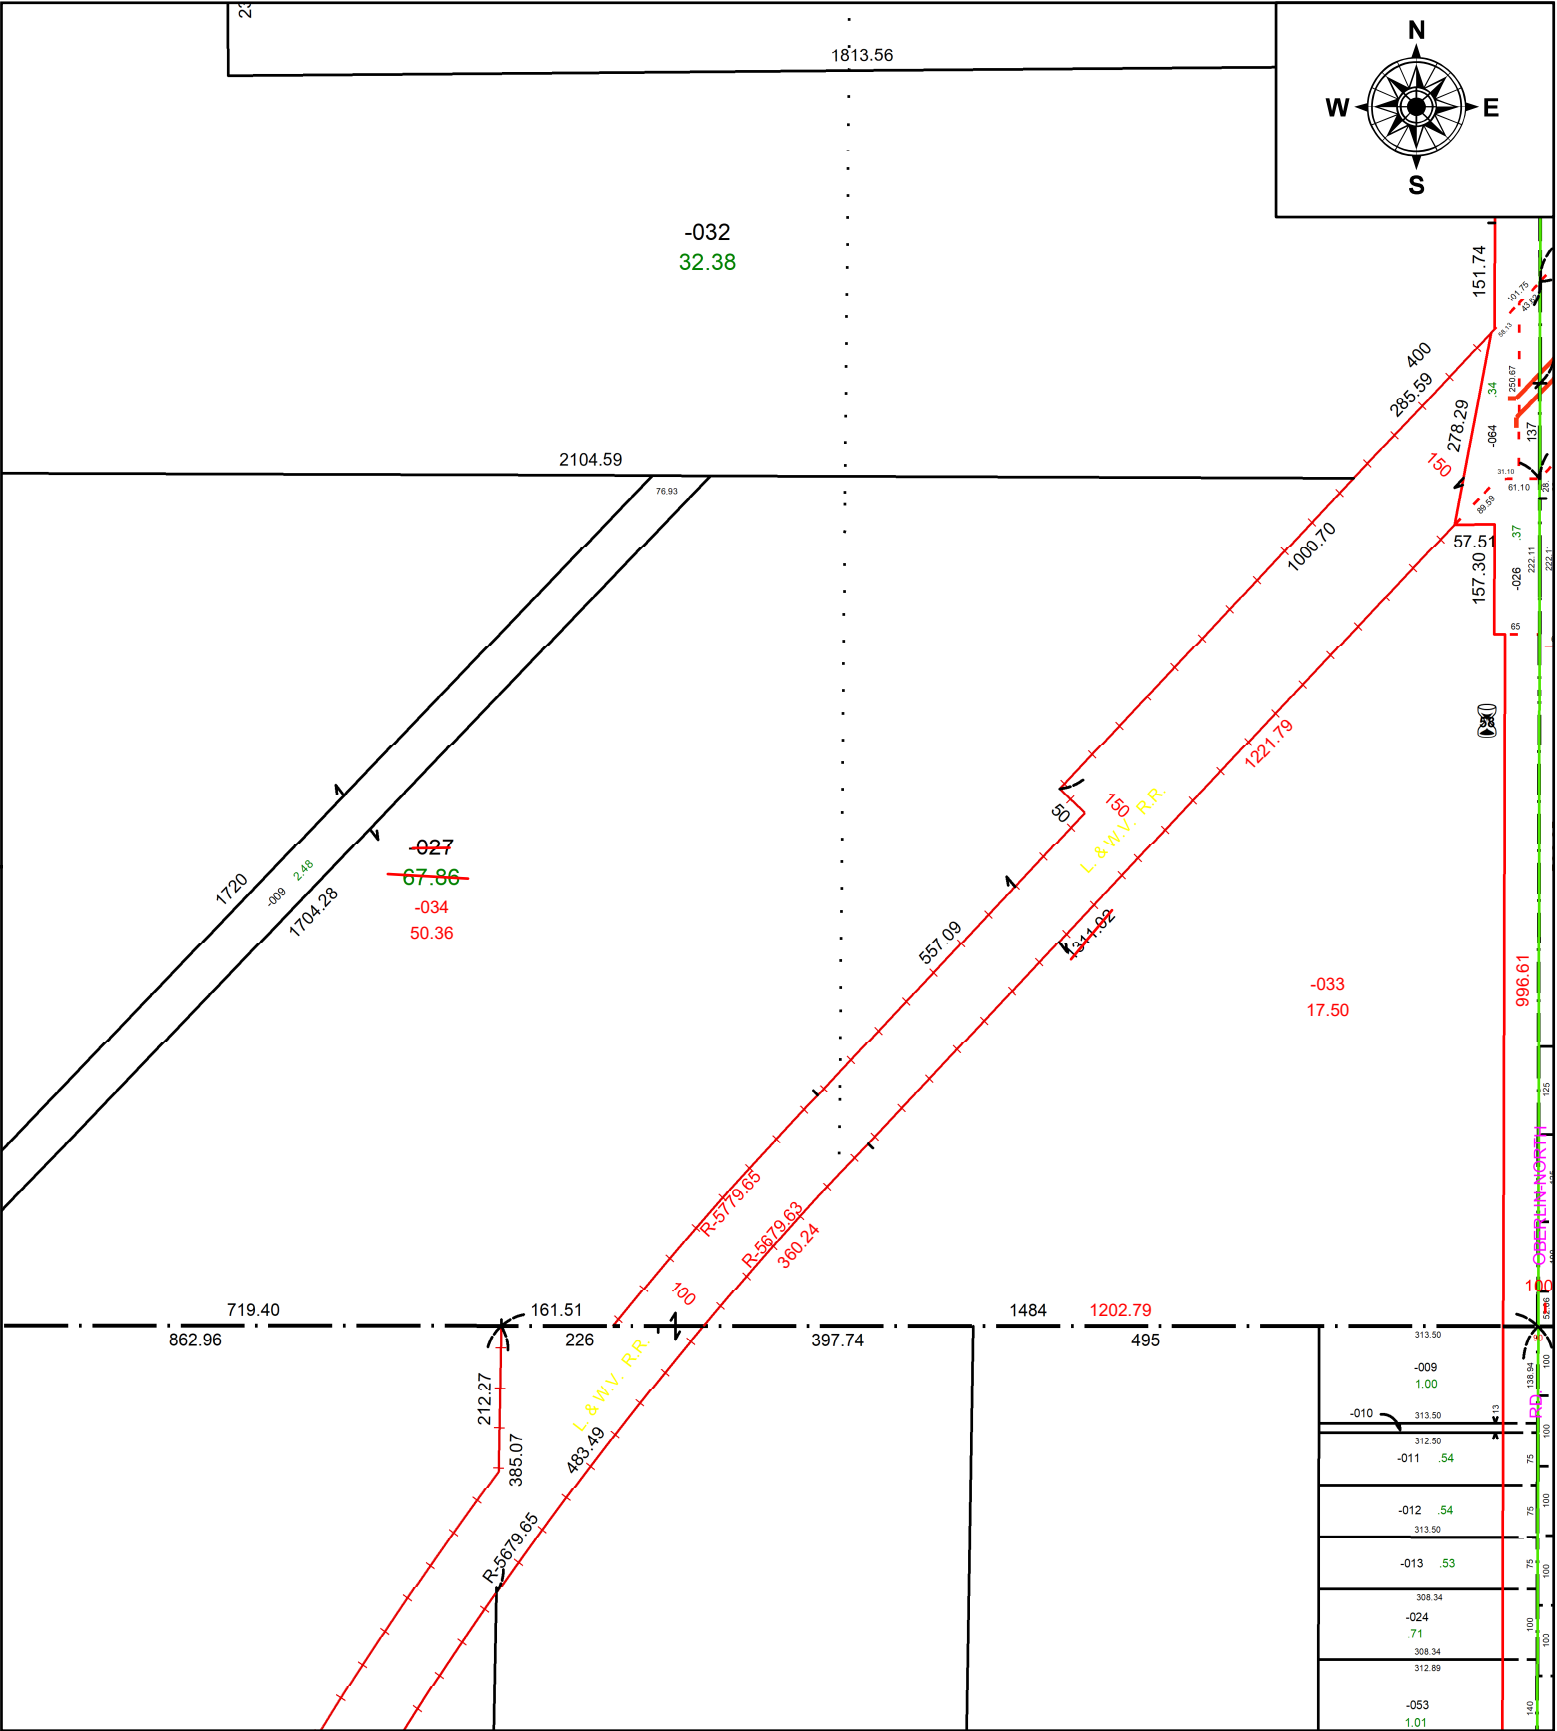


PARENT PARCEL: 05-00-034-000-027


CHILD PARCEL: 05-00-034-000-033 & -034

STARTING POINT: SW CORNER OF O/L 34

24-04870

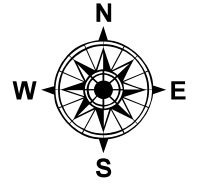

| | |
|--------|------|
| 313.50 | |
| -009 | 1.00 |
| -010 | |
| -011 | .54 |
| -012 | .54 |
| -013 | .53 |
| -024 | |
| 71 | |
| -053 | 1.01 |

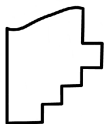

SPLITS/DEEDS PROCESSED
LORAIN COUNTY TAX MAP DEPARTMENT
226 MIDDLE AVE. ELYRIA, OH

SURVEYED BY: THOMAS A. SIMON

SURV # 51210

CLOSURE: 1: 744641

MAP PAGE(S): 05-00-034

APPROVED BY: AC DATE: June 18, 2024

SCALE: 1 in = 275 ft PRIOR INSTRUMENT: VOL 1169 PG 195