


PARENT PARCEL: 04-00-030-147-006

CHILD PARCEL: **AC. CORR. PER SURVEY PATRICK McGANNON.**

STARTING POINT: CL OF MERIDIAN CT. & LONG POINT DR.

22-04871-A

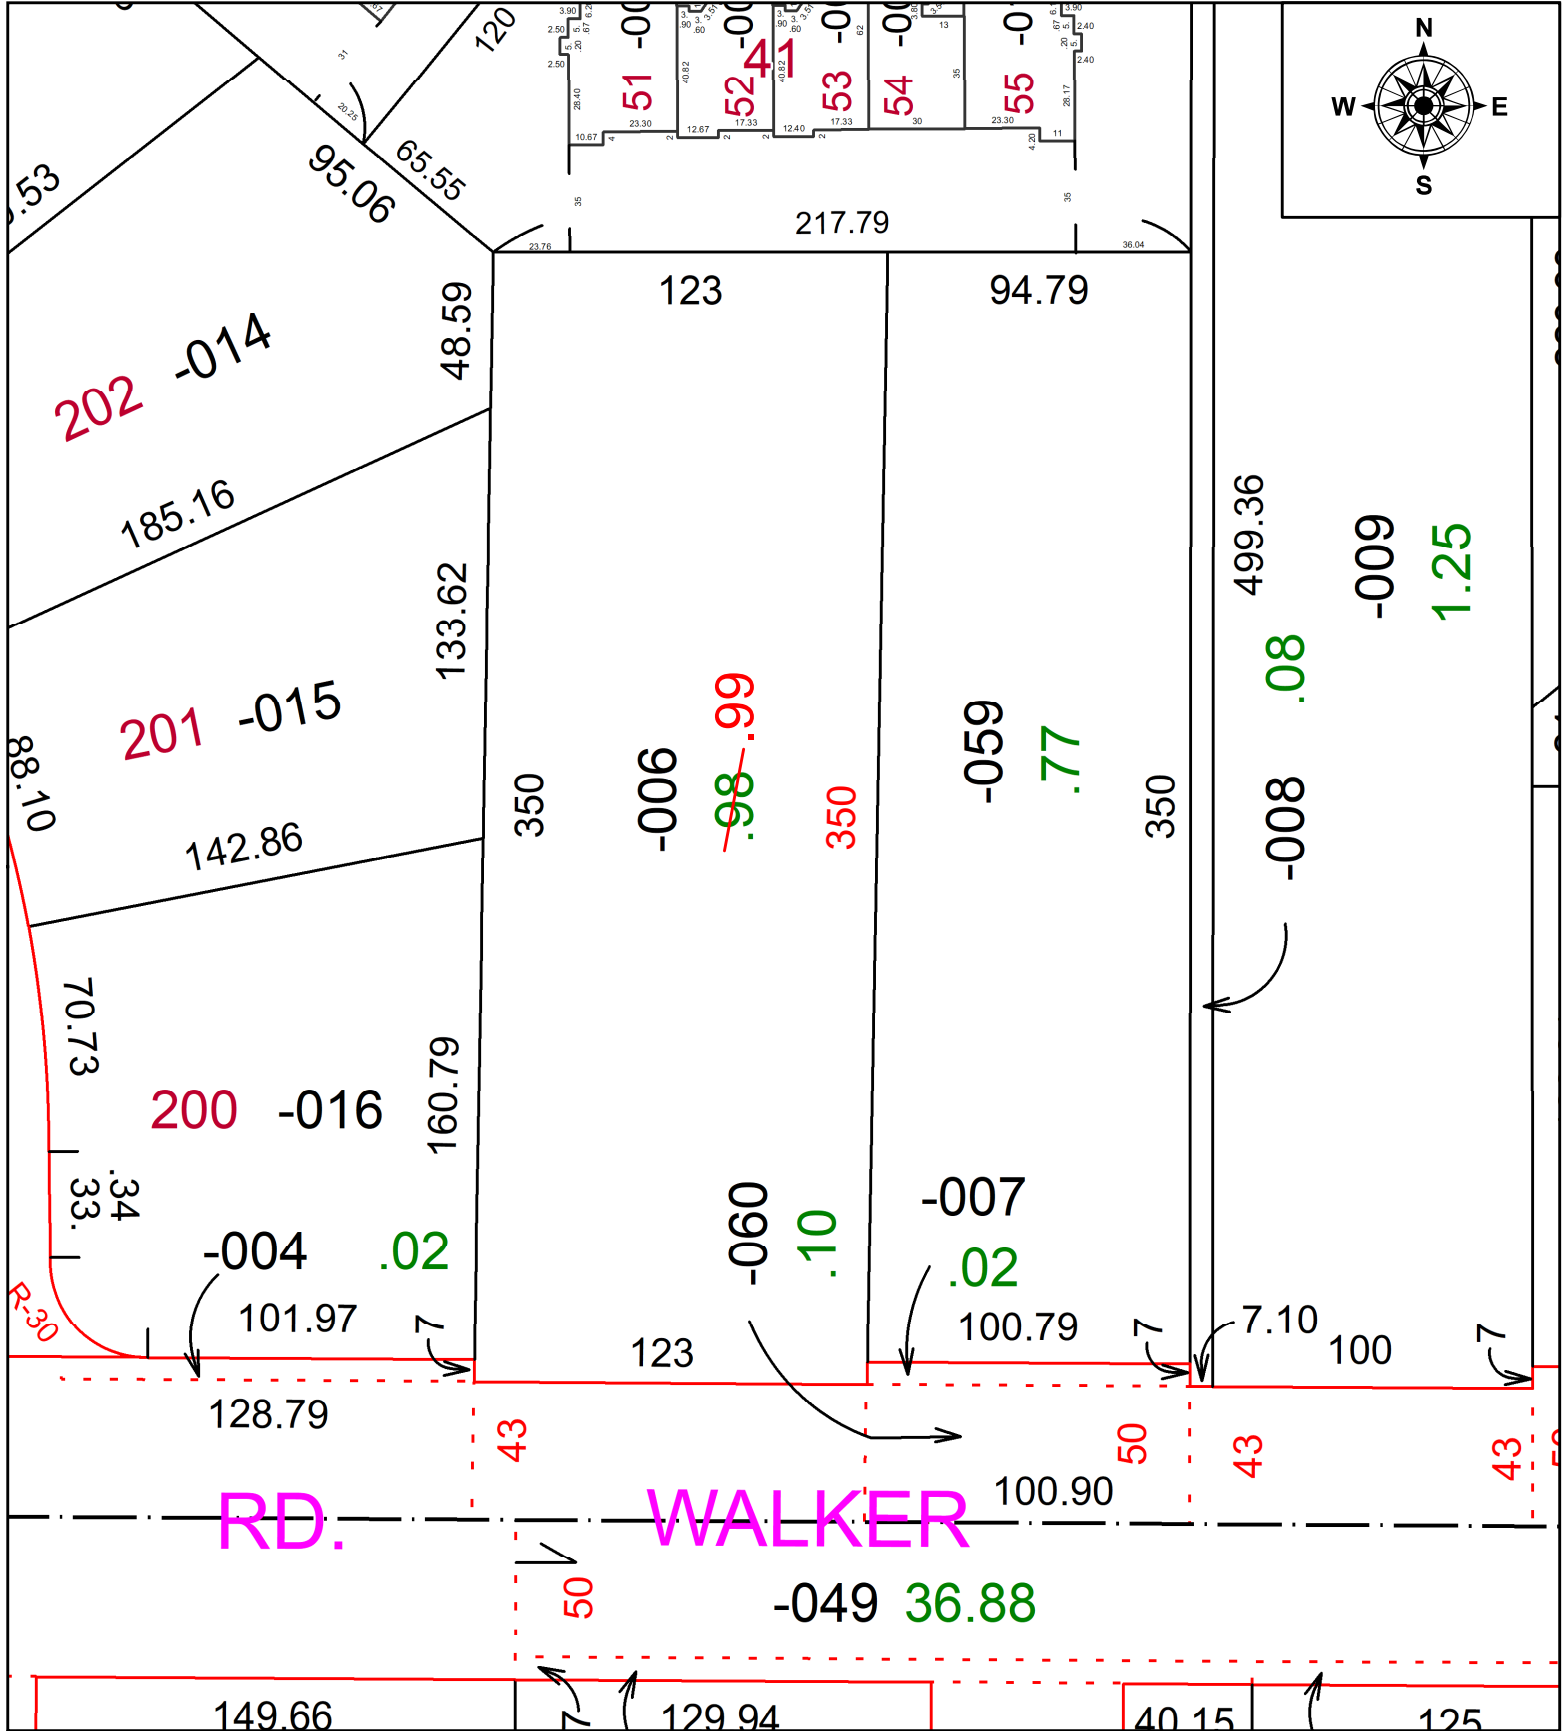

SPLITS/DEEDS PROCESSED
 LORAIN COUNTY TAX MAP DEPARTMENT
 226 MIDDLE AVE. ELYRIA, OH

SURVEYED BY: PATRICK McGANNON
 CLOSURE: 1: 33,000
 MAP PAGE(S): 04-00-030
 APPROVED BY: DMA DATE: 5/26/2022
 SCALE: 1" = 60' PRIOR INSTRUMENT: 2015-0533818