


PARENT PARCEL: 04-00-002-101-093 & -094

CHILD PARCEL: **04-00-002-101-391**

STARTING POINT: C/L OF MOON AND COURSEVIEW DR

24-04872

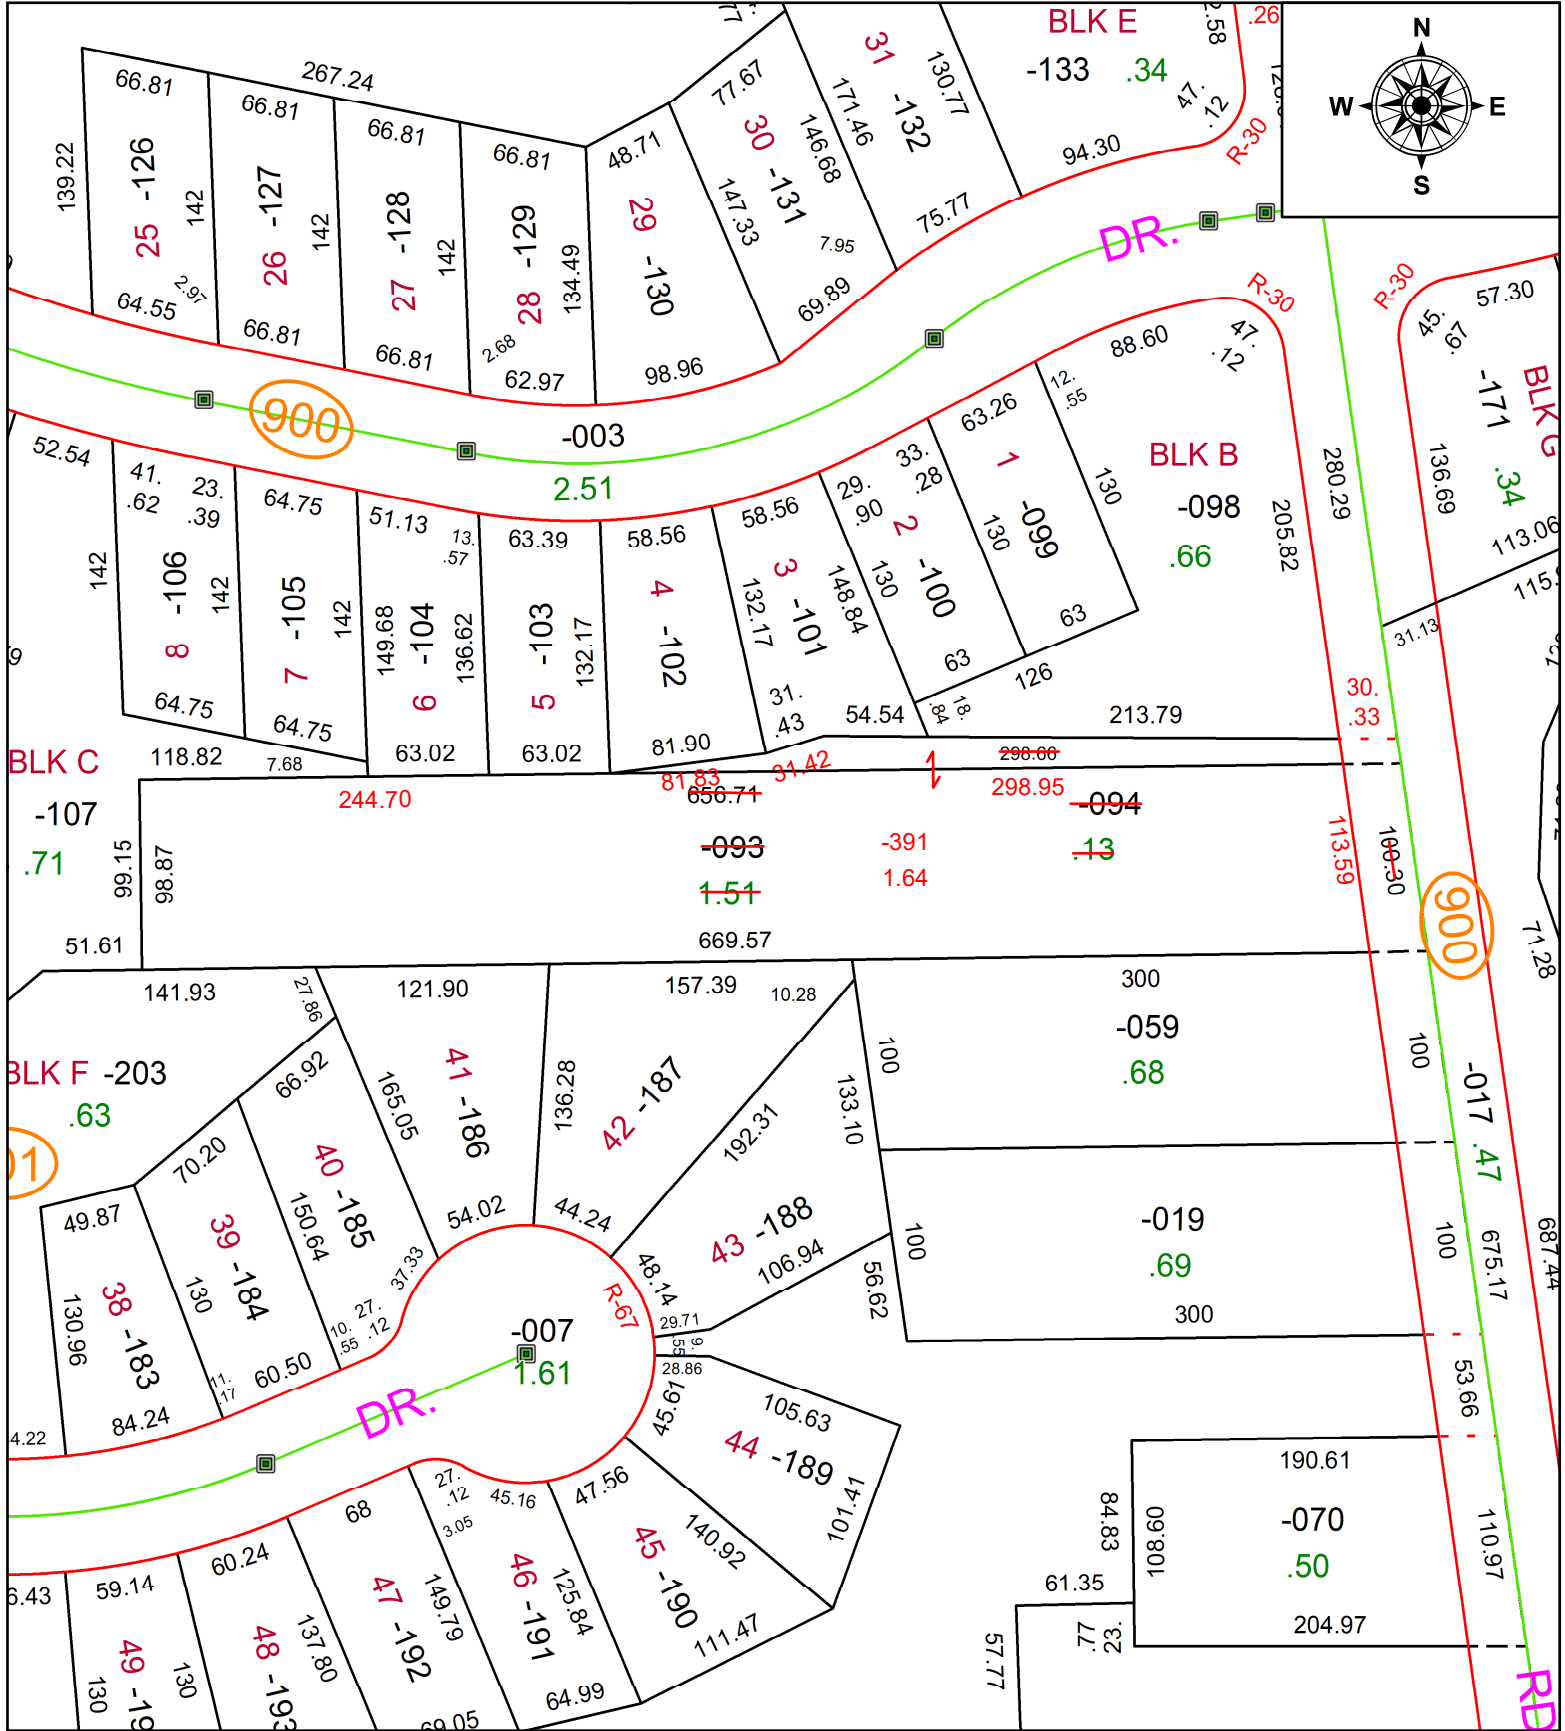

SPLITS/DEEDS PROCESSED
 LORAIN COUNTY TAX MAP DEPARTMENT
 226 MIDDLE AVE. ELYRIA, OH

SURVEYED BY: RICHARD A. THOMPSON JR. **SURV # 51214**
CLOSURE: 1: 150992
MAP PAGE(S): 04-00-002
APPROVED BY: AC **DATE:** June 21, 2024
SCALE: 1 in = 100 ft **PRIOR INSTRUMENT:** 2008- 0274691