


PARENT PARCEL: 15-00-031-000-012 & -036


CHILD PARCEL: **15-00-031-000-059**

STARTING POINT: C/L OF BIGGS AND INDIAN HOLLOW RD

24-04873

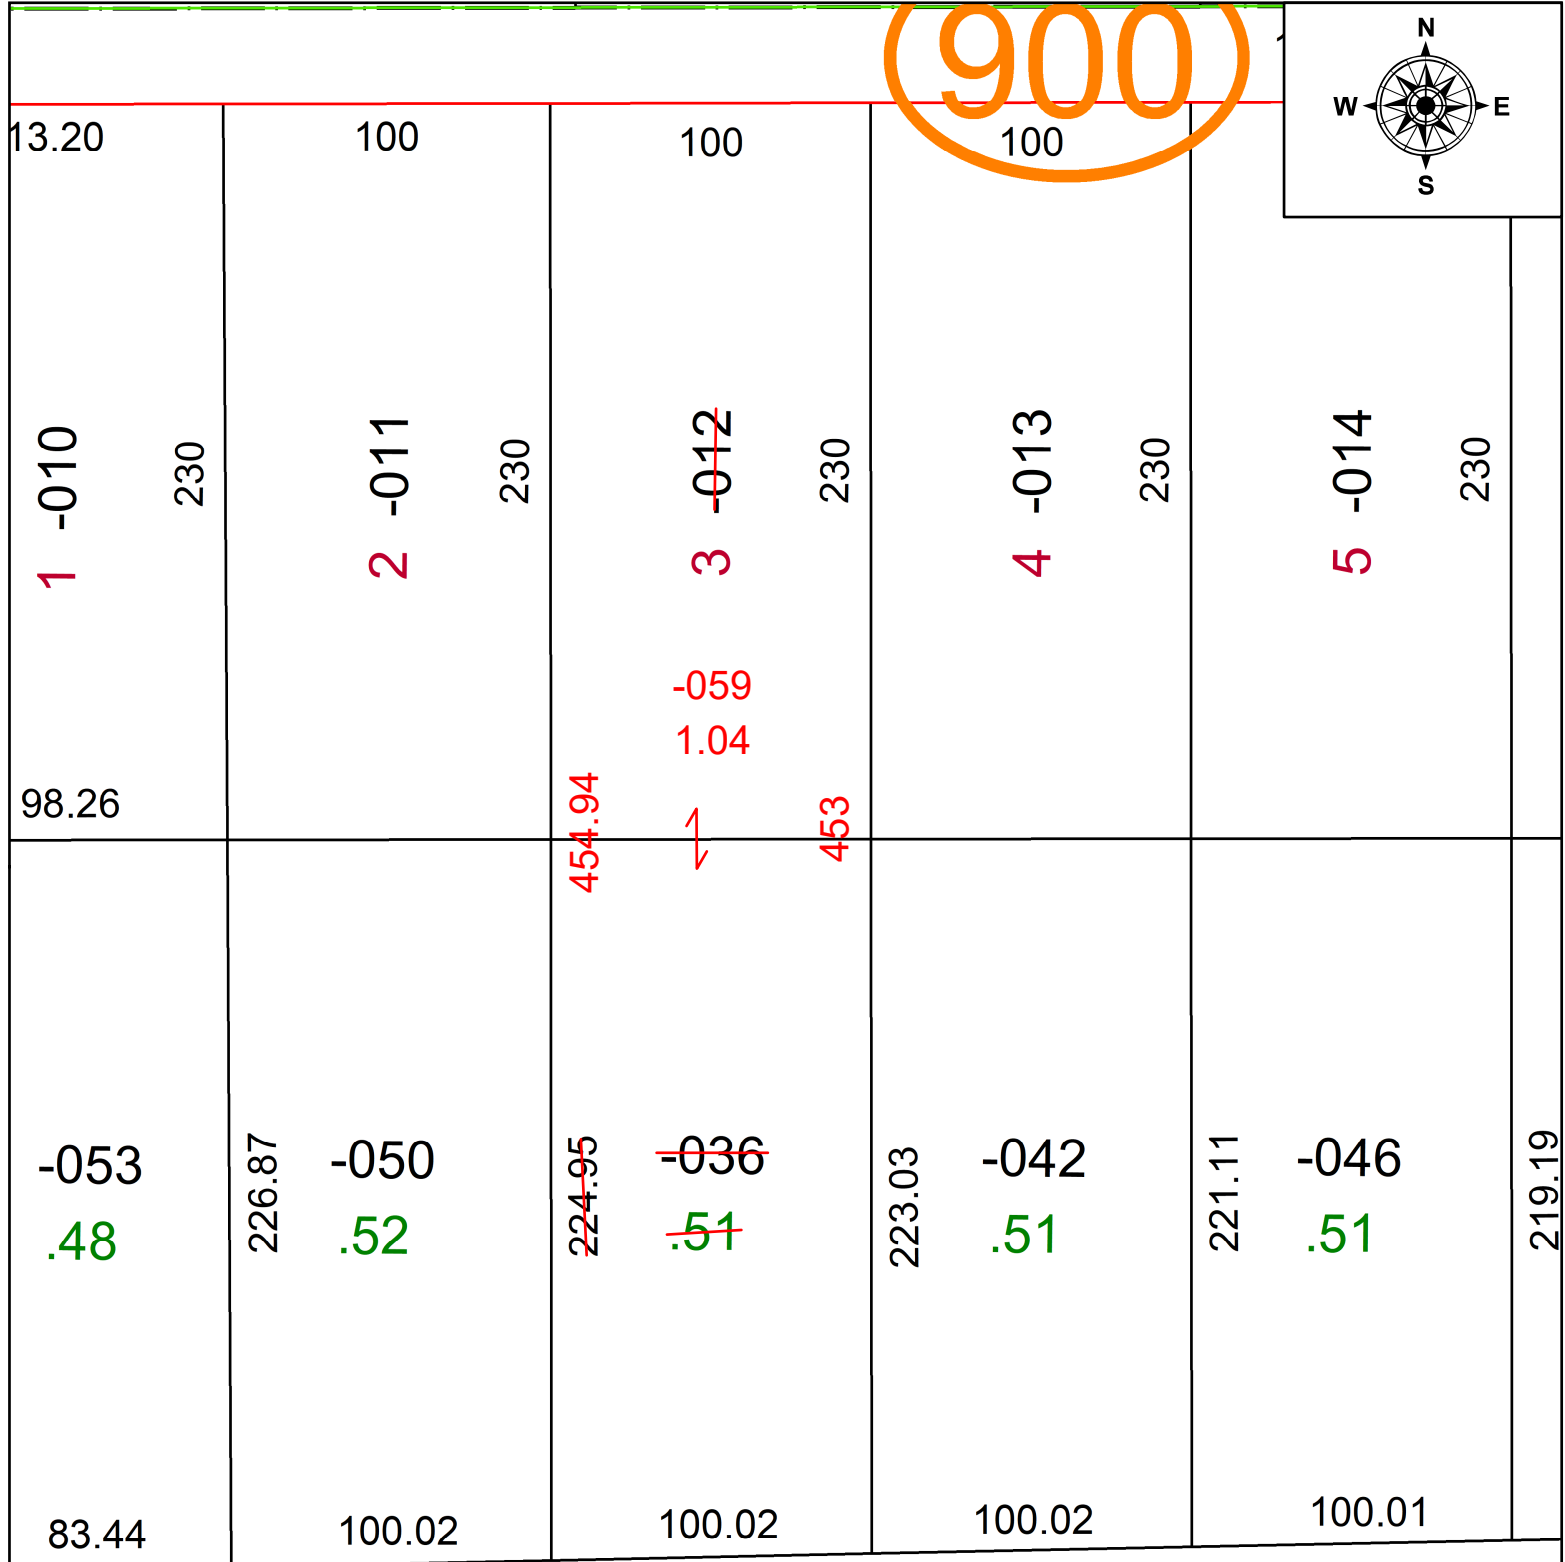

883.58

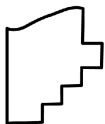

SPLITS/DEEDS PROCESSED
LORAIN COUNTY TAX MAP DEPARTMENT
226 MIDDLE AVE. ELYRIA, OH

SURVEYED BY: THOMAS A. SIMON	SURV # 51215
CLOSURE: 1: 160387	
MAP PAGE(S): 15-00-031	
APPROVED BY: AC	DATE: June 25, 2024
SCALE: 1 in = 60 ft	PRIOR INSTRUMENT: 2004- 0034463