
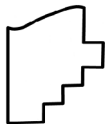


PARENT PARCEL: 07-00-015-110-026 AC. CORR. FROM 2.64 A. TO 2.63 A. PER INST. # 2010-0356908

CHILD PARCEL: XX-XX-XXX-XXX-XXX

STARTING POINT: CL OF CHESTNUT RIDGE RD. & N.E. CORNER OF LAND CONVEYED TO HILL IN DV. 476 PG. 286 L.C. RECORDS

22-04876-C

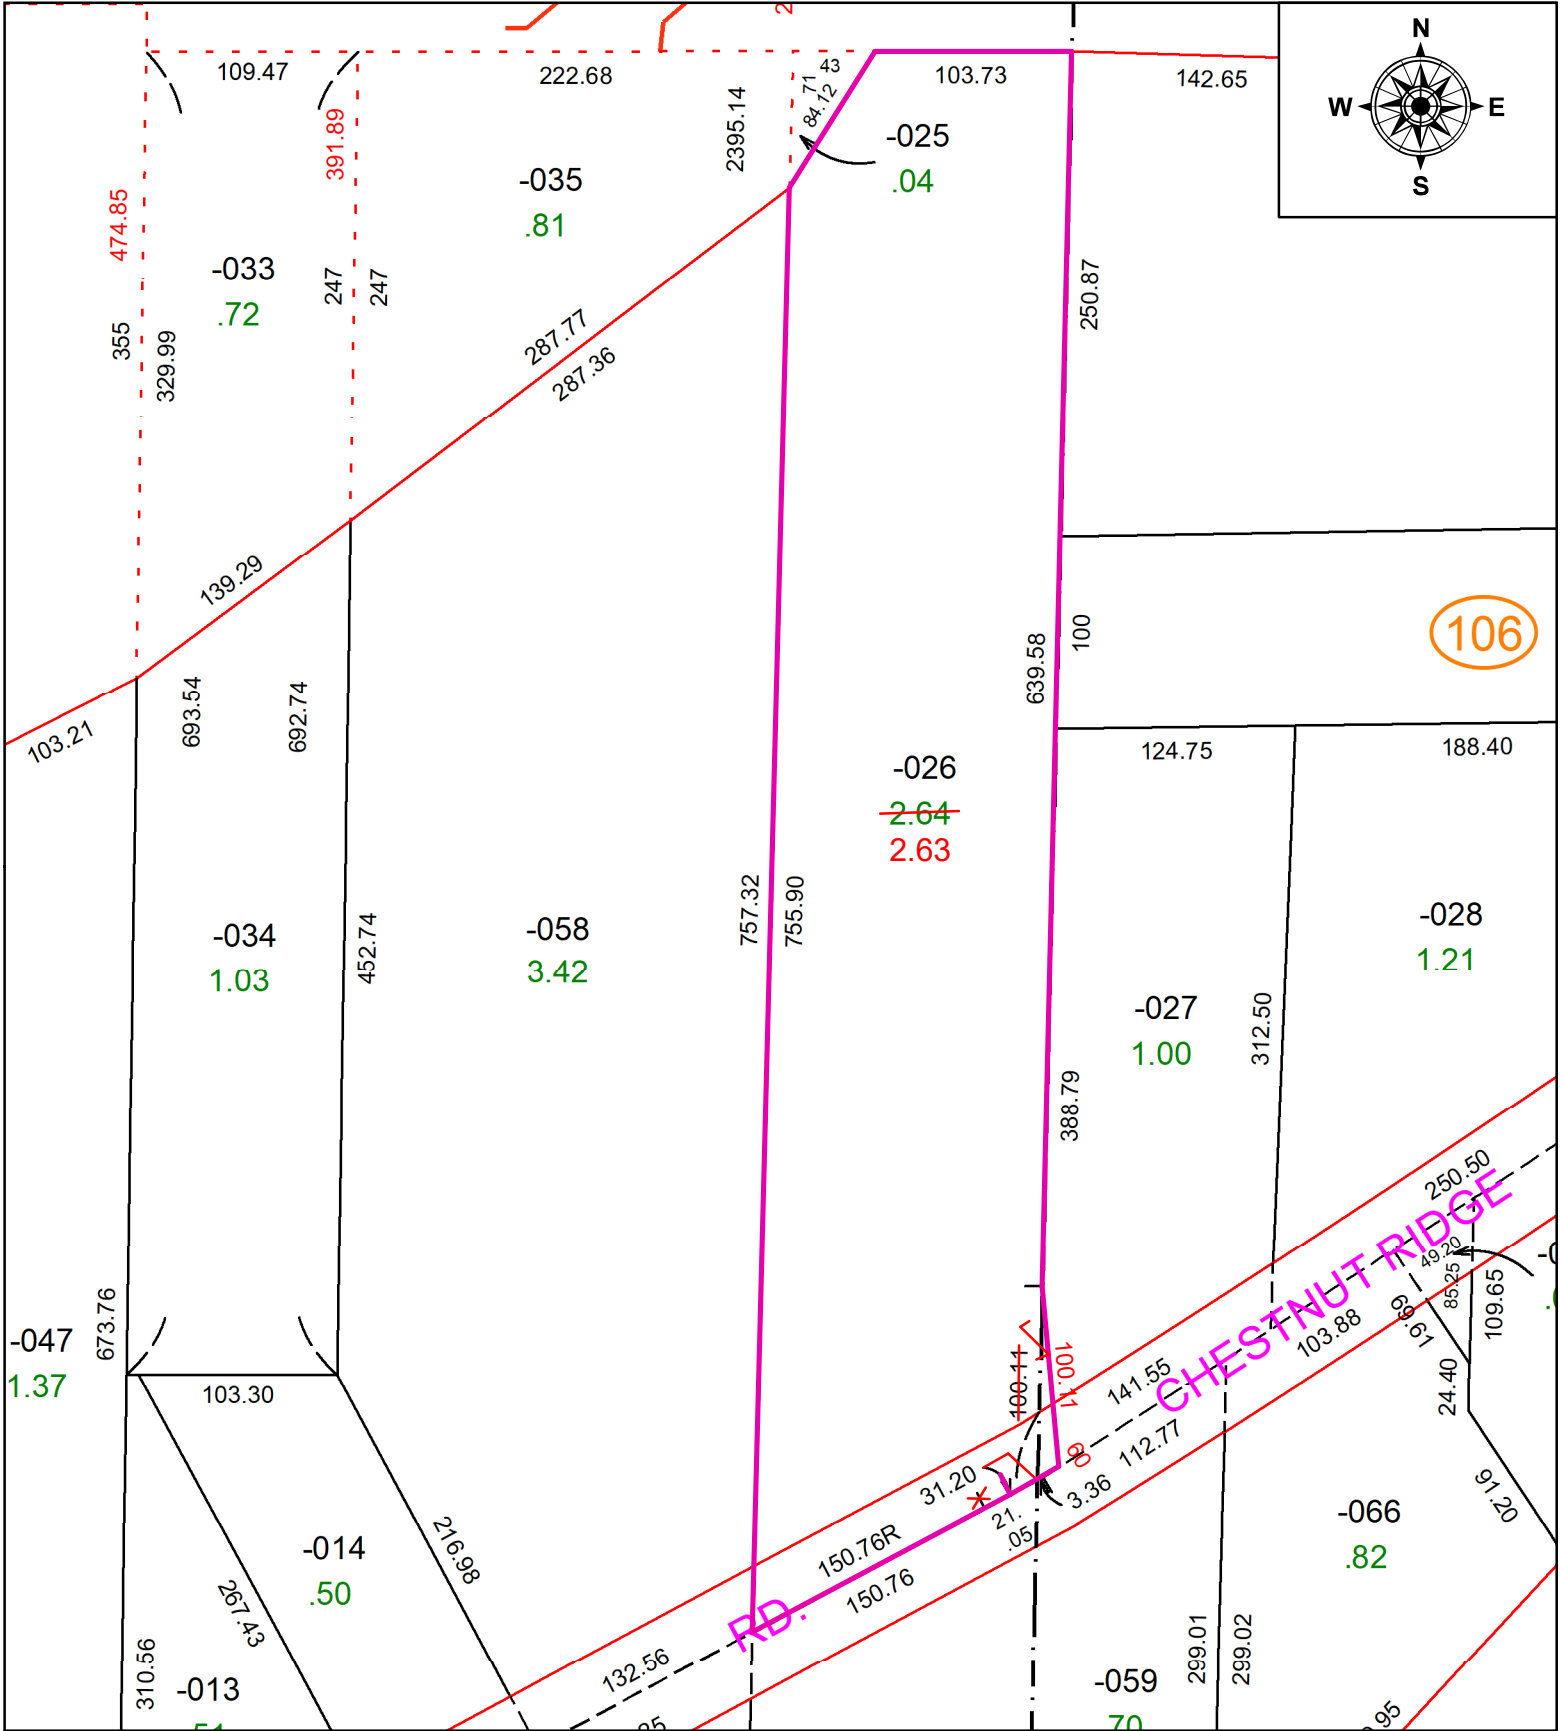

SPLITS/DEEDS PROCESSED
 LORAIN COUNTY TAX MAP DEPARTMENT
 226 MIDDLE AVE. ELYRIA, OH

SURVEYED BY: _____ NA
 CLOSURE: _____ 1: 11000
 MAP PAGE(S): _____ 07-00-015
 APPROVED BY: _____ TJS DATE: _____ 6/8/2022
 SCALE: _____ 1" = 100' PRIOR INSTRUMENT: _____ 2010-0356908