

PARENT PARCEL:

06-25-007-000-029, -031, & -178


CHILD PARCEL:

06-25-007-000-276 AC CORR PER SURVEYOR ALEX MARKS

STARTING POINT:

INTERSECTION OF C/LS OF E. BROAD ST & ABBE RD

24-04880

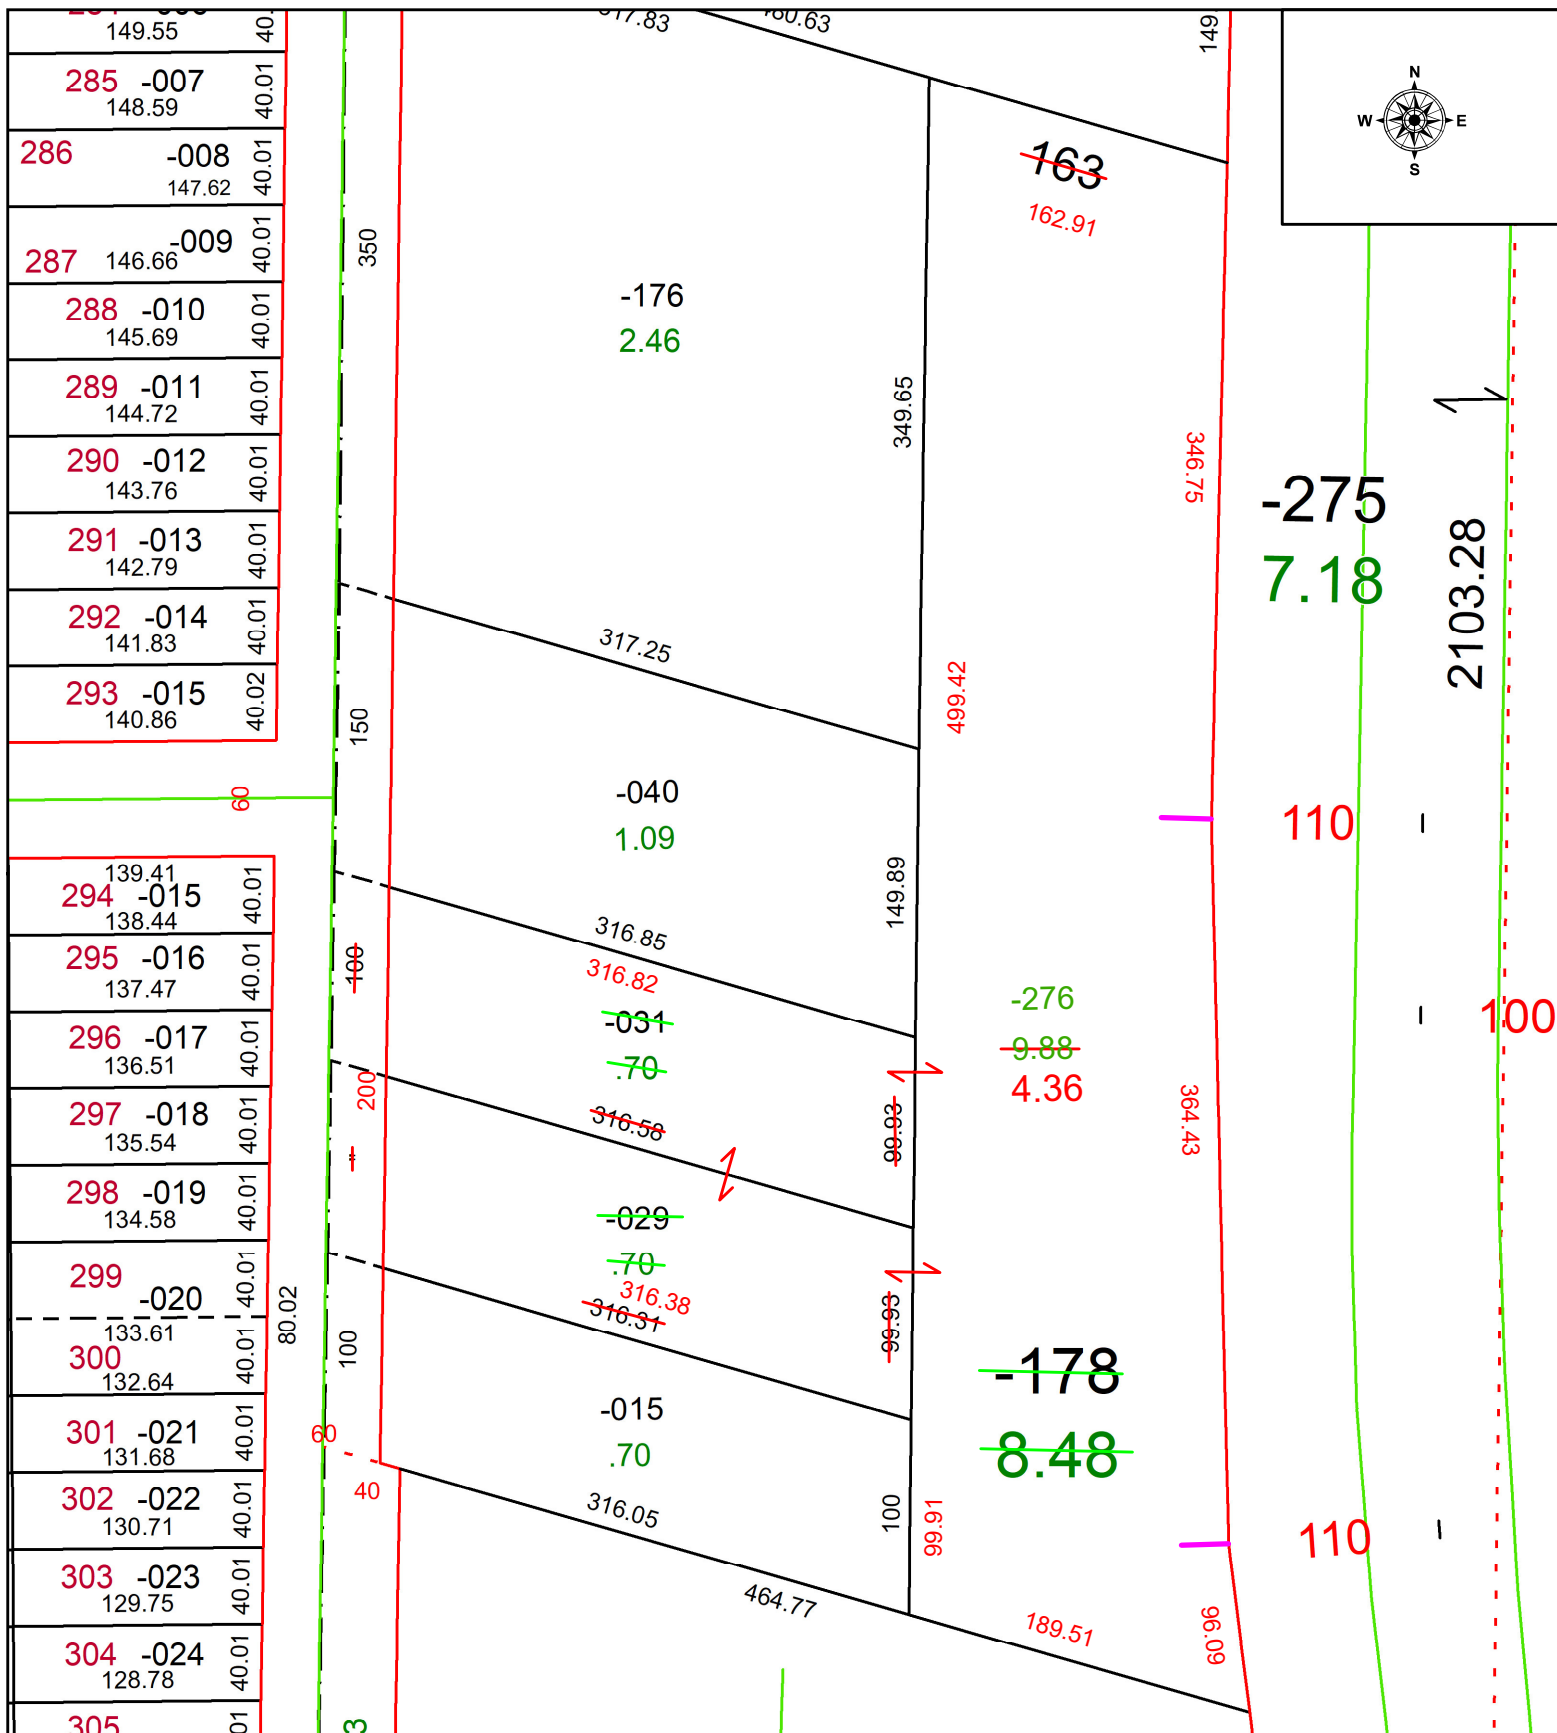

SPLITS/DEEDS PROCESSED
 LORAIN COUNTY TAX MAP DEPARTMENT
 226 MIDDLE AVE. ELYRIA, OH

SURVEYED BY: ALEX MARKS SURVEY # 51224
 CLOSURE: 1: 178469
 MAP PAGE(S): 06-25-007
 APPROVED BY: WRZ DATE: 7/8/2024
 SCALE: 1" = 100 PRIOR INSTRUMENT: #2022-0868778