
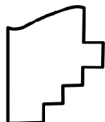


PARENT PARCEL: 04-00-014-102-024, -026, & -041

CHILD PARCEL: 04-00-014-102-046 THRU -048

24-04881

STARTING POINT: CL OF FALCON CREST AVE. & CL OF CENTER ROAD (S.R. 83)

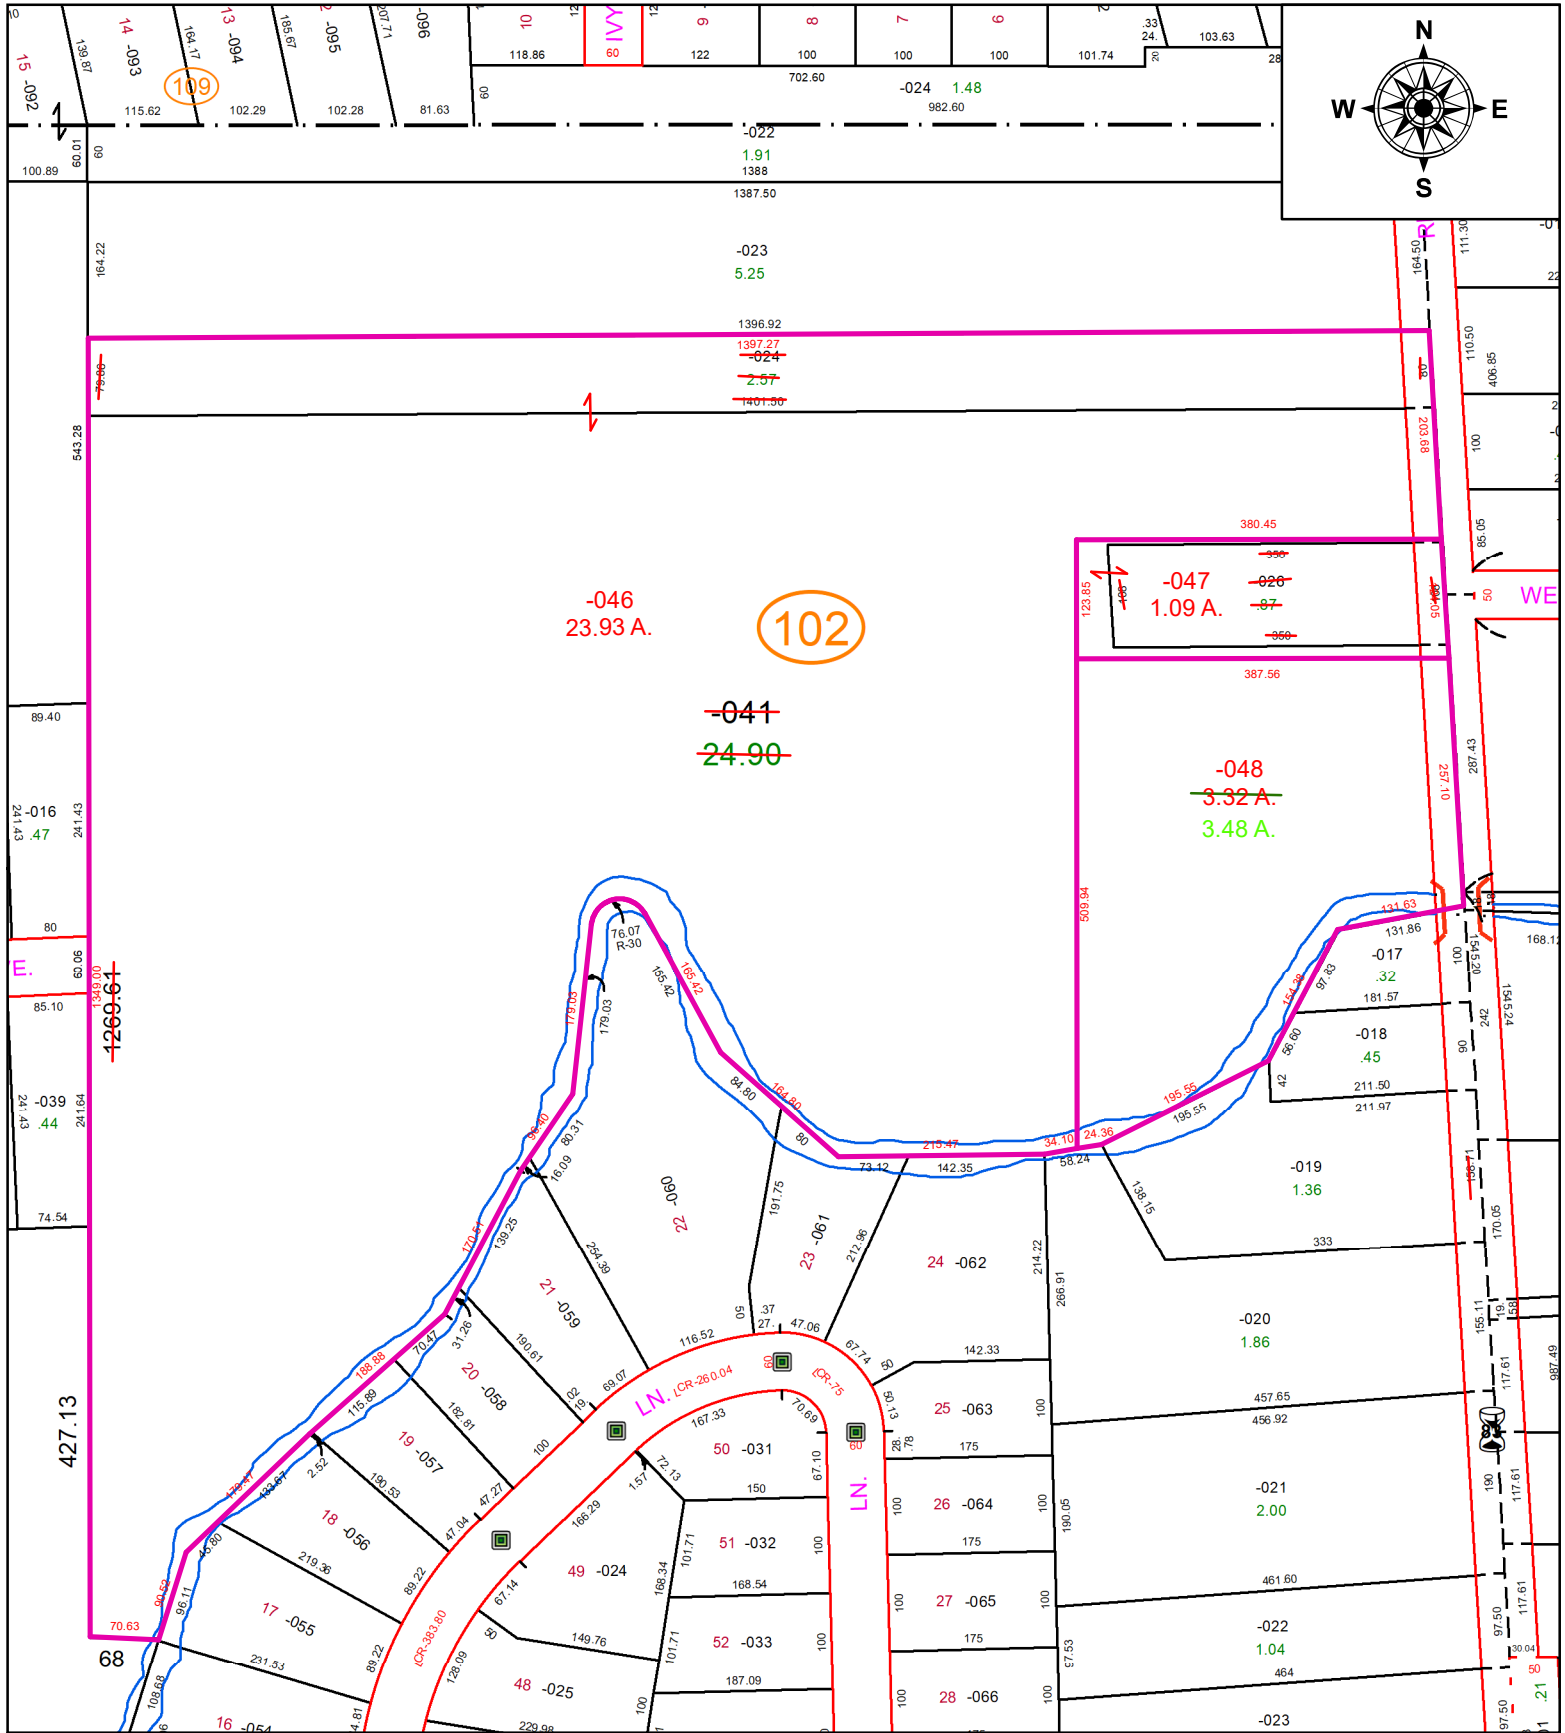

SPLITS/DEEDS PROCESSED
 LORAIN COUNTY TAX MAP DEPARTMENT
 226 MIDDLE AVE. ELYRIA, OH

SURVEYED BY: JOSEPH BURGOON
CLOSURE: 1:431530
MAP PAGE(S): 04-00-014
APPROVED BY: TJS **DATE:** 7/9/2024
SCALE: 1" = 200 **PRIOR INSTRUMENT:** 2021-0842190