
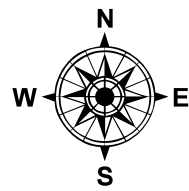


PARENT PARCEL: 04-00-023-102-026, 04-00-014-107-169

CHILD PARCEL: **AC CORR PER SURV BY JEREMY M. SACK**

STARTING POINT: C/L OF SADDLE CREEK DR AND JAYCOX RD

22-04882-C

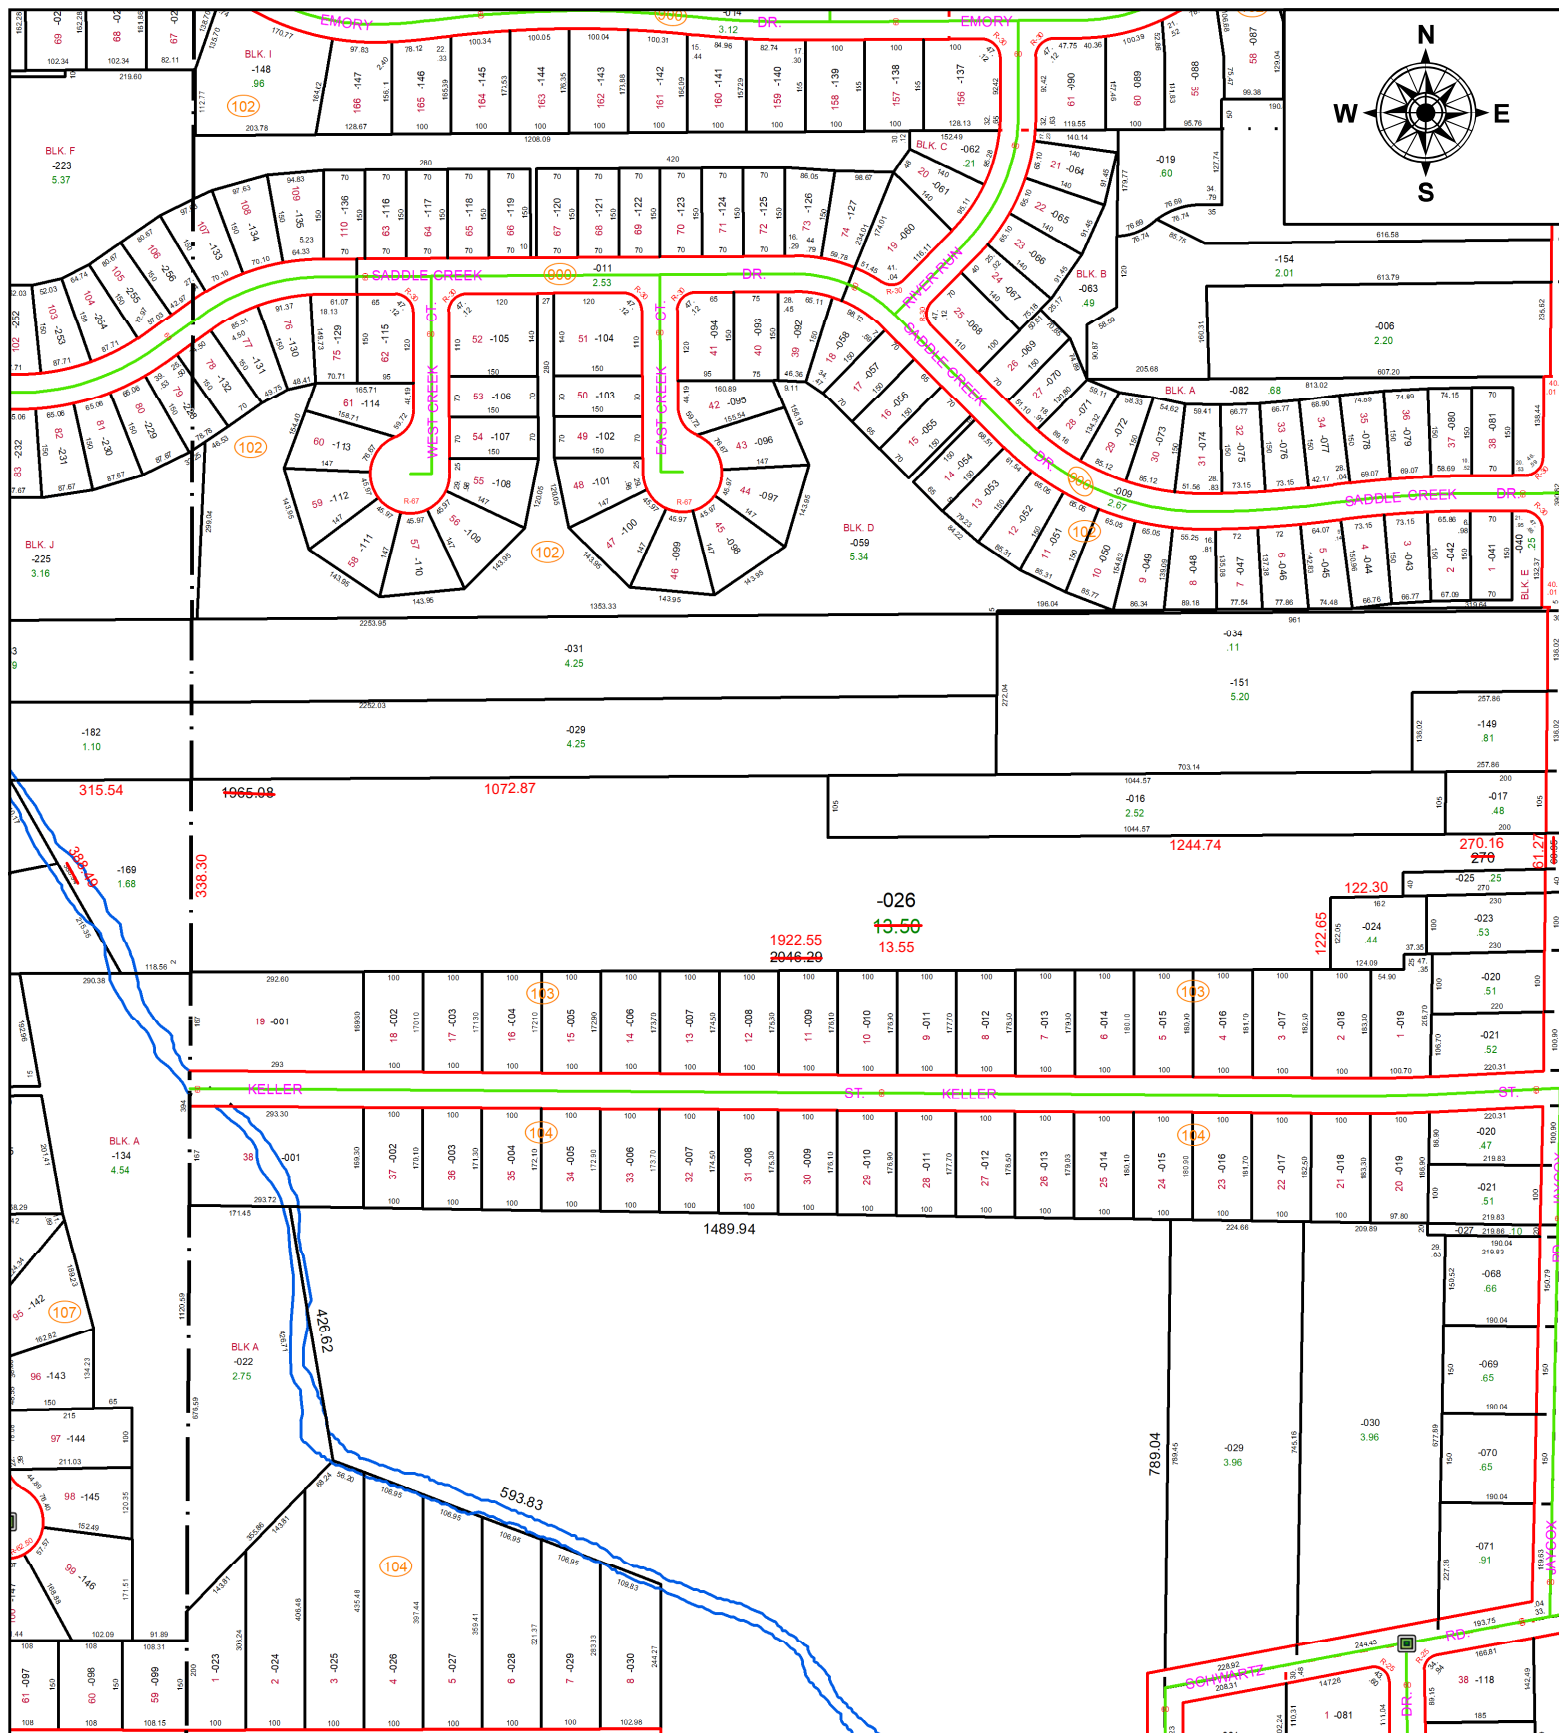

SPLITS/DEEDS PROCESSED
 LORAIN COUNTY TAX MAP DEPARTMENT
 226 MIDDLE AVE. ELYRIA, OH

SURVEYED BY: JEREMY M. SACK
CLOSURE: 1: 483147
MAP PAGE(S): 04-00-023-A
APPROVED BY: AC **DATE:** 6/15/2022
SCALE: 1" = 325 **PRIOR INSTRUMENT:** 2019- 0723488