
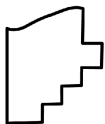


PARENT PARCEL: 03-00-036-122-014, -015, -016, & -017

CHILD PARCEL: 03-00-036-122-028

STARTING POINT: C/L OF PARKVIEW DR AND RICHELIEU AVE

24-04883

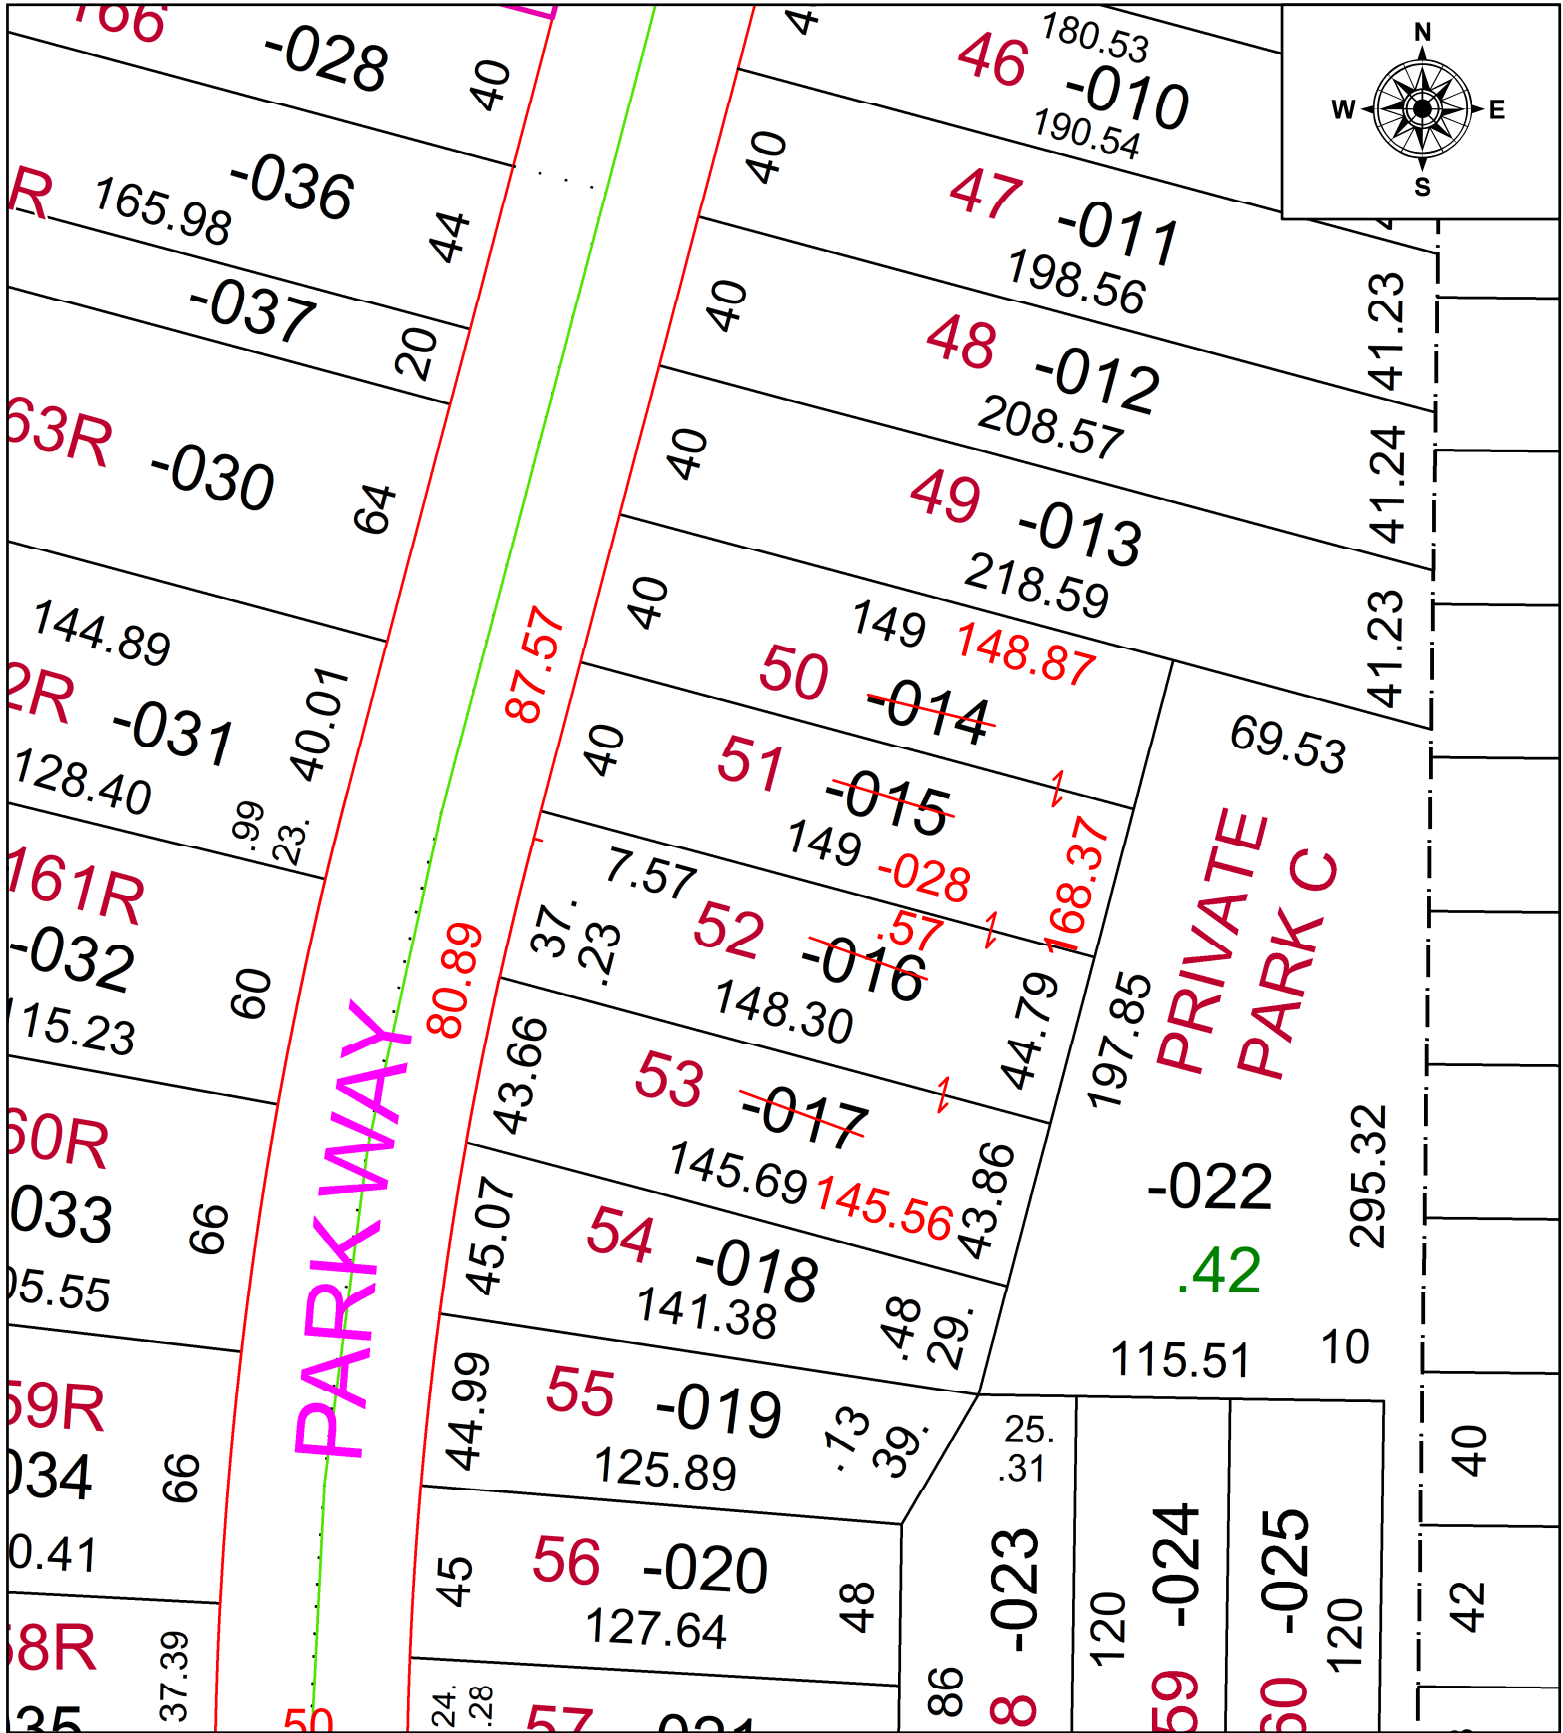

SPLITS/DEEDS PROCESSED
 LORAIN COUNTY TAX MAP DEPARTMENT
 226 MIDDLE AVE. ELYRIA, OH

SURVEYED BY: STAN R. LOCH SURV # 51231
 CLOSURE: 1: 151367
 MAP PAGE(S): 03-00-036
 APPROVED BY: AC DATE: July 18, 2024
 SCALE: 1 in = 50 ft PRIOR INSTRUMENT: 2024- 0001582