


PARENT PARCEL: 02-01-005-116-005


CHILD PARCEL: **FR. & DEPTH TO AC. CORR. PER SURVEY THOMAS SIMON**

22-04884-C

STARTING POINT: N.W. CORNER S/L 8 OF W.S.STREATOR TRUSTEE'S WASHINGTON STREET ALLOTMENT

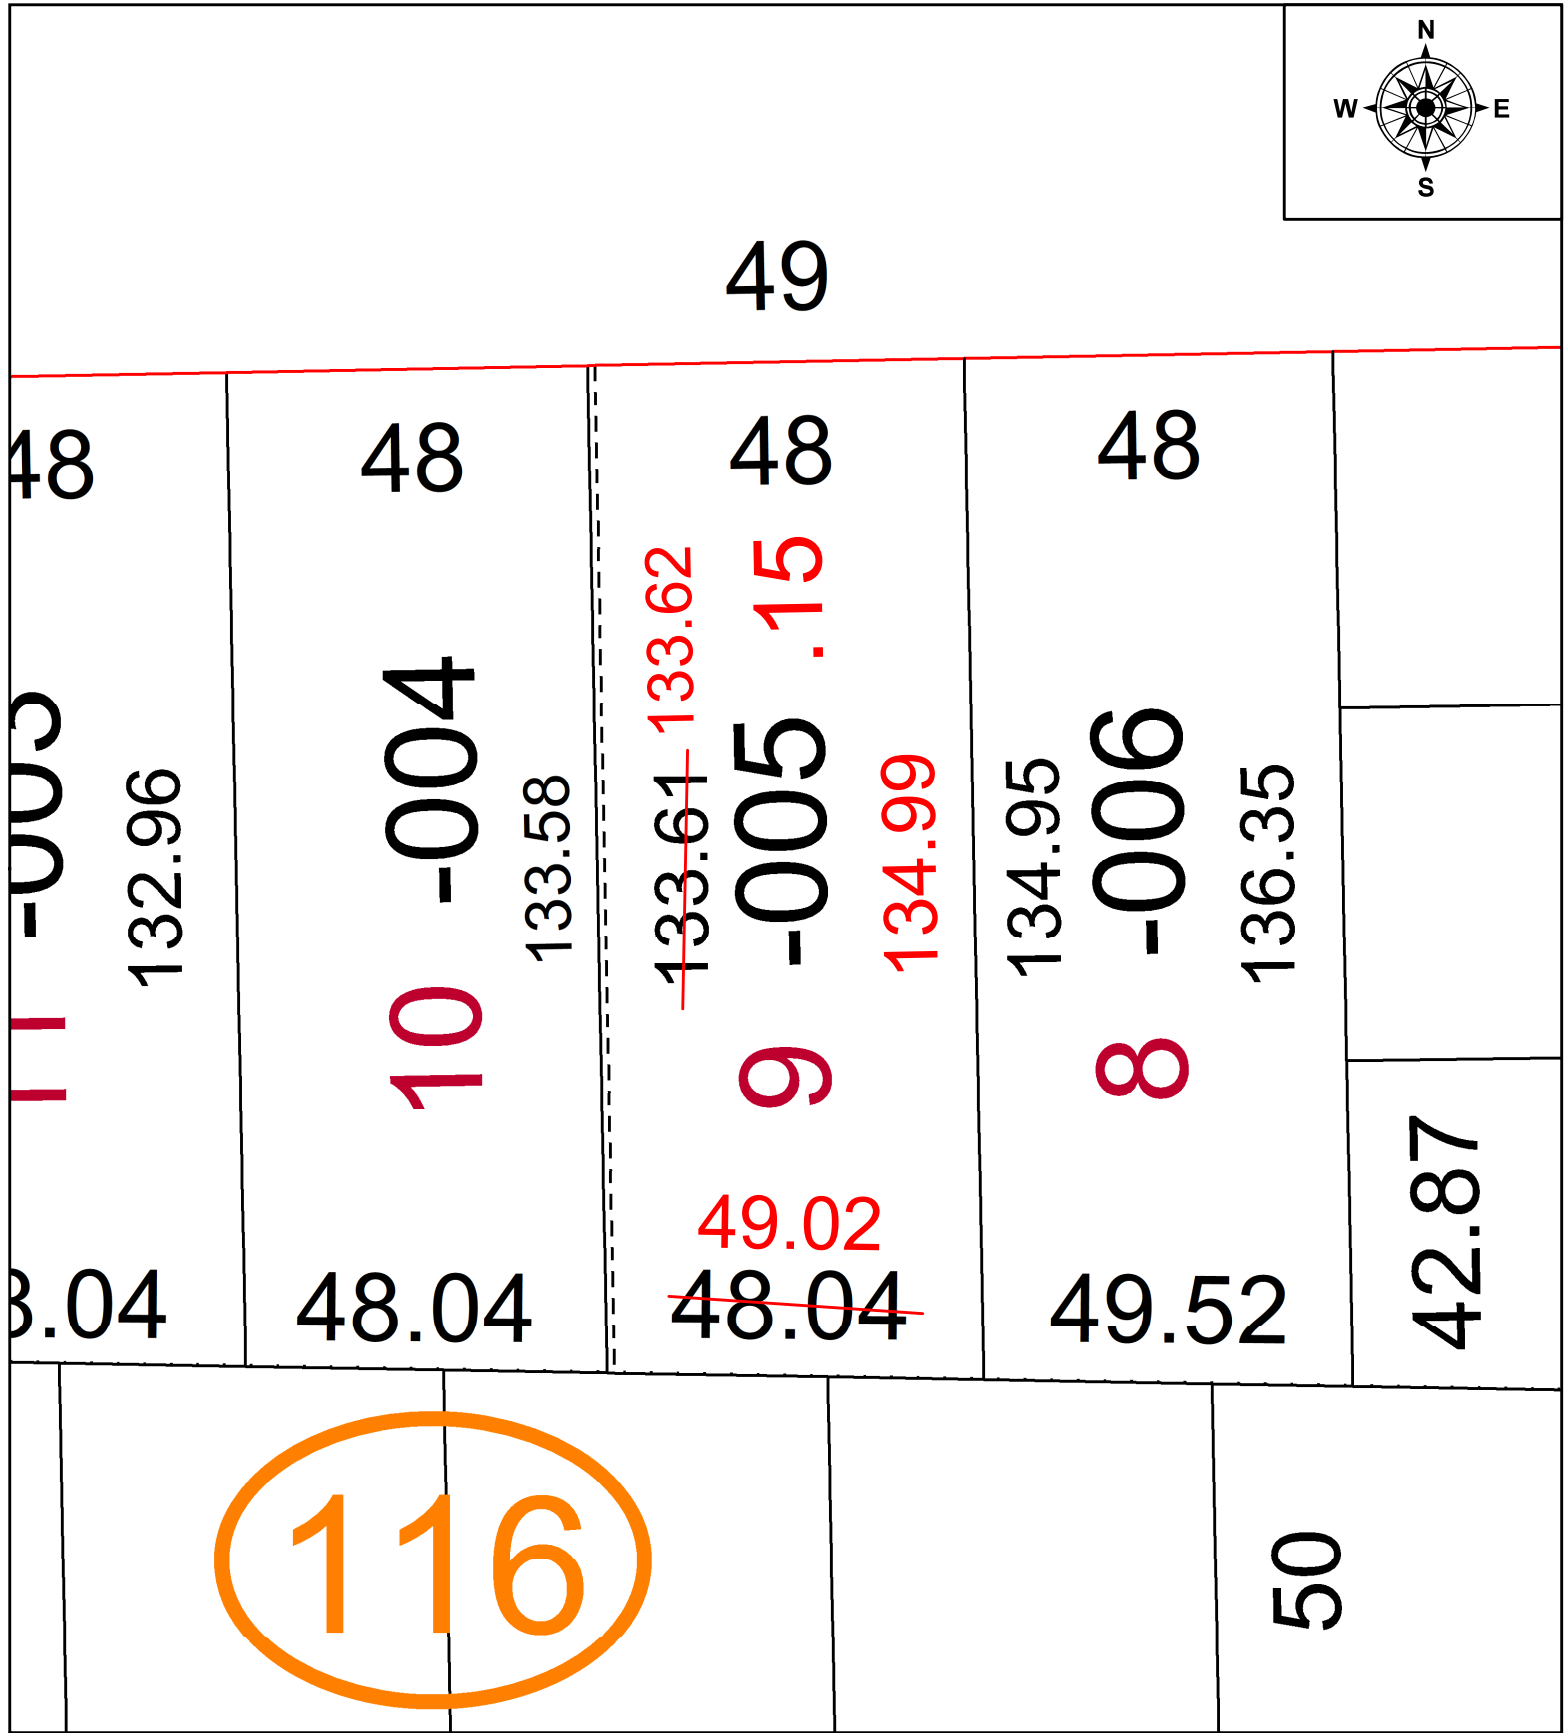

116

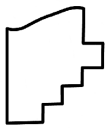

SPLITS/DEEDS PROCESSED
LORAIN COUNTY TAX MAP DEPARTMENT
226 MIDDLE AVE. ELYRIA, OH

SURVEYED BY: THOMAS SIMON
 CLOSURE: 1:152028
 MAP PAGE(S): 02-01-005
 APPROVED BY: DMA DATE: 6/21/2022
 SCALE: 1" = 200' PRIOR INSTRUMENT: 2021-0819781