
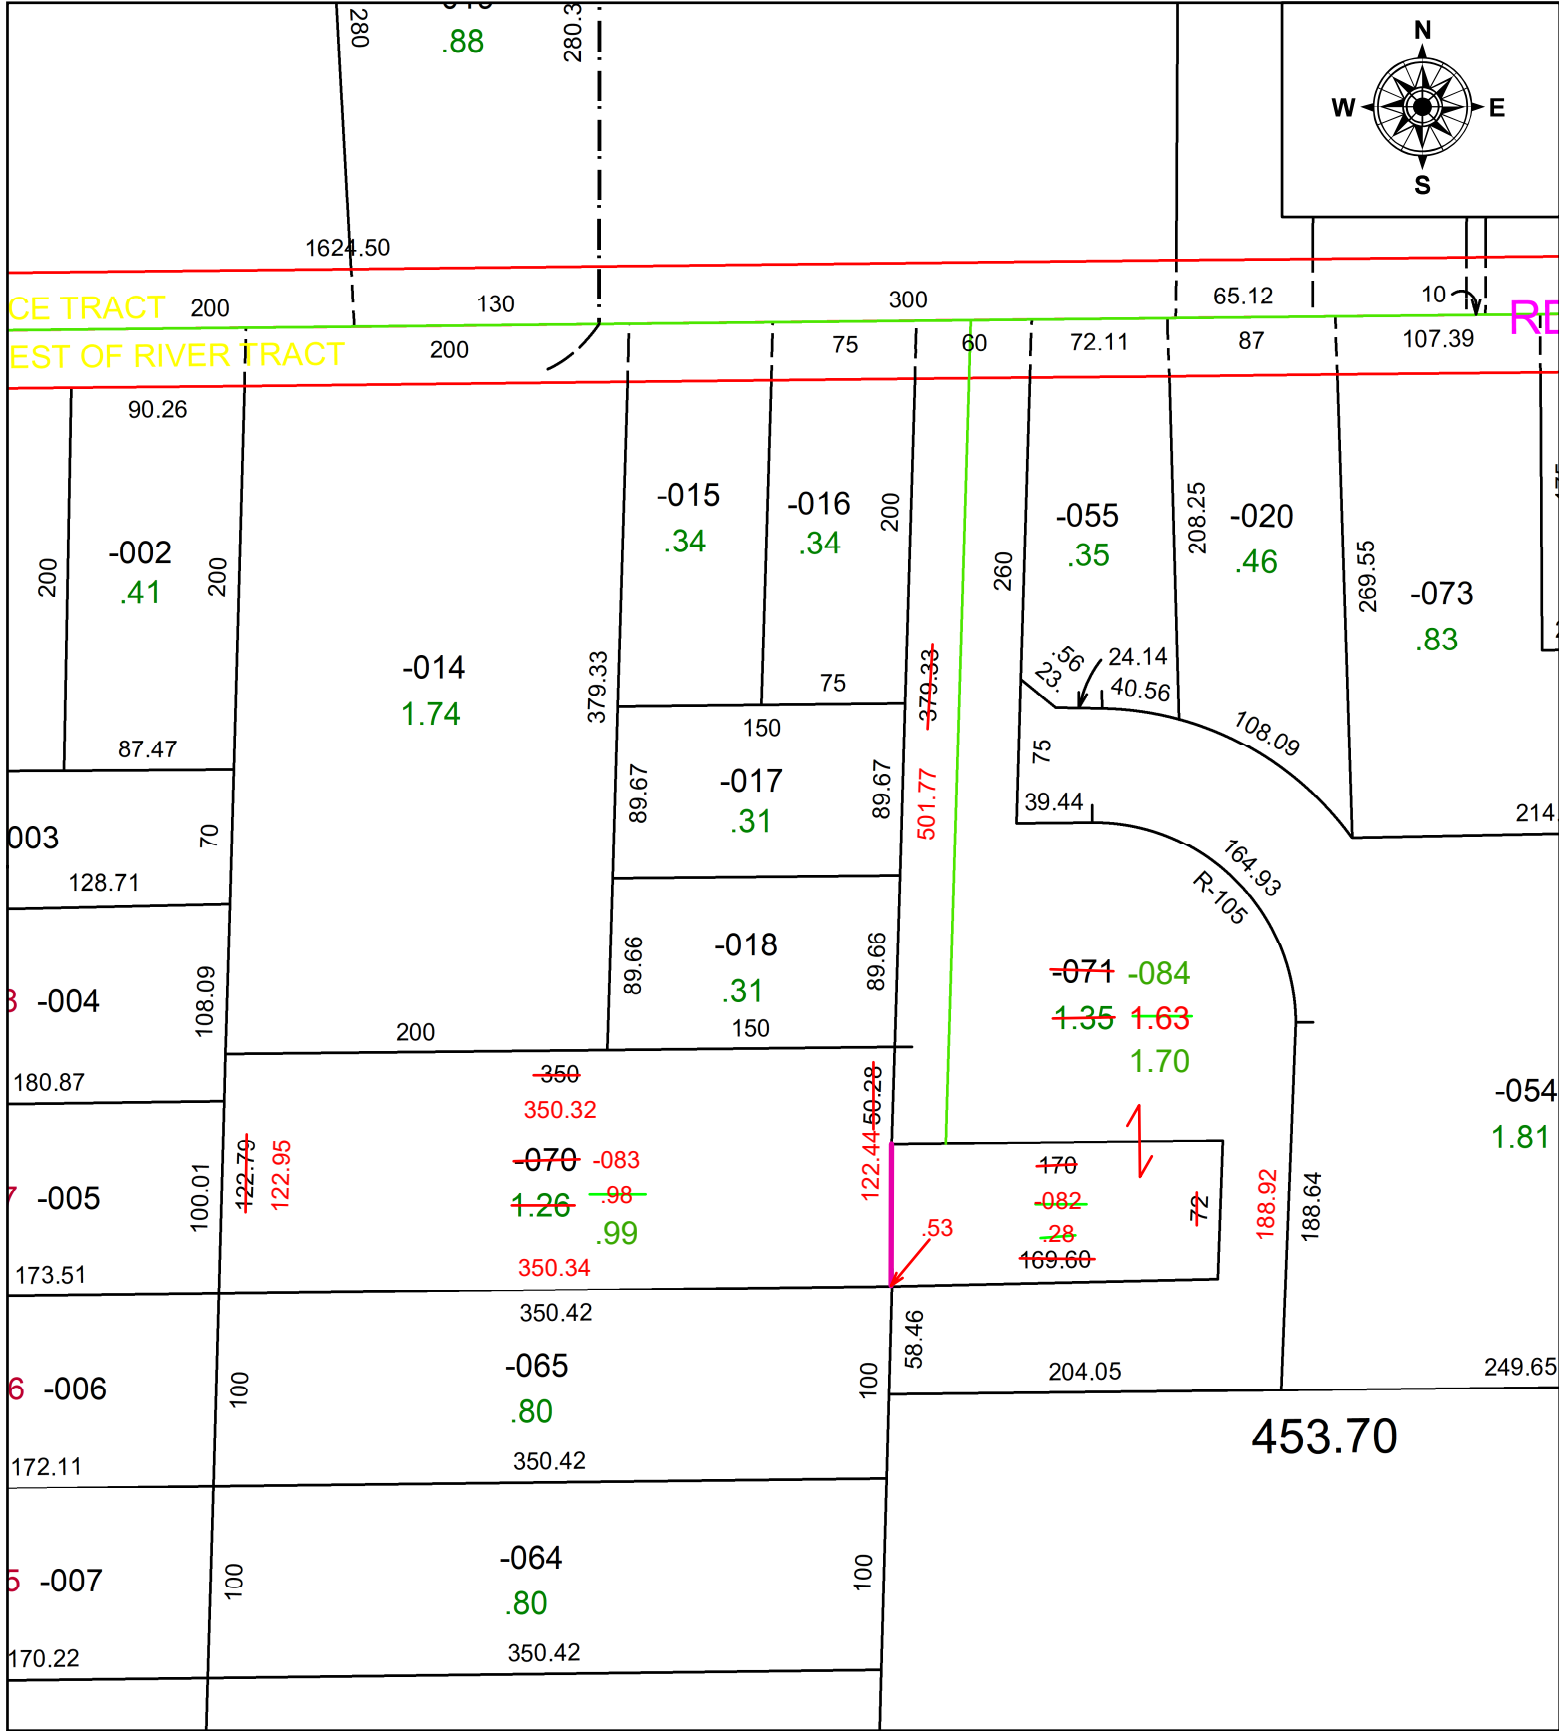


PARENT PARCEL: 06-24-039-000-070 & -071
 CHILD PARCEL: 06-24-039-000-082, -083, & -084
 STARTING POINT: **AC CORR PER SURV BY BRIAN SIEBENTHAL**

24-04885

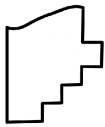

 **SPLITS/DEEDS PROCESSED**
 LORAIN COUNTY TAX MAP DEPARTMENT
 226 MIDDLE AVE. ELYRIA, OH

SURVEYED BY: BRIAN SIEBENTHAL **SURV # 51234**
CLOSURE: 1: INF
MAP PAGE(S): 06-24
APPROVED BY: AC **DATE:** July 24, 2024
SCALE: 1 in = 100 ft **PRIOR INSTRUMENT:** 2022- 0882221