
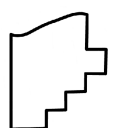
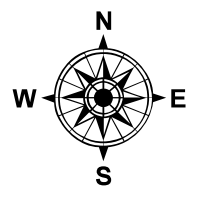


PARENT PARCEL: 15-00-008-000-010

CHILD PARCEL: 15-00-008-000-029 & -030

STARTING POINT: NW CORNER OF O/L 8 AND C/L OF WHEELER RD

24-04887

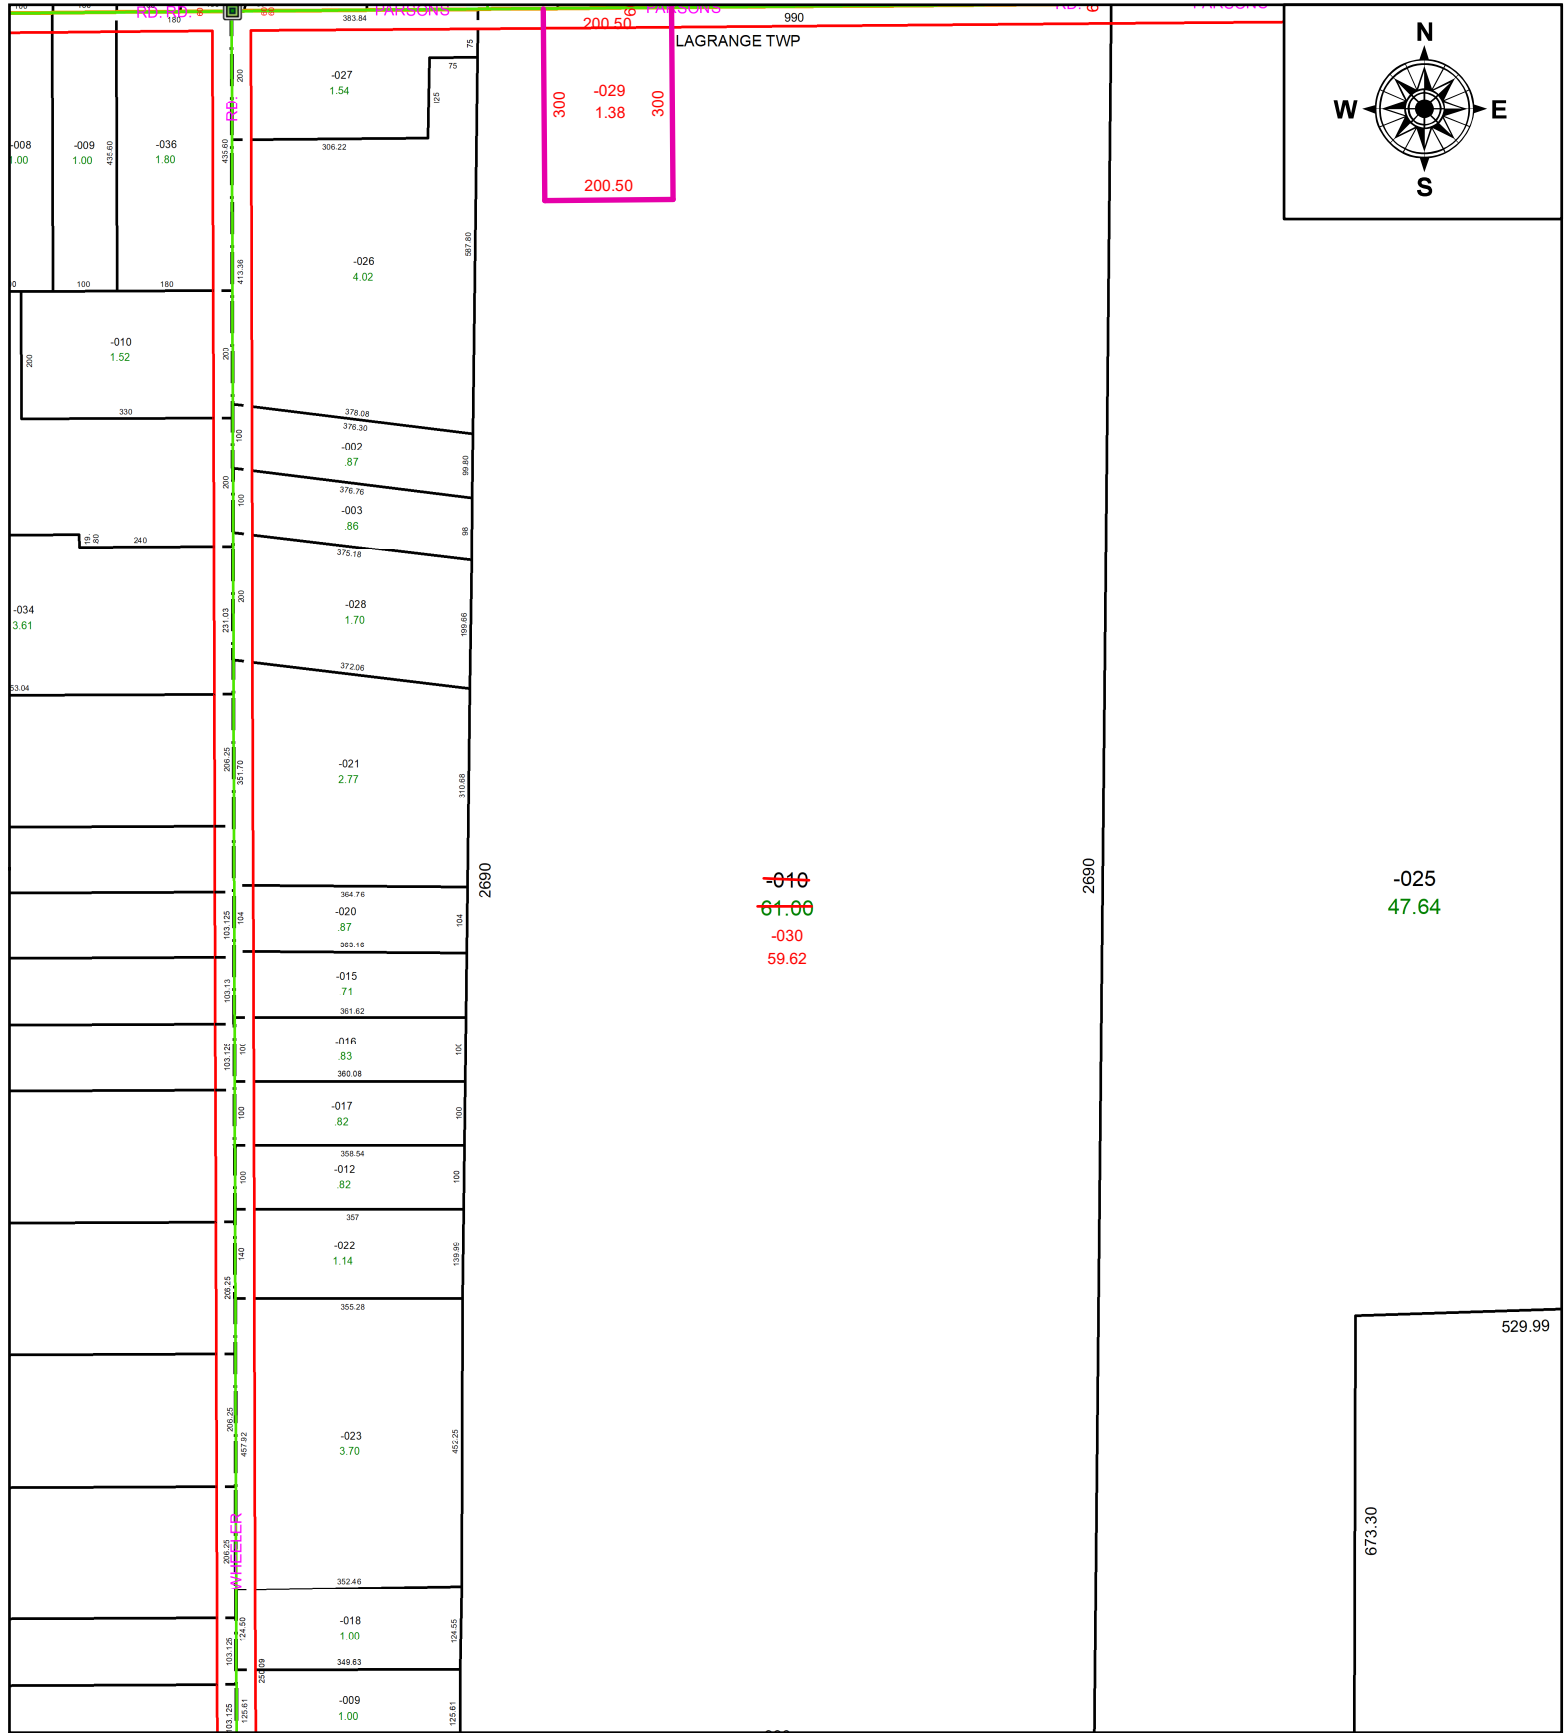

SPLITS/DEEDS PROCESSED
 LORAIN COUNTY TAX MAP DEPARTMENT
 226 MIDDLE AVE. ELYRIA, OH

SURVEYED BY: TIMOTHY D. HOZALSKI **SURV # 51239**
CLOSURE: 1: INF
MAP PAGE(S): 15-00-008
APPROVED BY: AC **DATE:** July 26, 2024
SCALE: 1 in = 300 ft **PRIOR INSTRUMENT:** 2007- 0227007