


PARENT PARCEL: 04-00-001-103-073

CHILD PARCEL: **AC. CORR. PER SURVEY TIMOTHY HOZALSKI**

STARTING POINT: CL OF DETROIT RD. & MOON RD.

22-04889-C

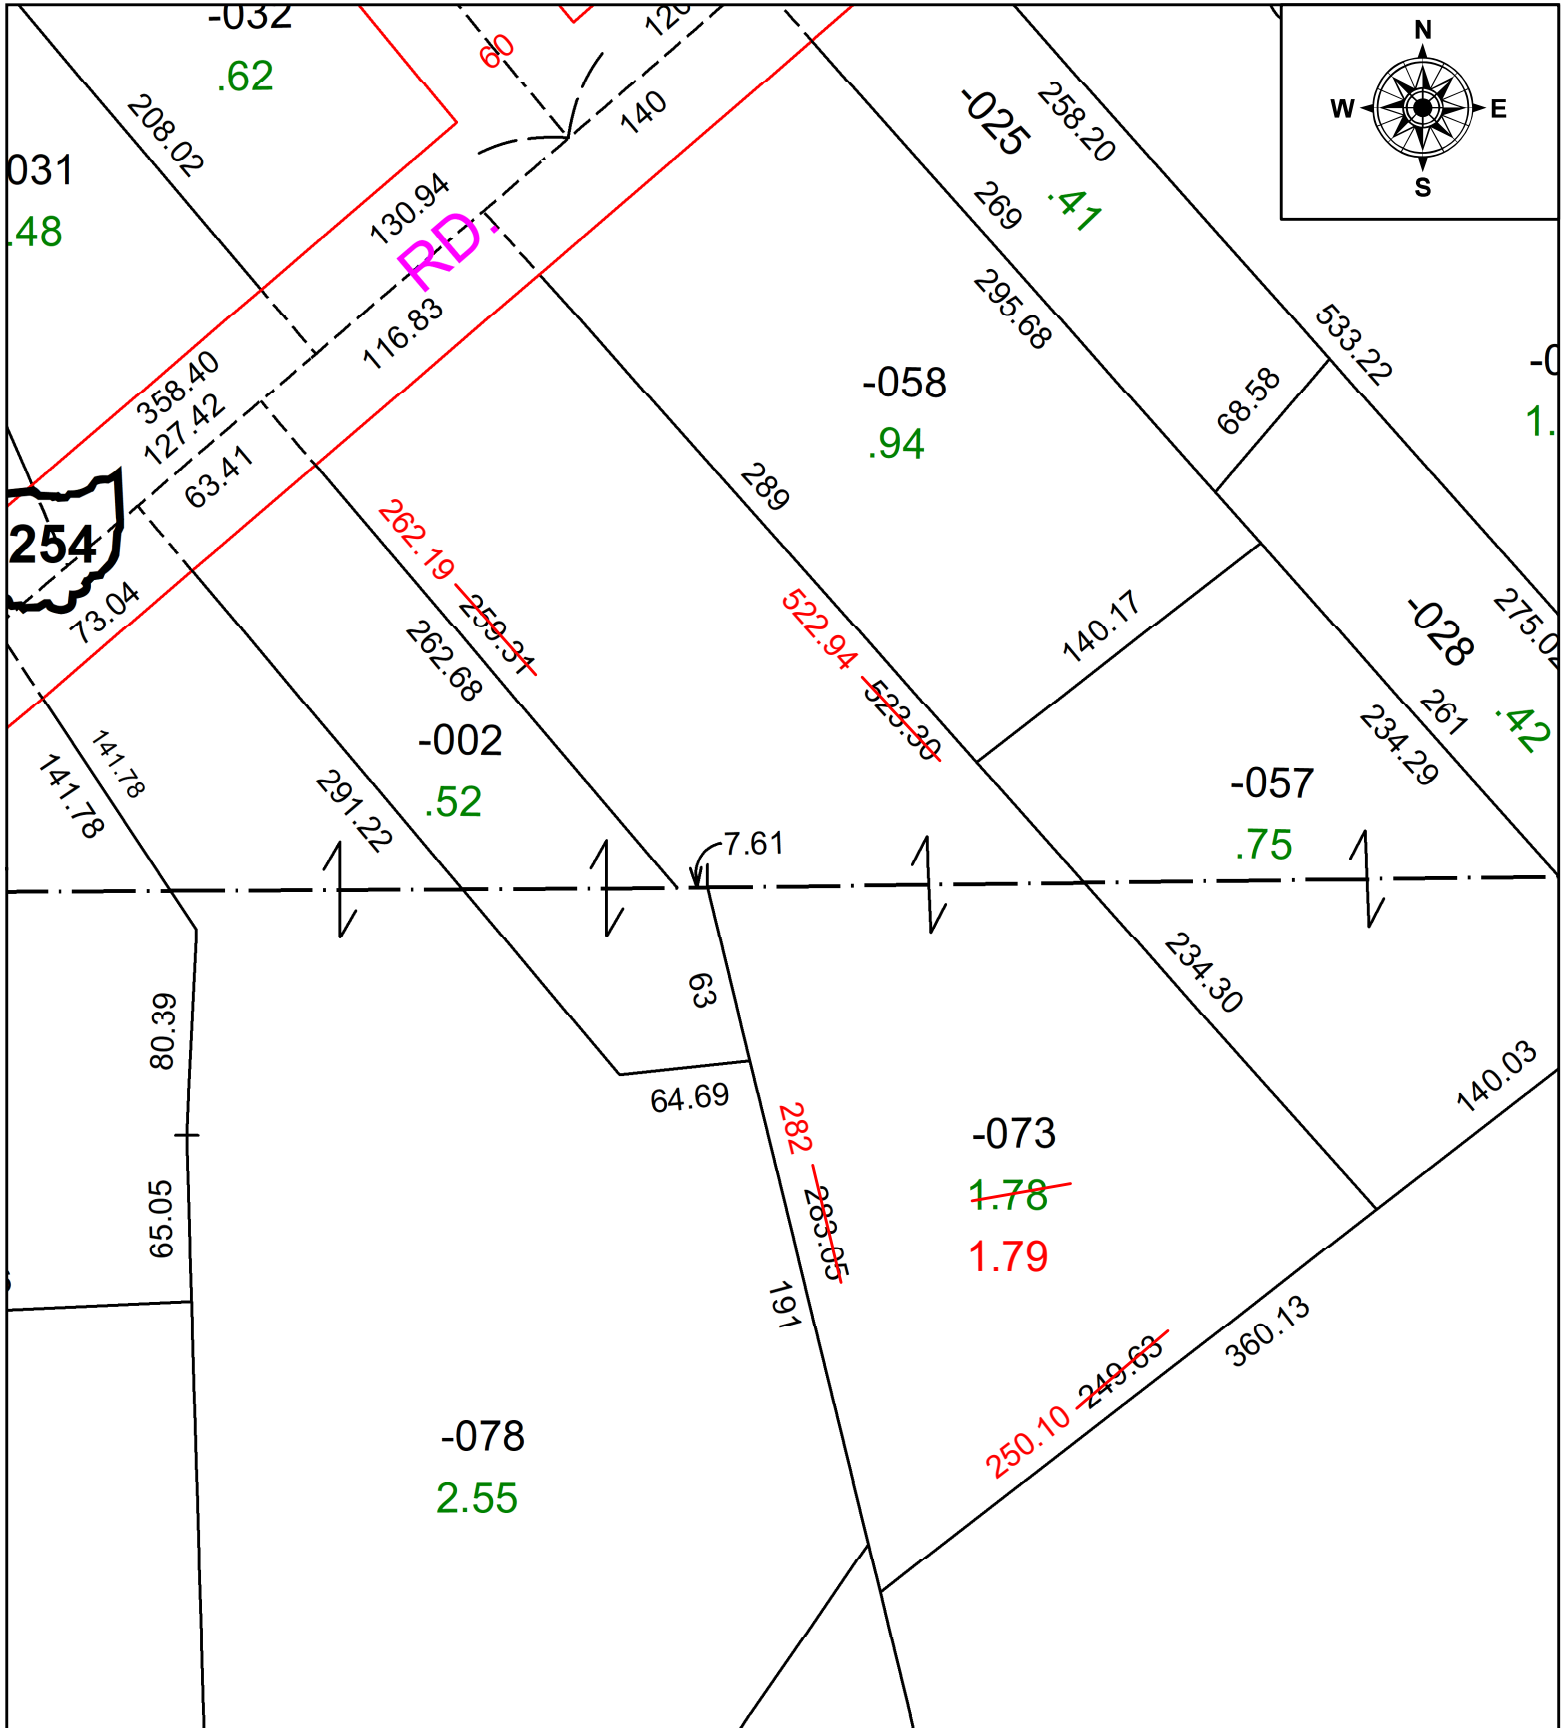

SPLITS/DEEDS PROCESSED
 LORAIN COUNTY TAX MAP DEPARTMENT
 226 MIDDLE AVE. ELYRIA, OH

SURVEYED BY: TIMOTHY HOZALSKI
 CLOSURE: 1:434784
 MAP PAGE(S): 04-00-001
 APPROVED BY: DMA DATE: 7/1/2022
 SCALE: 1" = 75' PRIOR INSTRUMENT: 2012-0432839