
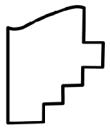


PARENT PARCEL: 03-00-108-111-001 and 03-00-108-111-071

CHILD PARCEL: 03-00-108-111-082

STARTING POINT: NORTHWESTERLY CORNER OF SUBLOT 297 IN BROADWAY GARDENS

24-04889

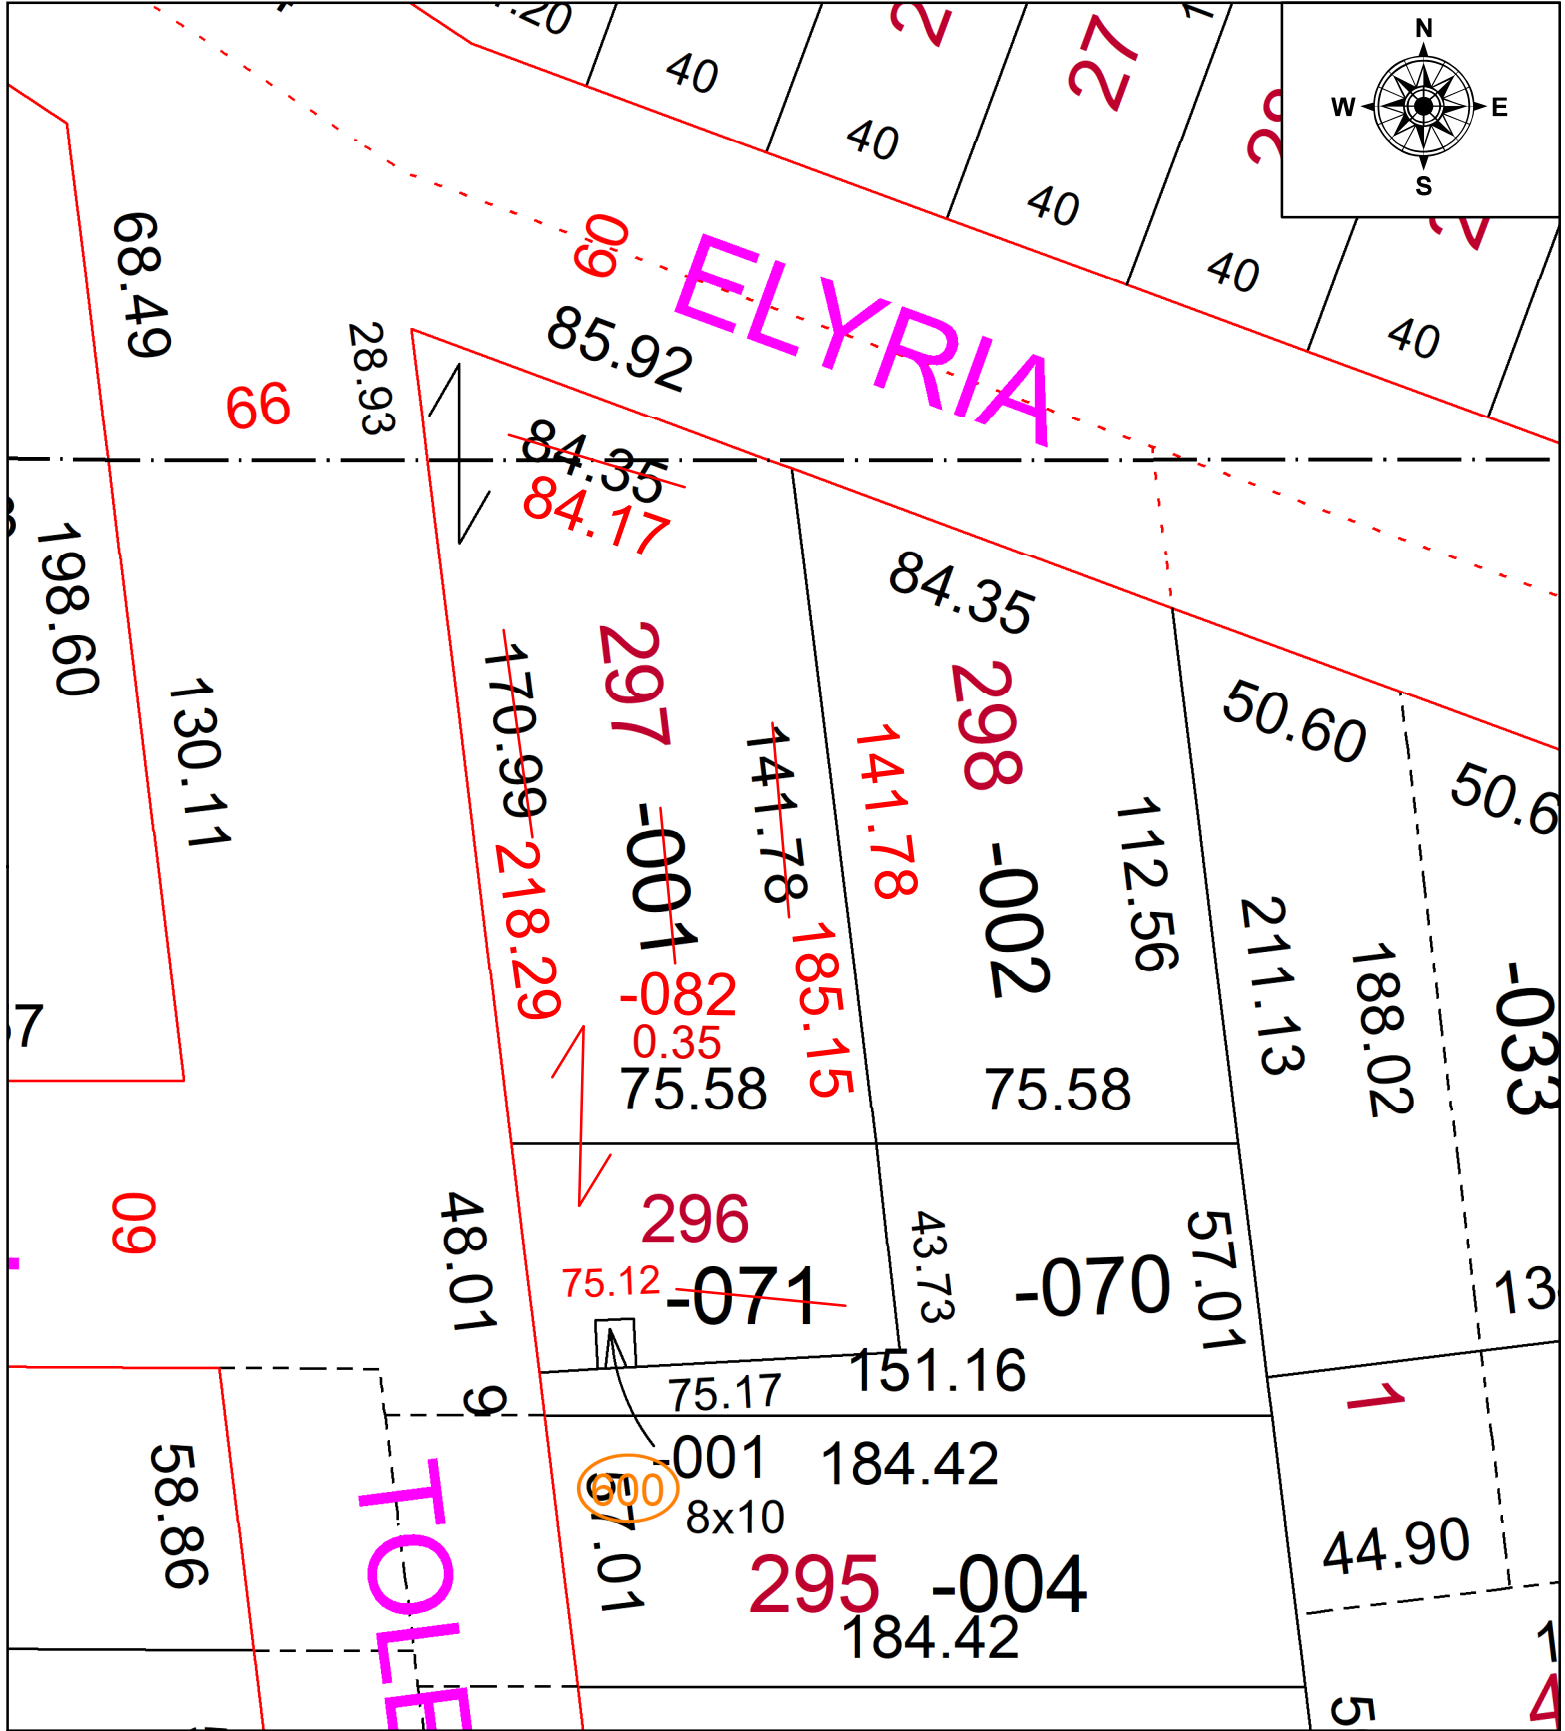

SPLITS/DEEDS PROCESSED
 LORAIN COUNTY TAX MAP DEPARTMENT
 226 MIDDLE AVE. ELYRIA, OH

SURVEYED BY: THOMAS A. SIMON SURVEY #: 51245
 CLOSURE: 1: 478943
 MAP PAGE(S): 0300108
 APPROVED BY: BB DATE: 8/2/2024
 SCALE: 1" = 40' PRIOR INSTRUMENT: #20170653729