
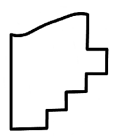
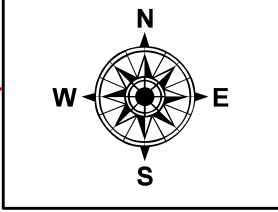


PARENT PARCEL: 01-00-027-000-008 & -025

CHILD PARCEL: **AC. CORR. PER SURVEY SCOTT CASEY**

STARTING POINT: N.E. CORNER OF O.L. 38

22-04892-A

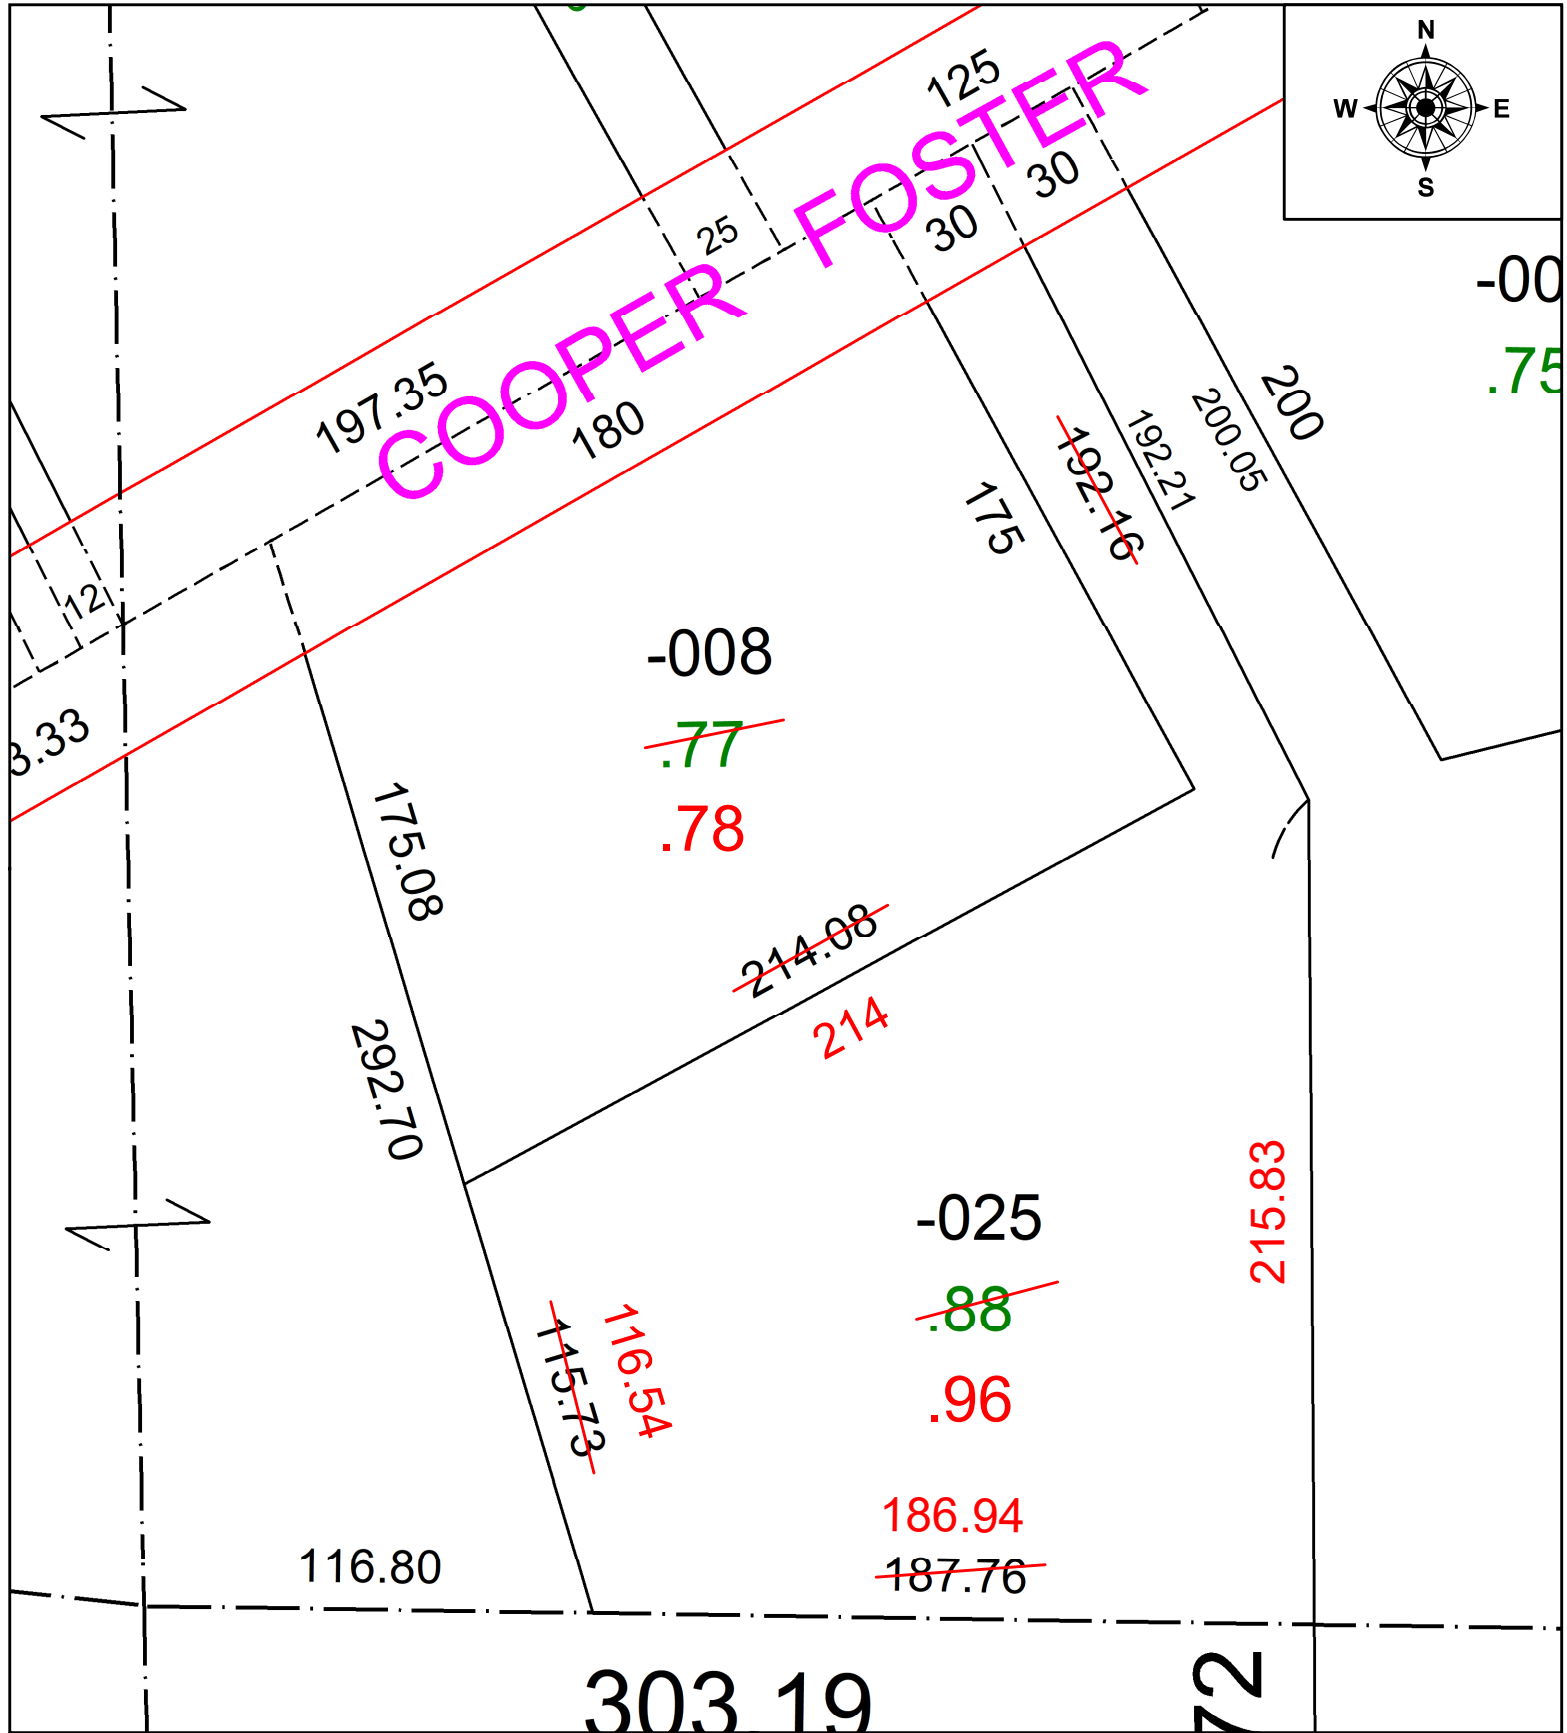

**SPLITS/DEEDS PROCESSED**  
 LORAIN COUNTY TAX MAP DEPARTMENT  
 226 MIDDLE AVE. ELYRIA, OH

SURVEYED BY: SCOTT CASEY  
 CLOSURE: 1: 166531  
 MAP PAGE(S): 01-00-027  
 APPROVED BY: DMA DATE: 7/6/2022  
 SCALE: 1" = 50' PRIOR INSTRUMENT: 2014-0508301