
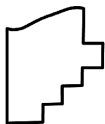
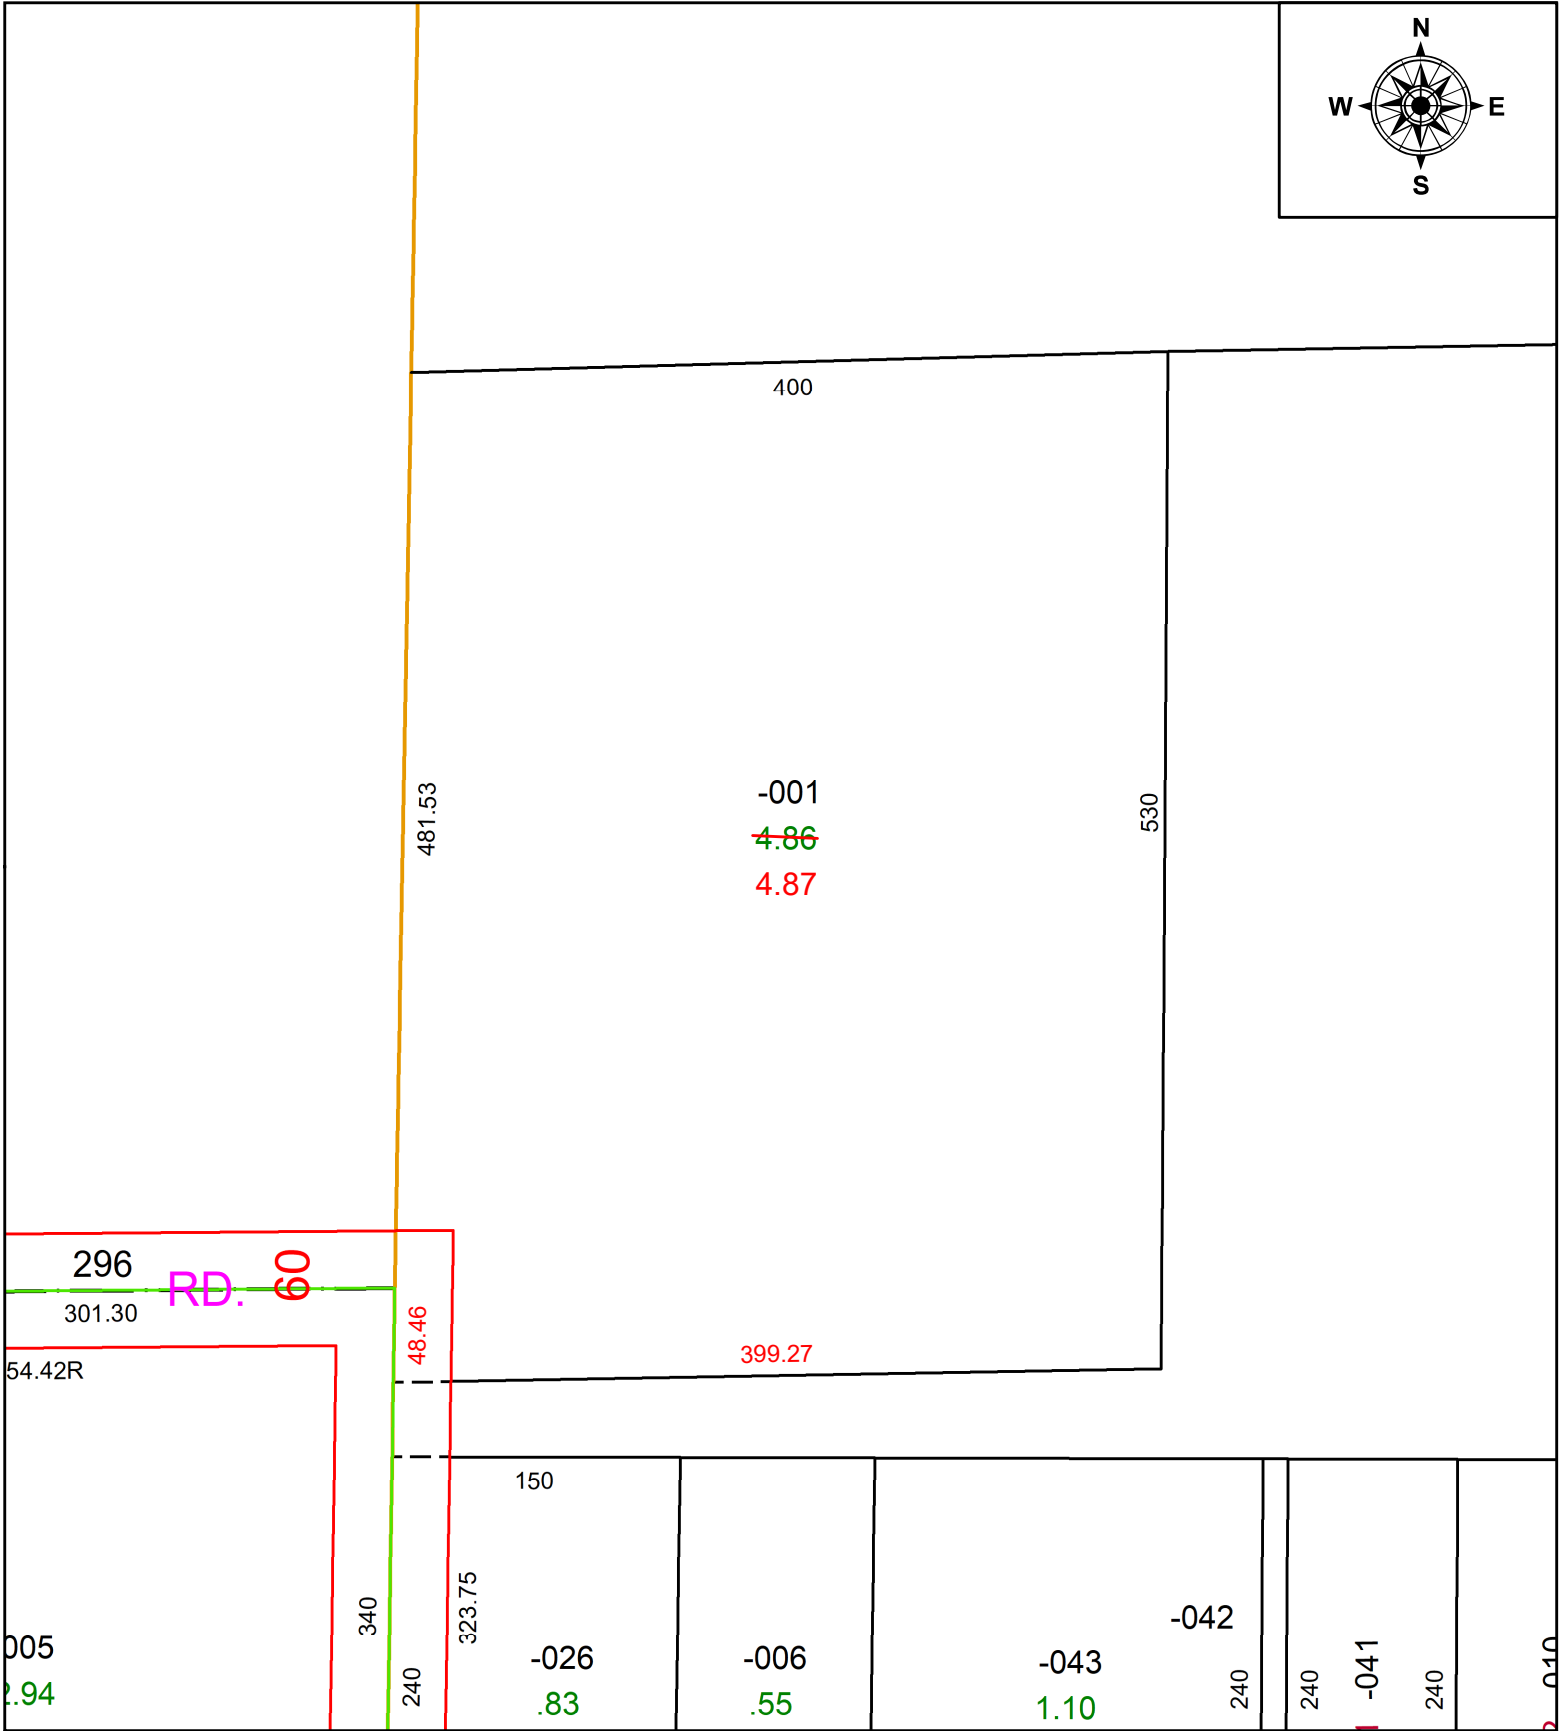


PARENT PARCEL: 15-00-020-000-001

CHILD PARCEL: **AC CORR PER PRIOR DEED**

STARTING POINT: C/L OF DIAGONAL AND KIPTON-NICKLE PLATE RD

22-04894-A

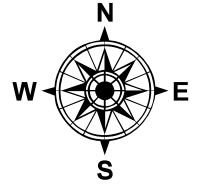

SPLITS/DEEDS PROCESSED
 LORAIN COUNTY TAX MAP DEPARTMENT
 226 MIDDLE AVE. ELYRIA, OH

SURVEYED BY: _____ N/A
 CLOSURE: _____ N/A
 MAP PAGE(S): _____ 15-00-020
 APPROVED BY: _____ AC DATE: July 06, 2022
 SCALE: _____ 1" = 100 _____ PRIOR INSTRUMENT: _____ 1996- 0443299