


PARENT PARCEL: 01-00-002-102-025, -026, & -057

CHILD PARCEL: 01-00-002-102-064

STARTING POINT: INTERSECTION OF C/L'S OF FAIRFAX RD & EDGEWATER DR

24-04896

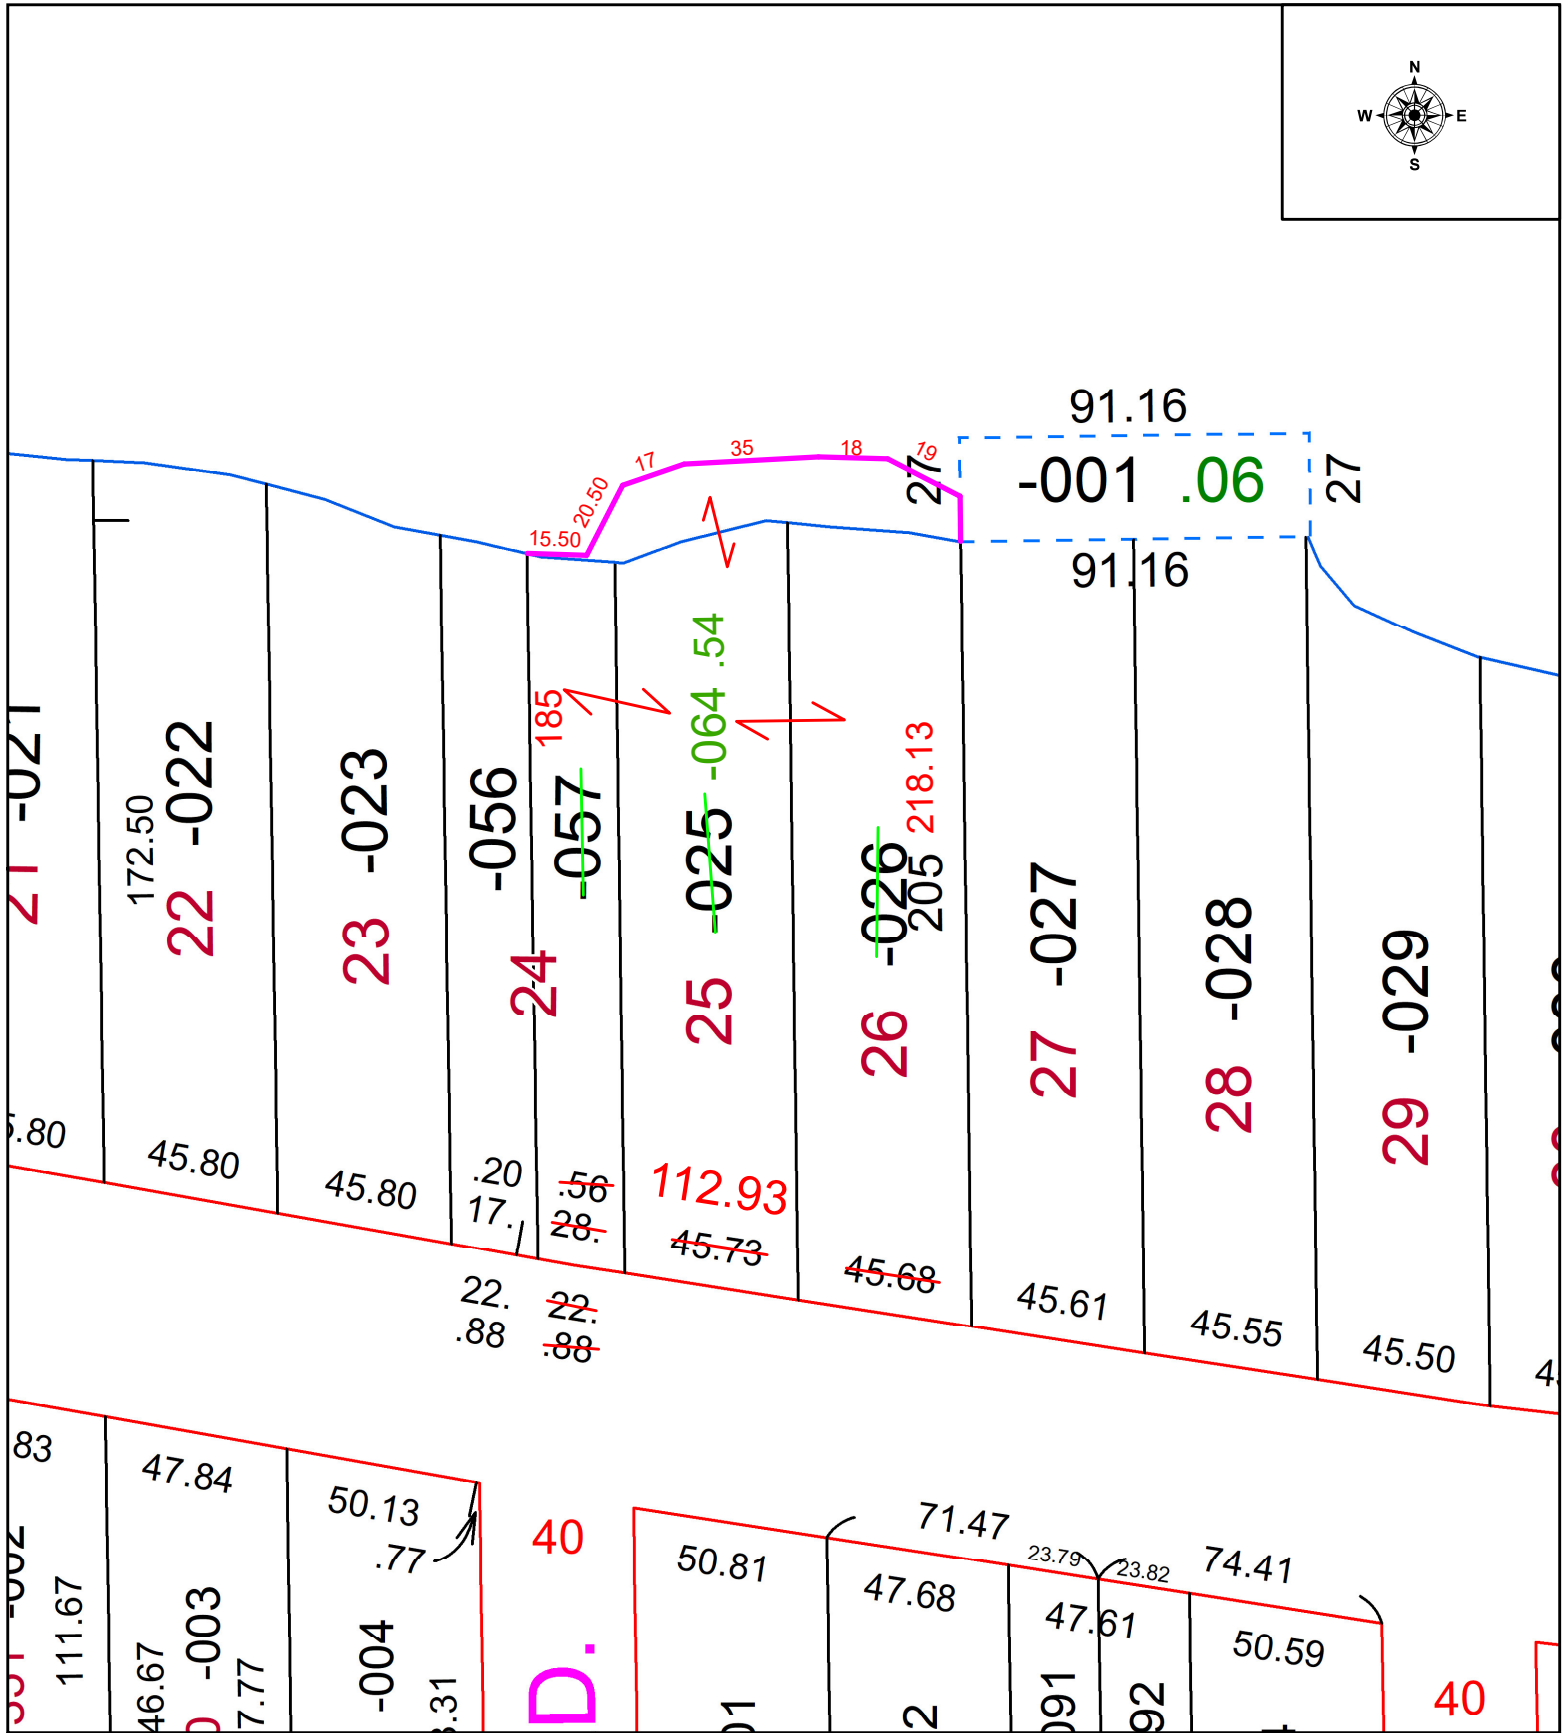

SPLITS/DEEDS PROCESSED
 LORAIN COUNTY TAX MAP DEPARTMENT
 226 MIDDLE AVE. ELYRIA, OH

SURVEYED BY: MICHAEL SPELLACY SURVEY # 51262
 CLOSURE: 1: 206217
 MAP PAGE(S): 01-00-002
 APPROVED BY: WRZ DATE: 8/29/2024
 SCALE: 1" = 50' PRIOR INSTRUMENT: #2017-0652694