
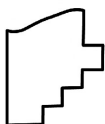


PARENT PARCEL: 21-02-012-000-017

CHILD PARCEL: 21-02-012-000-019 & -020

STARTING POINT: INTERSECTION OF NORTHWESTERLY CORNER OF O.L. 12 & C/L OF CLARK RD

24-04897

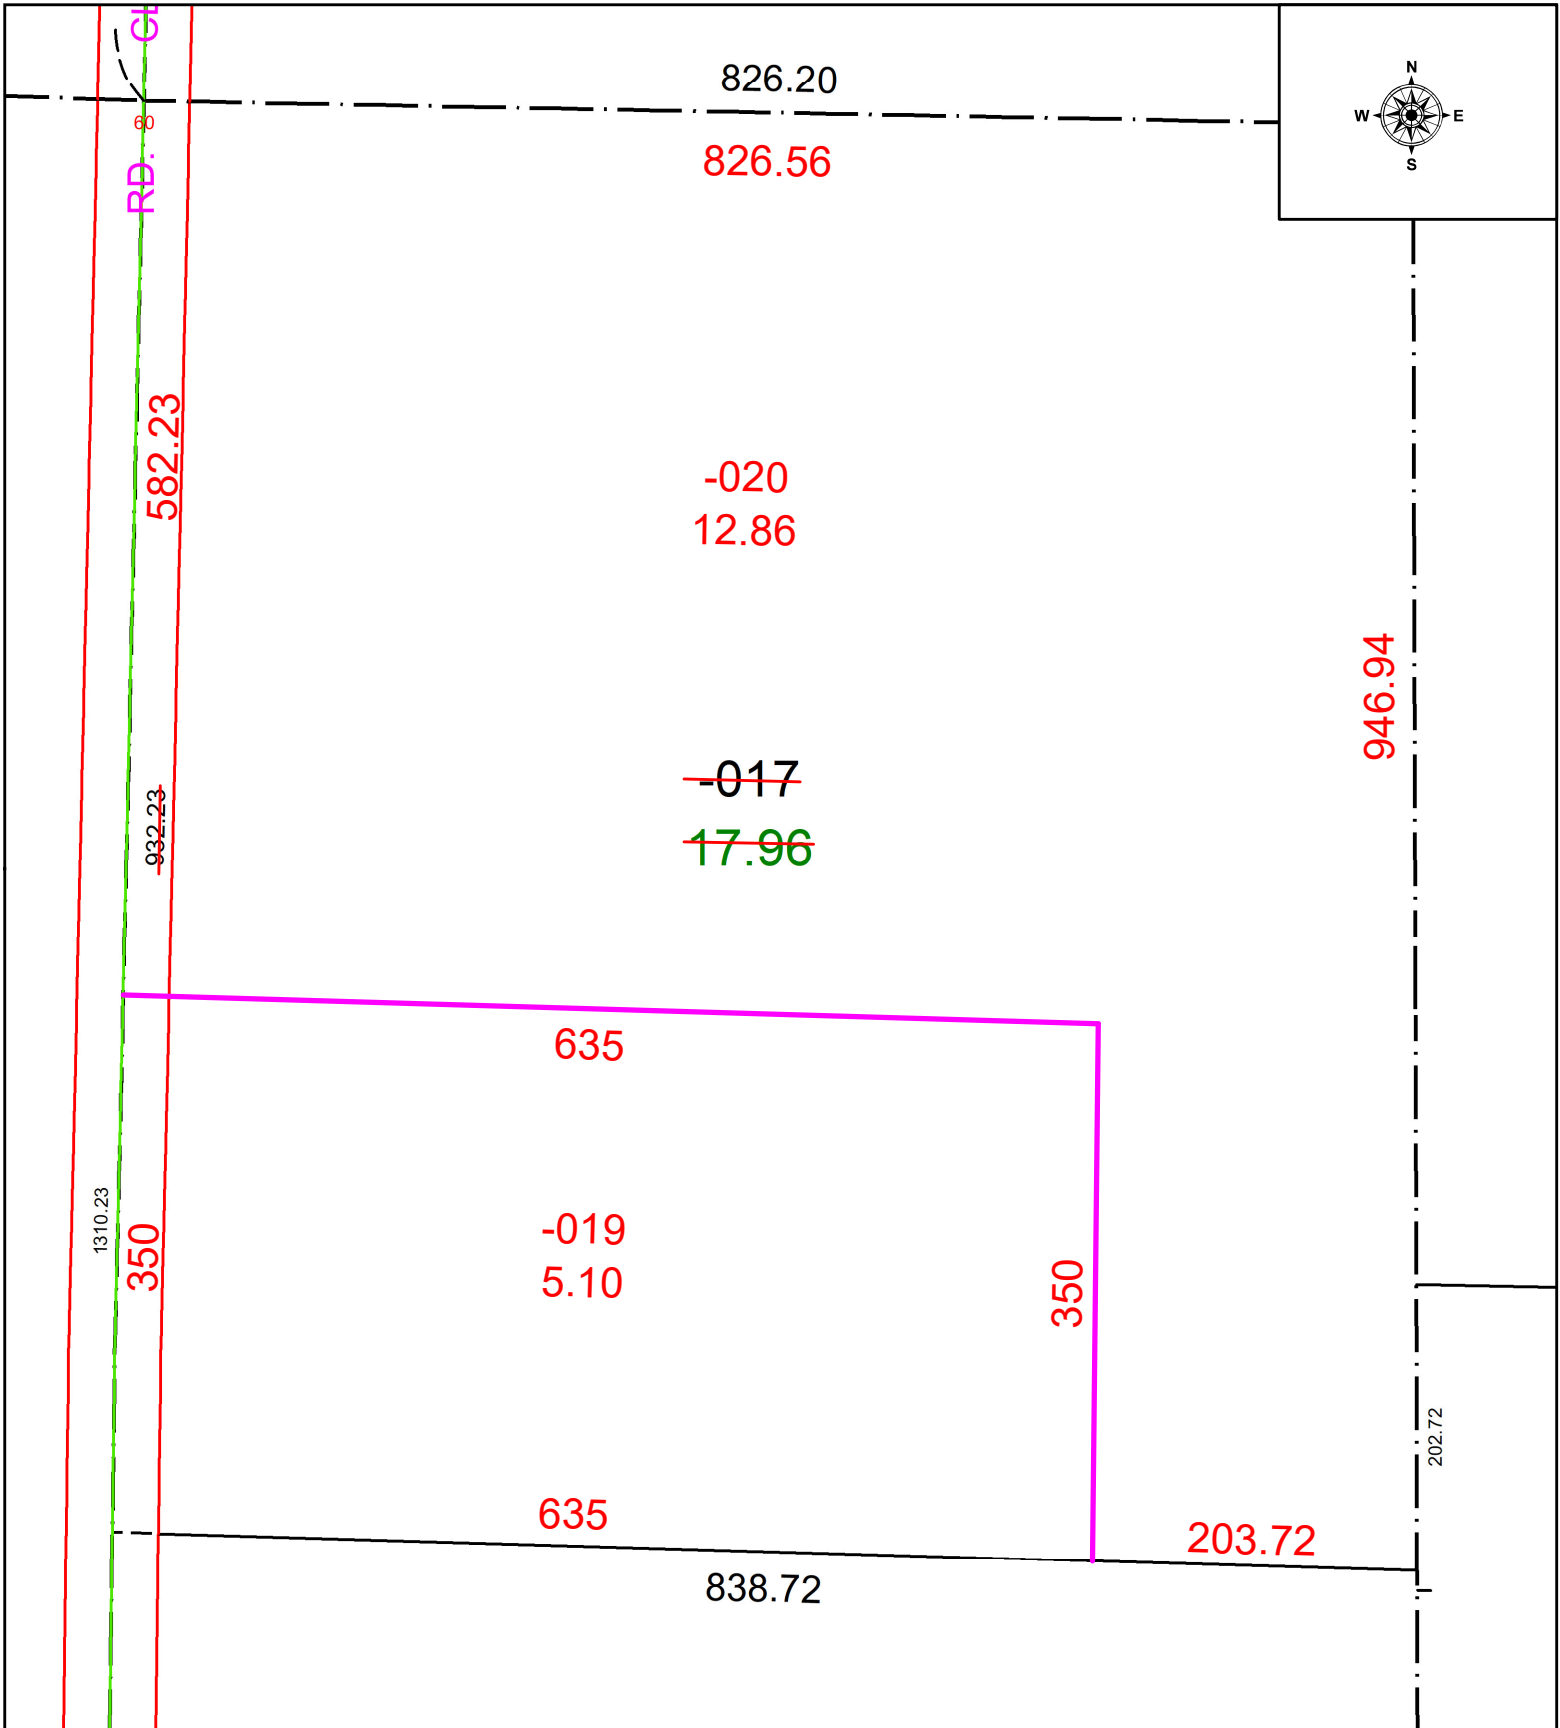

**SPLITS/DEEDS PROCESSED**  
 LORAIN COUNTY TAX MAP DEPARTMENT  
 226 MIDDLE AVE. ELYRIA, OH

SURVEYED BY: THOMAS SNEZEK SURVEY # 51258  
 CLOSURE: 1: INF  
 MAP PAGE(S): 21-02-012  
 APPROVED BY: WRZ DATE: 8/27/2024  
 SCALE: 1" = 125' PRIOR INSTRUMENT: #2015-0553346