


PARENT PARCEL: 10-00-009-110-011, -012, & -027

CHILD PARCEL: 10-00-009-110-032

STARTING POINT:

24-04901

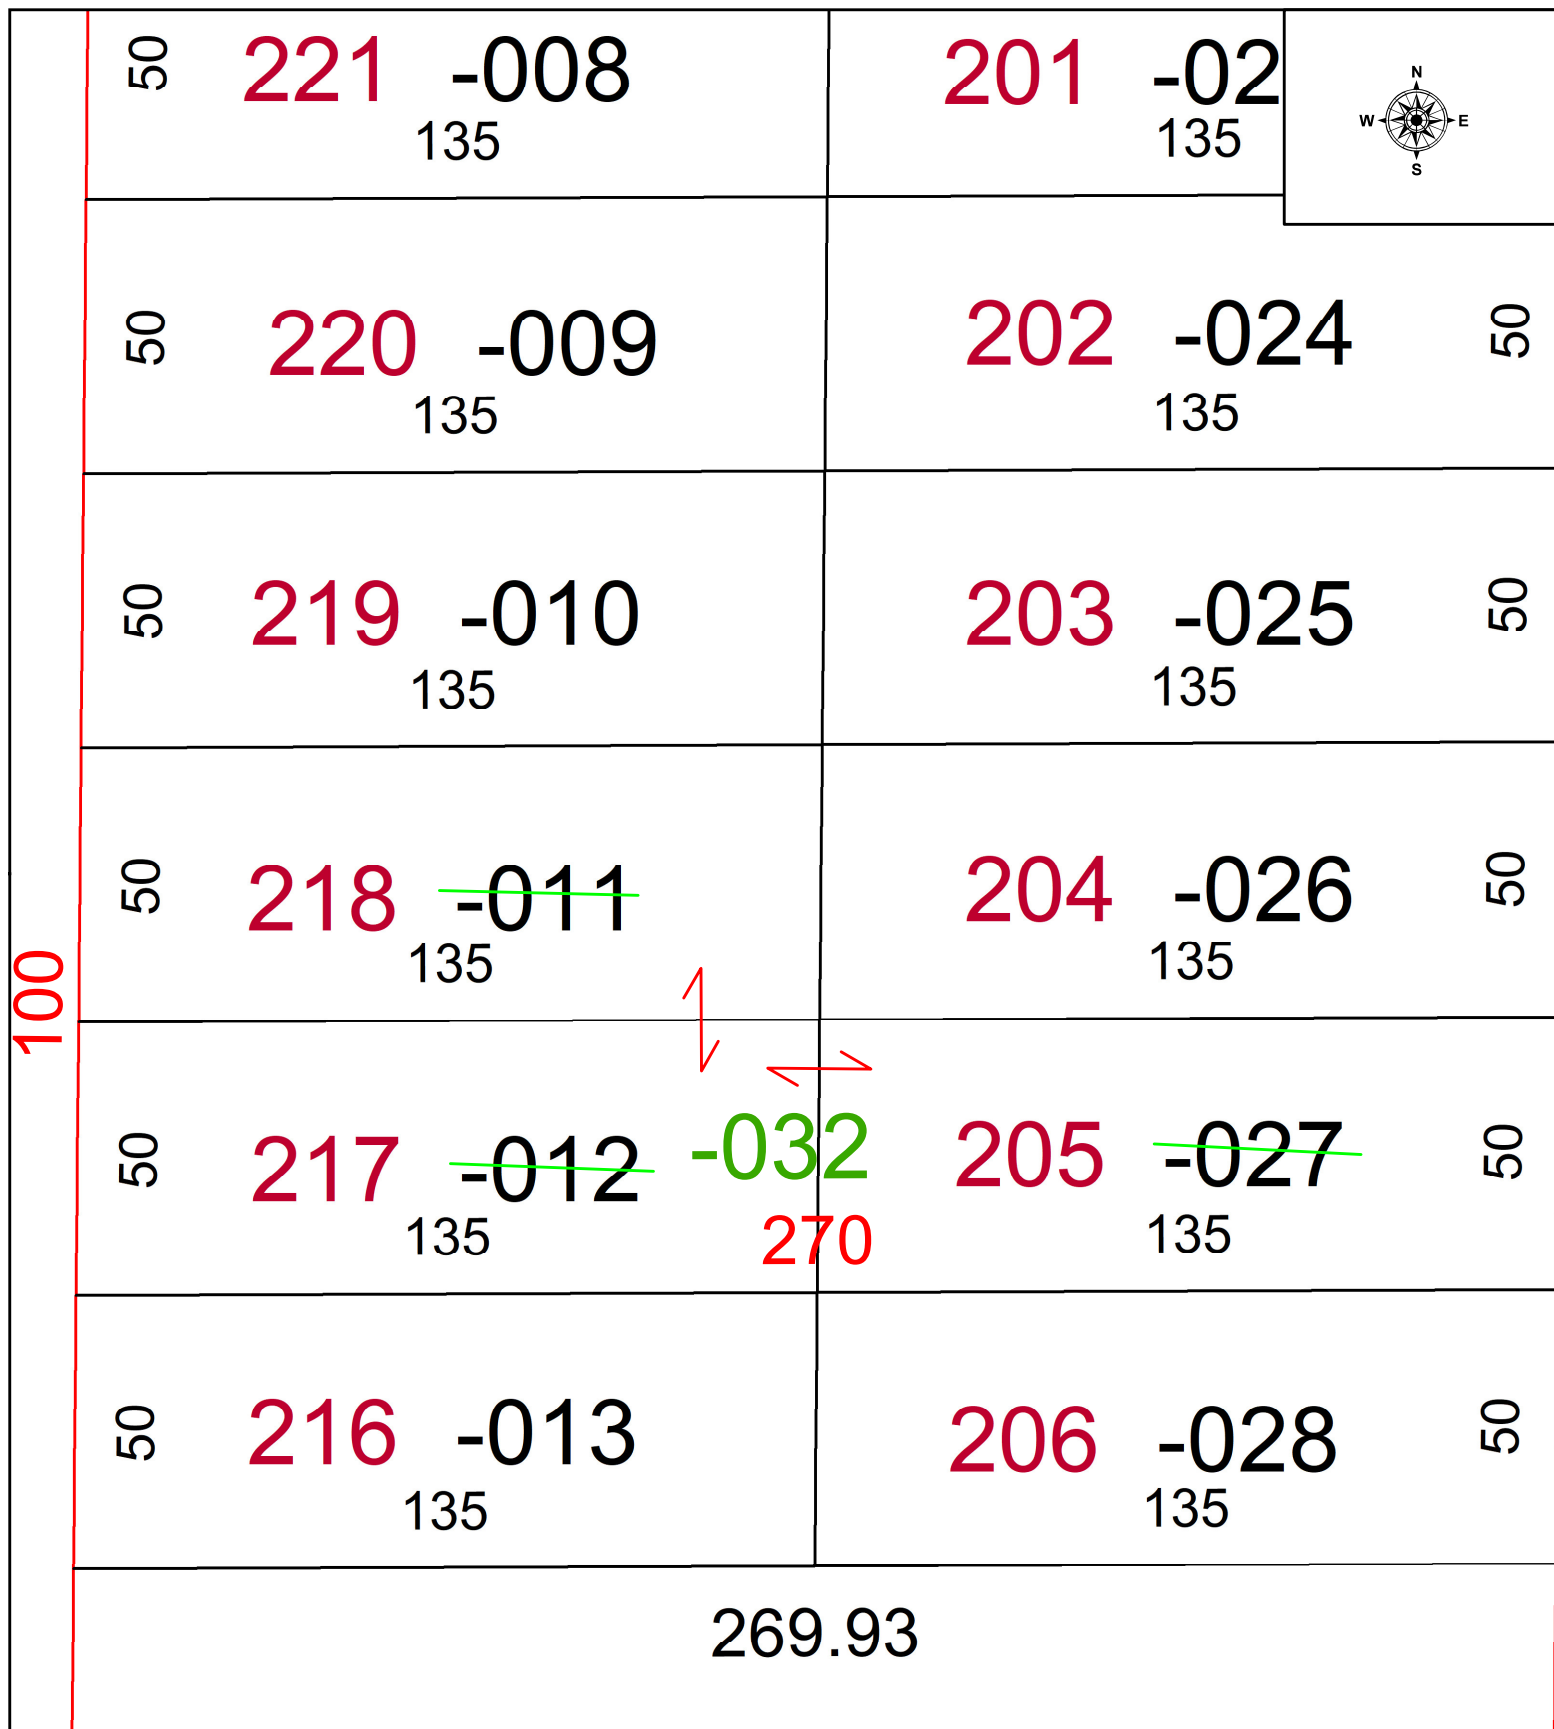


100

↕

↙ ↘

**-032**  
**270**

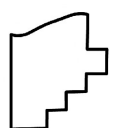

**SPLITS/DEEDS PROCESSED**  
 LORAIN COUNTY TAX MAP DEPARTMENT  
 226 MIDDLE AVE. ELYRIA, OH

SURVEYED BY: \_\_\_\_\_ N/A SURVEY # N/A  
 CLOSURE: \_\_\_\_\_ 1: N/A  
 MAP PAGE(S): \_\_\_\_\_ 10-00-009  
 APPROVED BY: \_\_\_\_\_ WRZ DATE: 9/9/2024  
 SCALE: 1" = 35' PRIOR INSTRUMENT: #2024-0020855