


PARENT PARCEL: 03-00-046-103-031

CHILD PARCEL: 03-00-046-103-064, -065, & -066

ACREAGE CORRECTION PER NORMAN HURA

22-04902-C

STARTING POINT: INTERSECTION OF C/L OF ROOT RD & NORTH LINE OF LANDS OF KENNETH J. AFRATES & JOYCE M. AFRATES IN DV 955/700

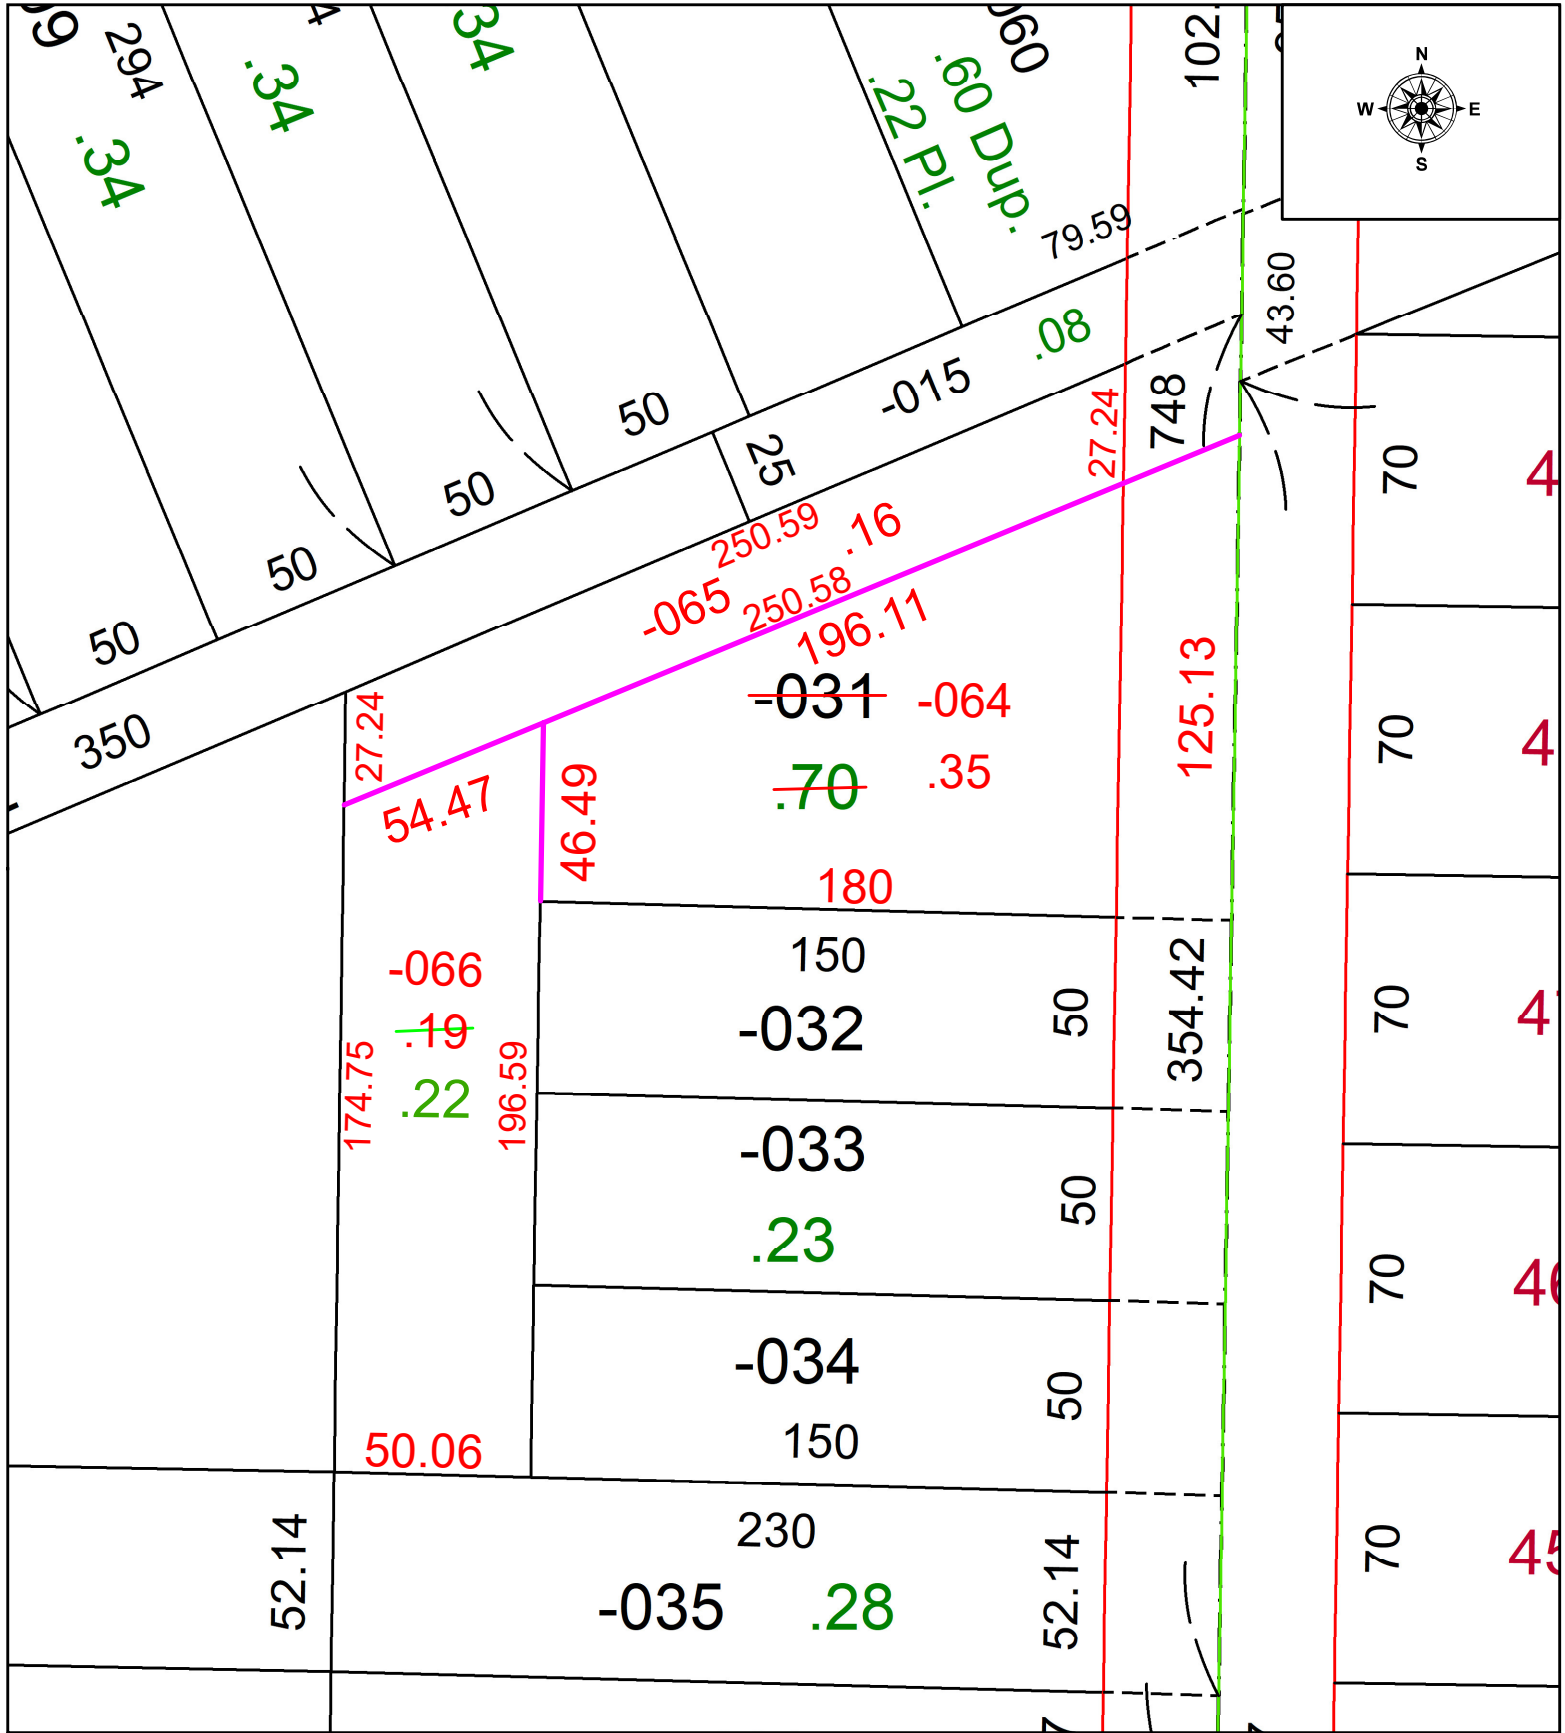

SPLITS/DEEDS PROCESSED
 LORAIN COUNTY TAX MAP DEPARTMENT
 226 MIDDLE AVE. ELYRIA, OH

SURVEYED BY: NORMAN HURA SURVEY # 50640
 CLOSURE: 1:17864
 MAP PAGE(S): 03-00-046
 APPROVED BY: WRZ DATE: 7/15/2022
 SCALE: 1" = 50 PRIOR INSTRUMENT: 2004-0032825