
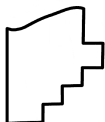
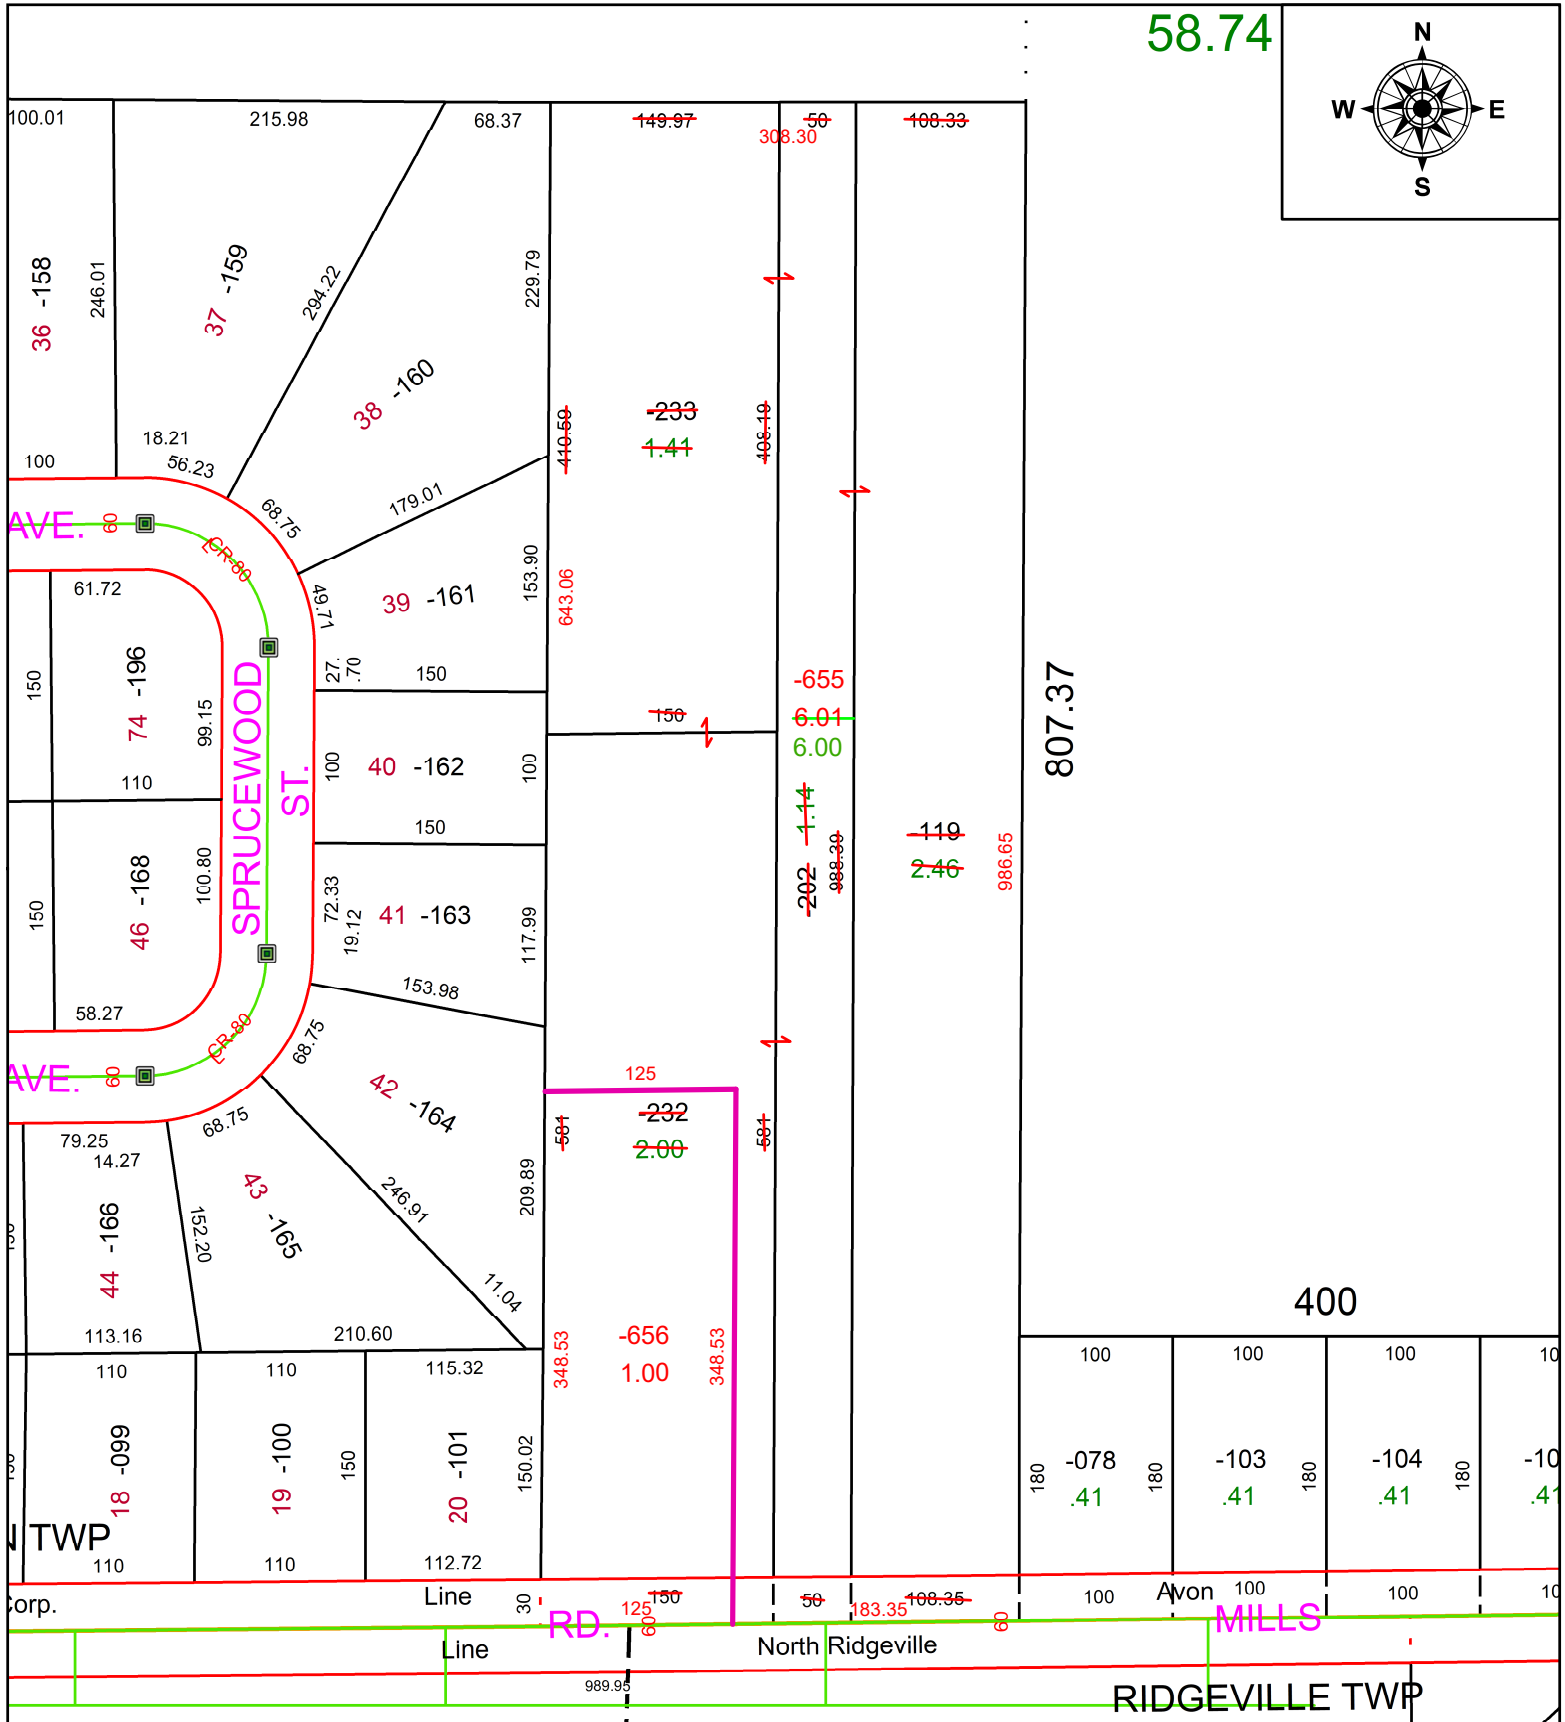


PARENT PARCEL: 04-00-025-000-119, -202, -232, & -233

CHILD PARCEL: 04-00-025-000-655 & -656

24-04902

STARTING POINT: C/L OF LEAR NAGEL AND MILLS RD **AC CORR PER SURV BY RICHARD J. KOLE**

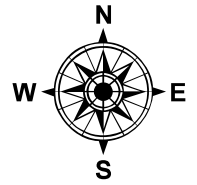

**SPLITS/DEEDS PROCESSED**  
LORAIN COUNTY TAX MAP DEPARTMENT  
226 MIDDLE AVE. ELYRIA, OH

SURVEYED BY: RICHARD J. KOLE SURV # 51269  
CLOSURE: 1: 543196  
MAP PAGE(S): 04-00-025  
APPROVED BY: AC DATE: September 09, 2024  
SCALE: 1 in = 125 ft PRIOR INSTRUMENT: 2024- 0007911