


PARENT PARCEL: 02-00-051-141-039 THRU -044

CHILD PARCEL: 02-00-051-141-046 & -047

STARTING POINT: INTERSECTION OF C/LS OF COLORADO AVE & IOWA AVE

24-04903

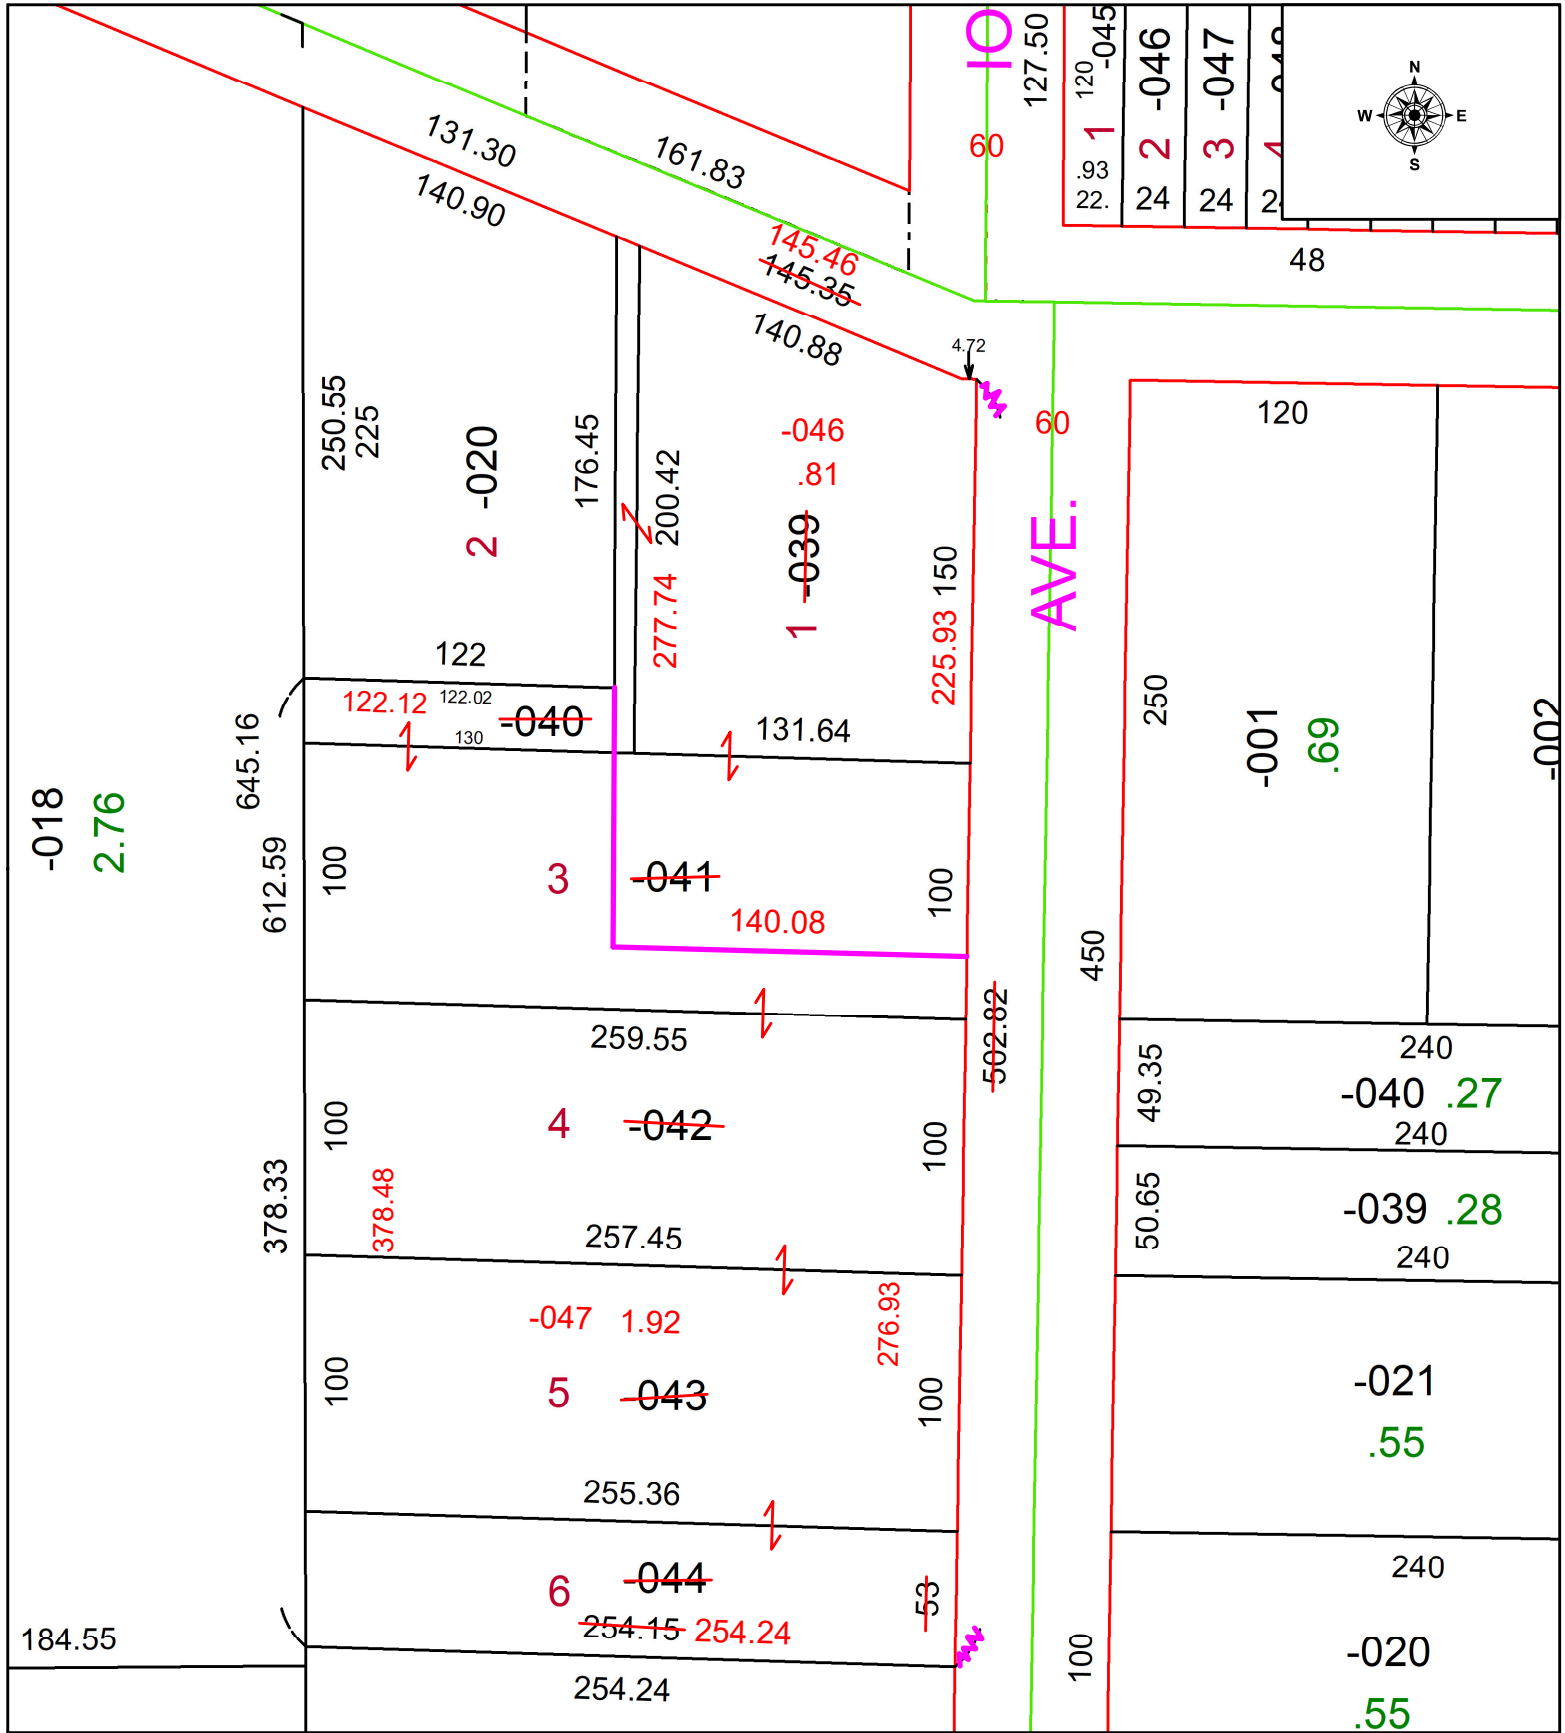

**SPLITS/DEEDS PROCESSED**  
 LORAIN COUNTY TAX MAP DEPARTMENT  
 226 MIDDLE AVE. ELYRIA, OH

SURVEYED BY: AMY KELLY SURVEY # 51272  
 CLOSURE: 1: 470471  
 MAP PAGE(S): 02-00-051  
 APPROVED BY: WRZ DATE: 9/11/2024  
 SCALE: 1" = 75 PRIOR INSTRUMENT: #2023-09905864