



PARENT PARCEL: 04-00-010-113-014

CHILD PARCEL: N/A

ACREAGE CORRECTION PER SEAN BOLAND

22-04907-A

STARTING POINT: MONUMENT @ INTERSECTION OF C/LS OF DETORIT RD & COLORADO AVE

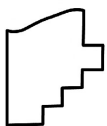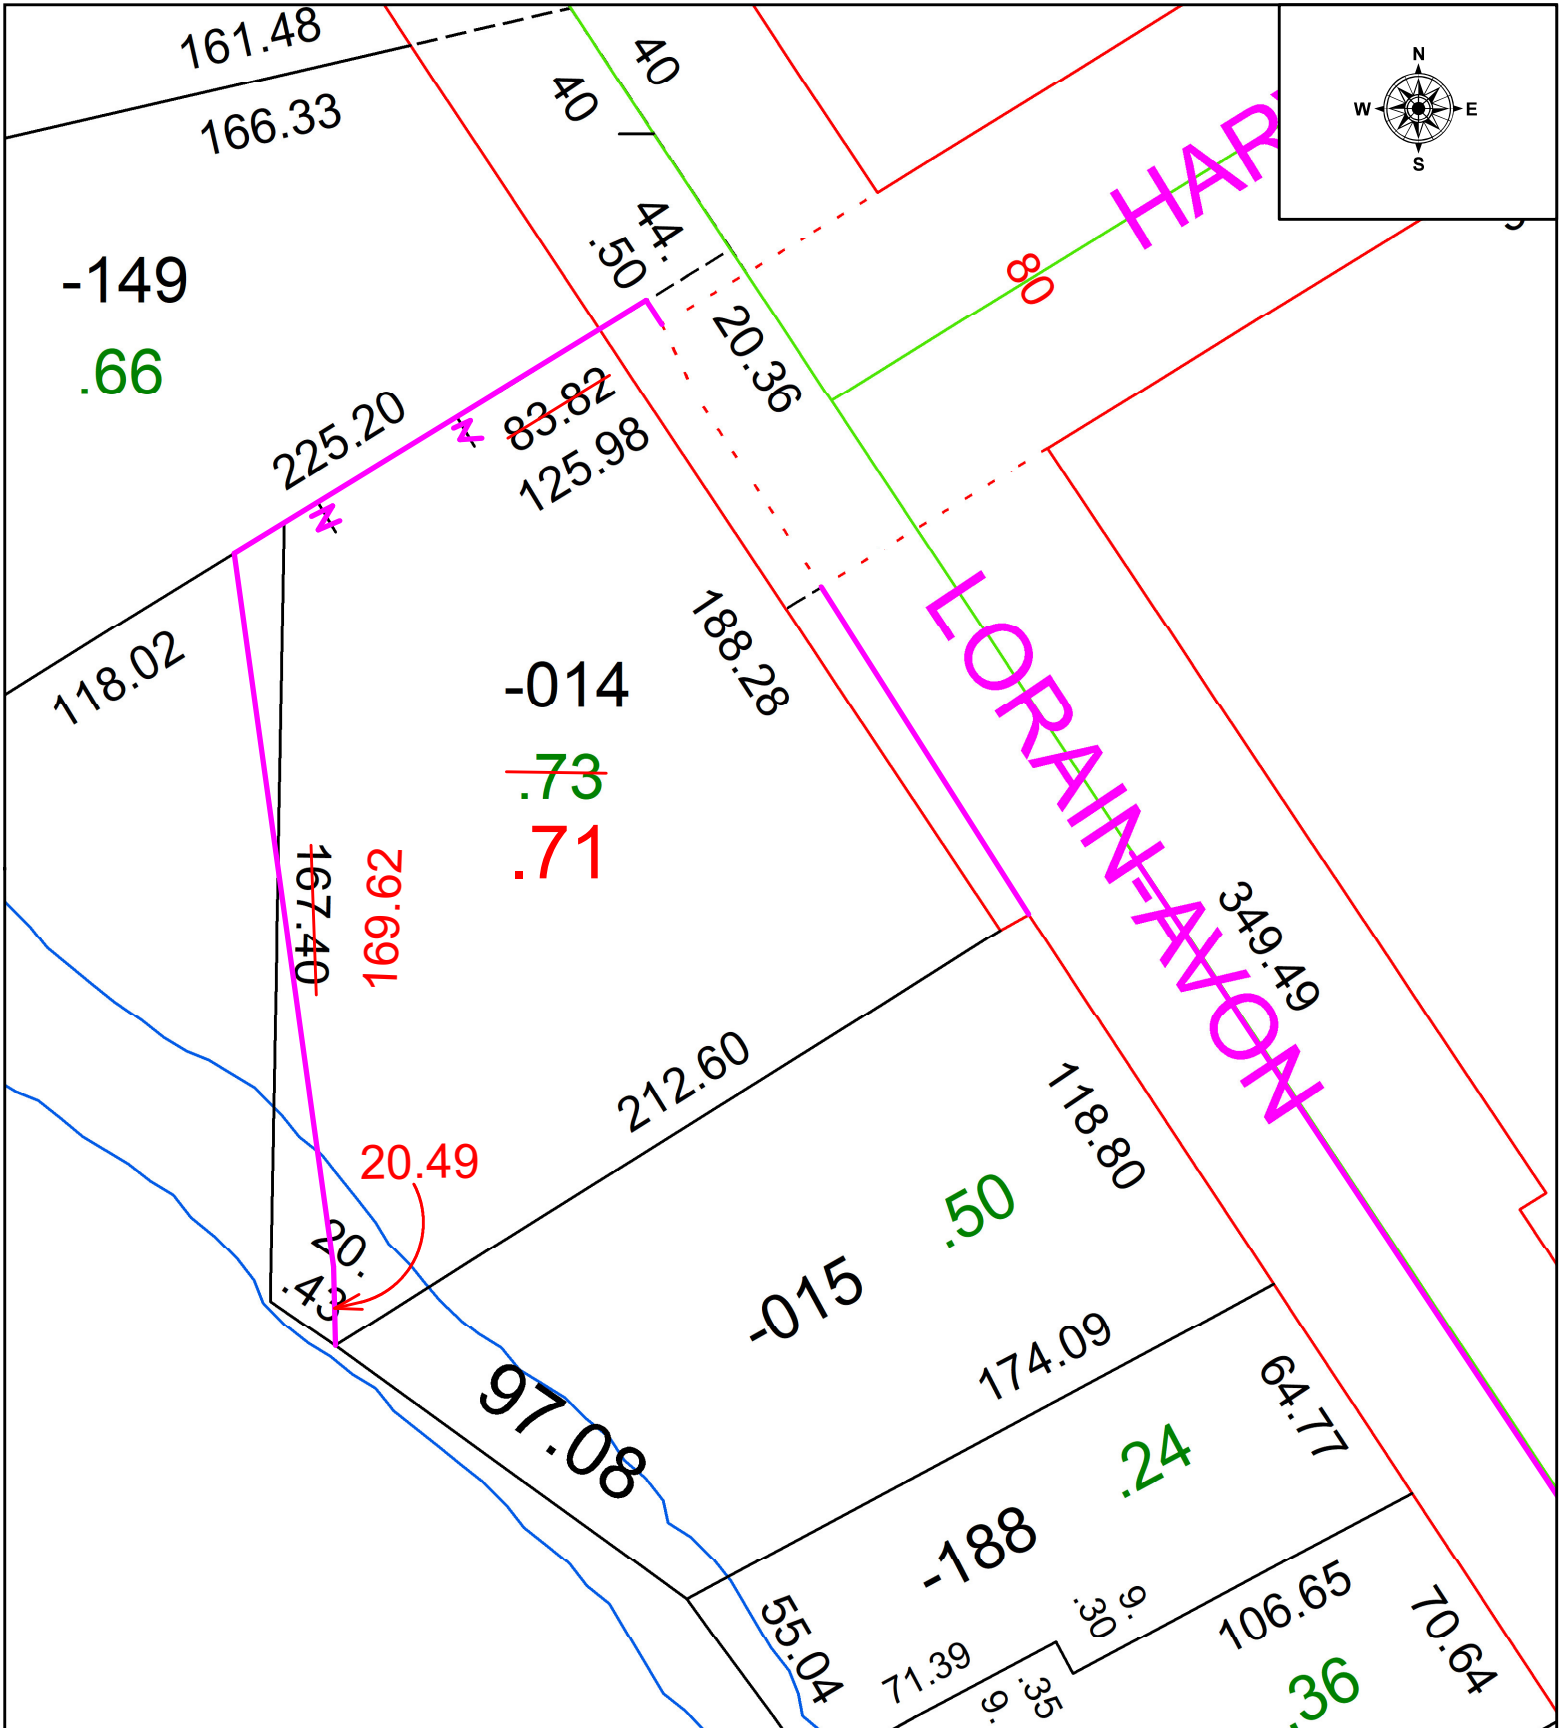

SPLITS/DEEDS PROCESSED
 LORAIN COUNTY TAX MAP DEPARTMENT
 226 MIDDLE AVE. ELYRIA, OH

SURVEYED BY: SEAN BOLAND	SURVEY # 50645
CLOSURE: 1:377395	
MAP PAGE(S): 04-00-010	
APPROVED BY: WRZ	DATE: 7/21/2022
SCALE: 1" = 50	PRIOR INSTRUMENT: 2011-0395614