
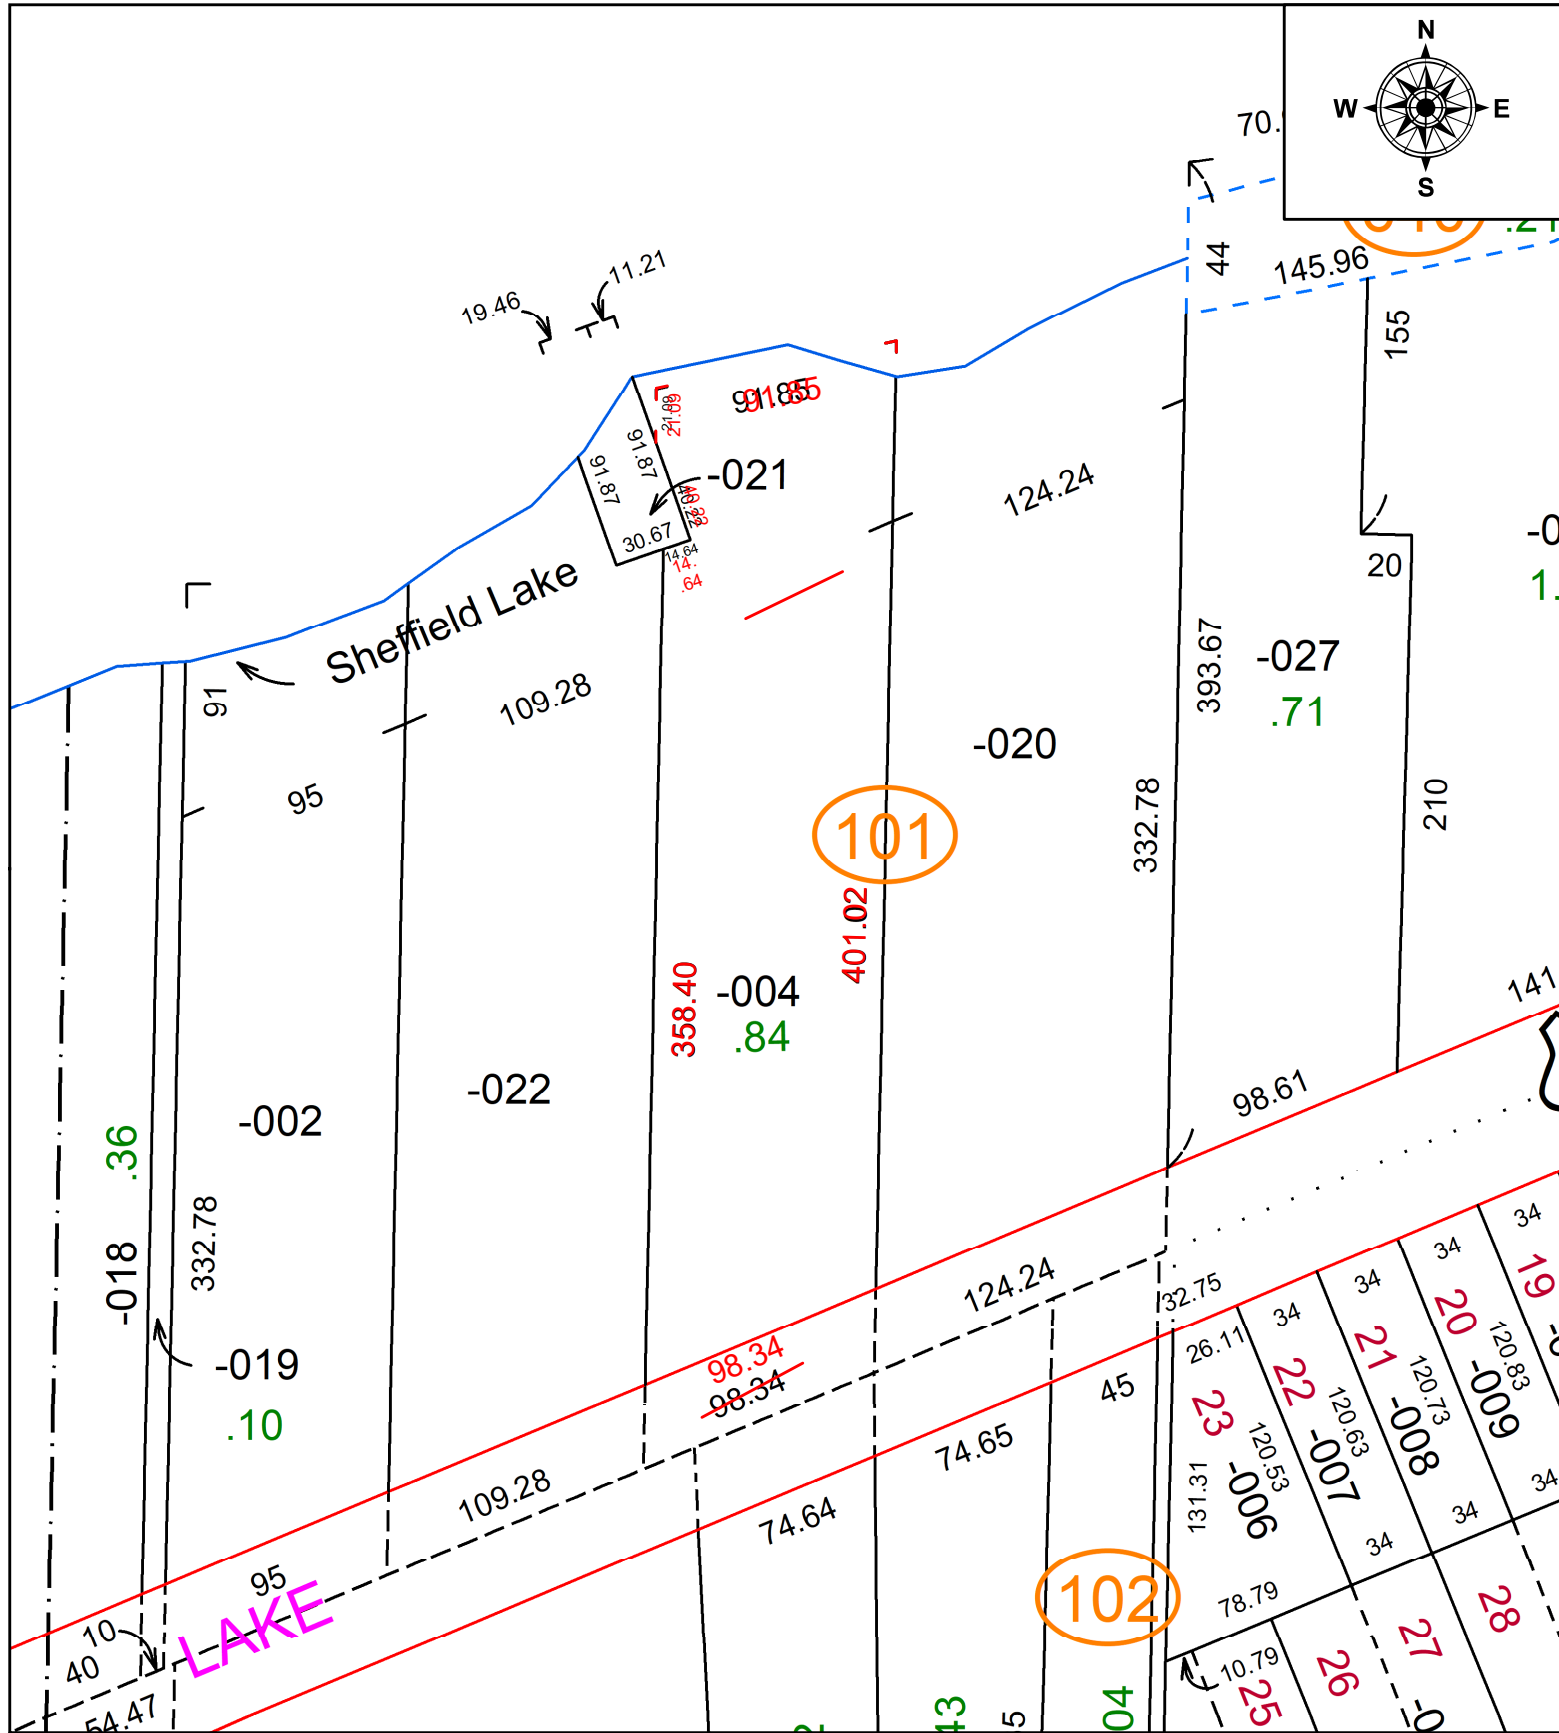


PARENT PARCEL: 03-00-044-101-004

CHILD PARCEL: **FR. & DEPTH TO AC. CORR. PER SURVEY SEAN BOLAND**

STARTING POINT: CL OF LAKE RD. & WESTERLY LINE O.L. 44 SHEFFIELD TWP.

22-04908-C

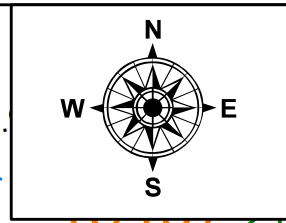

SPLITS/DEEDS PROCESSED
LORAIN COUNTY TAX MAP DEPARTMENT
226 MIDDLE AVE. ELYRIA, OH

SURVEYED BY: SEAN BOLAND SURVEY #: 50646
CLOSURE: 1:236839
MAP PAGE(S): 03-00-044
APPROVED BY: DMA DATE: 7/22/2022
SCALE: 1" = 75' PRIOR INSTRUMENT: 2014-0503338