
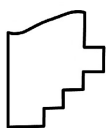


PARENT PARCEL: 04-00-026-108-171 & -177

CHILD PARCEL: 04-00-026-108-200

STARTING POINT: INTERSECTION OF C/L'S OF POTTERSTONE WAY & SCHWARTZ RD

24-04911

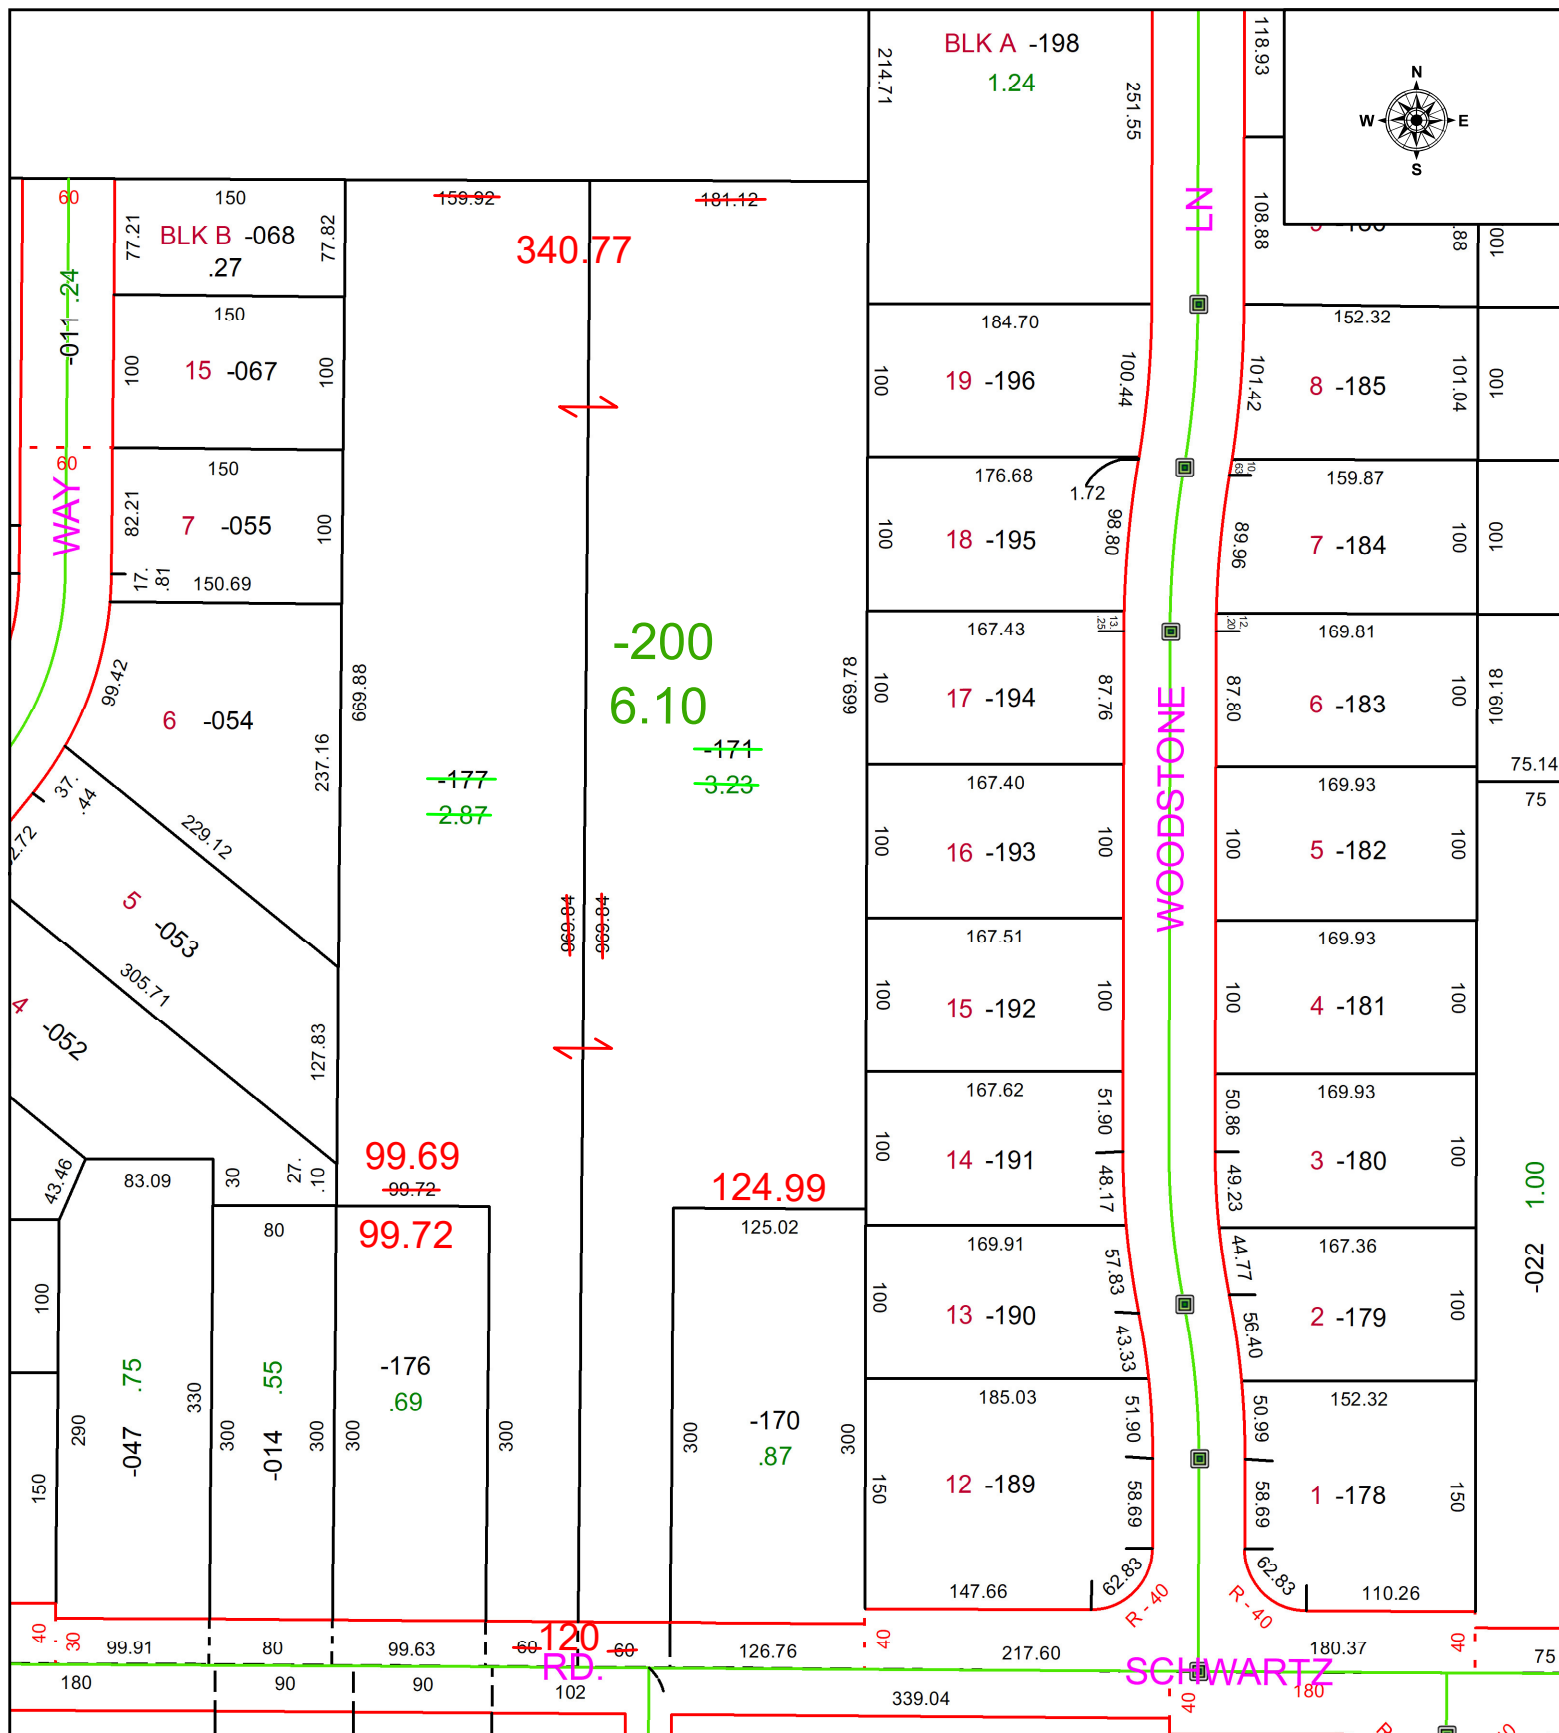

**SPLITS/DEEDS PROCESSED**  
 LORAIN COUNTY TAX MAP DEPARTMENT  
 226 MIDDLE AVE. ELYRIA, OH

SURVEYED BY: MICHAEL SPELLACY SURVEY # 51277  
 CLOSURE: 1: 409499  
 MAP PAGE(S): 04-00-026  
 APPROVED BY: WRZ DATE: 9/19/2024  
 SCALE: 1" = 125 PRIOR INSTRUMENT: #2024-0006835