
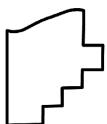


PARENT PARCEL: 15-00-045-101-090

CHILD PARCEL: **AC. CORR. PER PRIOR INSTRUMENT # 2016-0604860**

STARTING POINT: CL OF KEYWOOD BLVD. & LaGRANGE RD.

22-04914-A

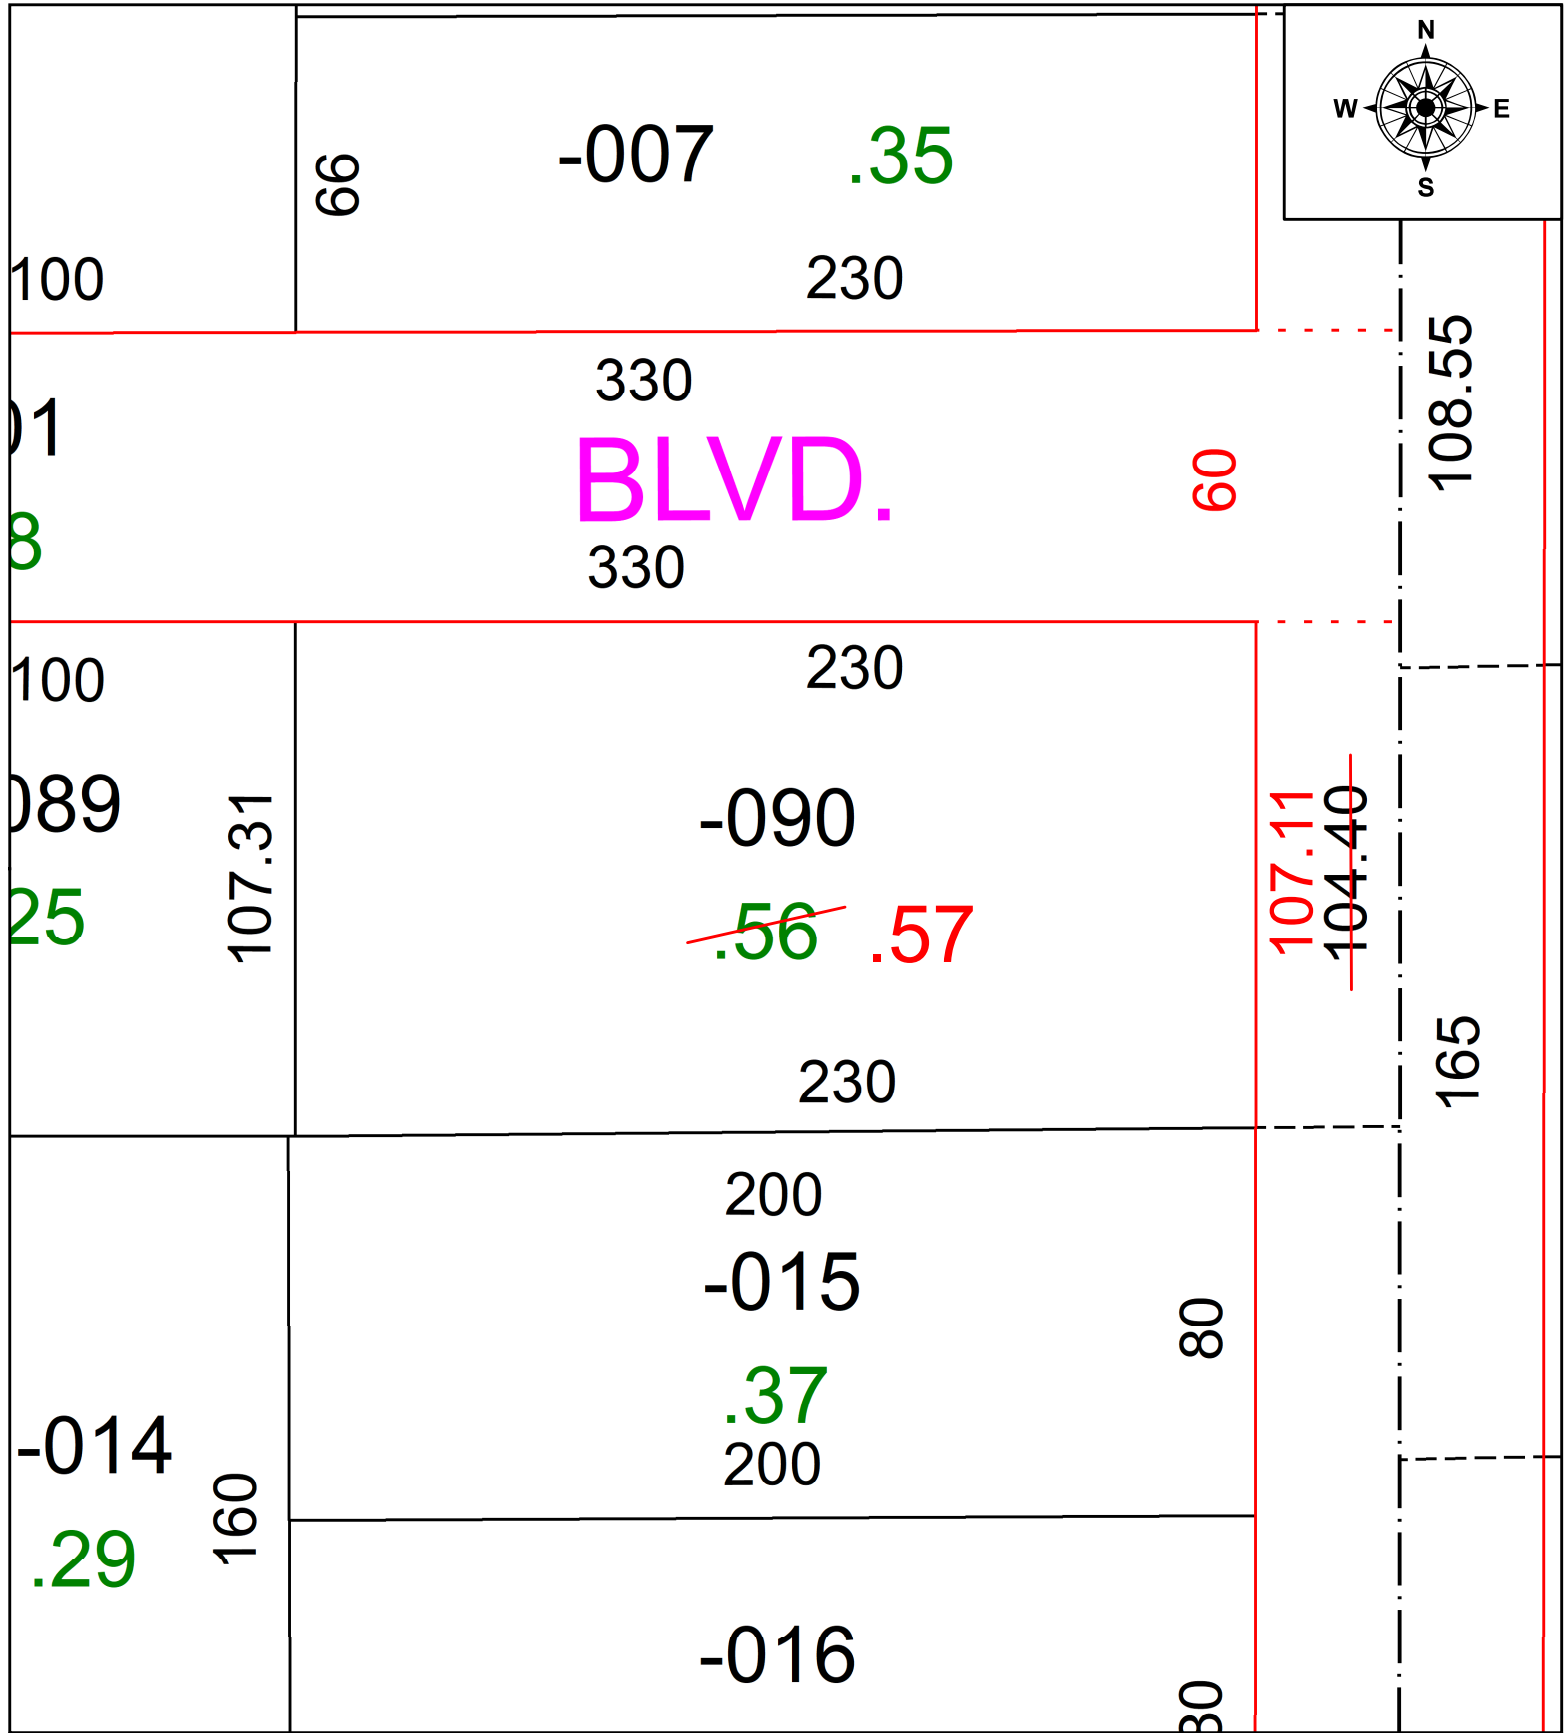

SPLITS/DEEDS PROCESSED
LORAIN COUNTY TAX MAP DEPARTMENT
226 MIDDLE AVE. ELYRIA, OH

SURVEYED BY:	N/A	SURVEY #:	N/A
CLOSURE:	N/A		
MAP PAGE(S):	15-00-045		
APPROVED BY:	DMA	DATE:	7/28/2022
SCALE:	1" = 40'	PRIOR INSTRUMENT:	2016-0604860