


PARENT PARCEL: 10-00-006-126-032

CHILD PARCEL: **AC. CORR. PER PRIOR INSTRUMENT # 2013-0464682**

22-04915-A

STARTING POINT: CL OF MEDINA-ELYRIA RD. & EASTERLY CORNER OF LAND CATHERINE DIEDERICK

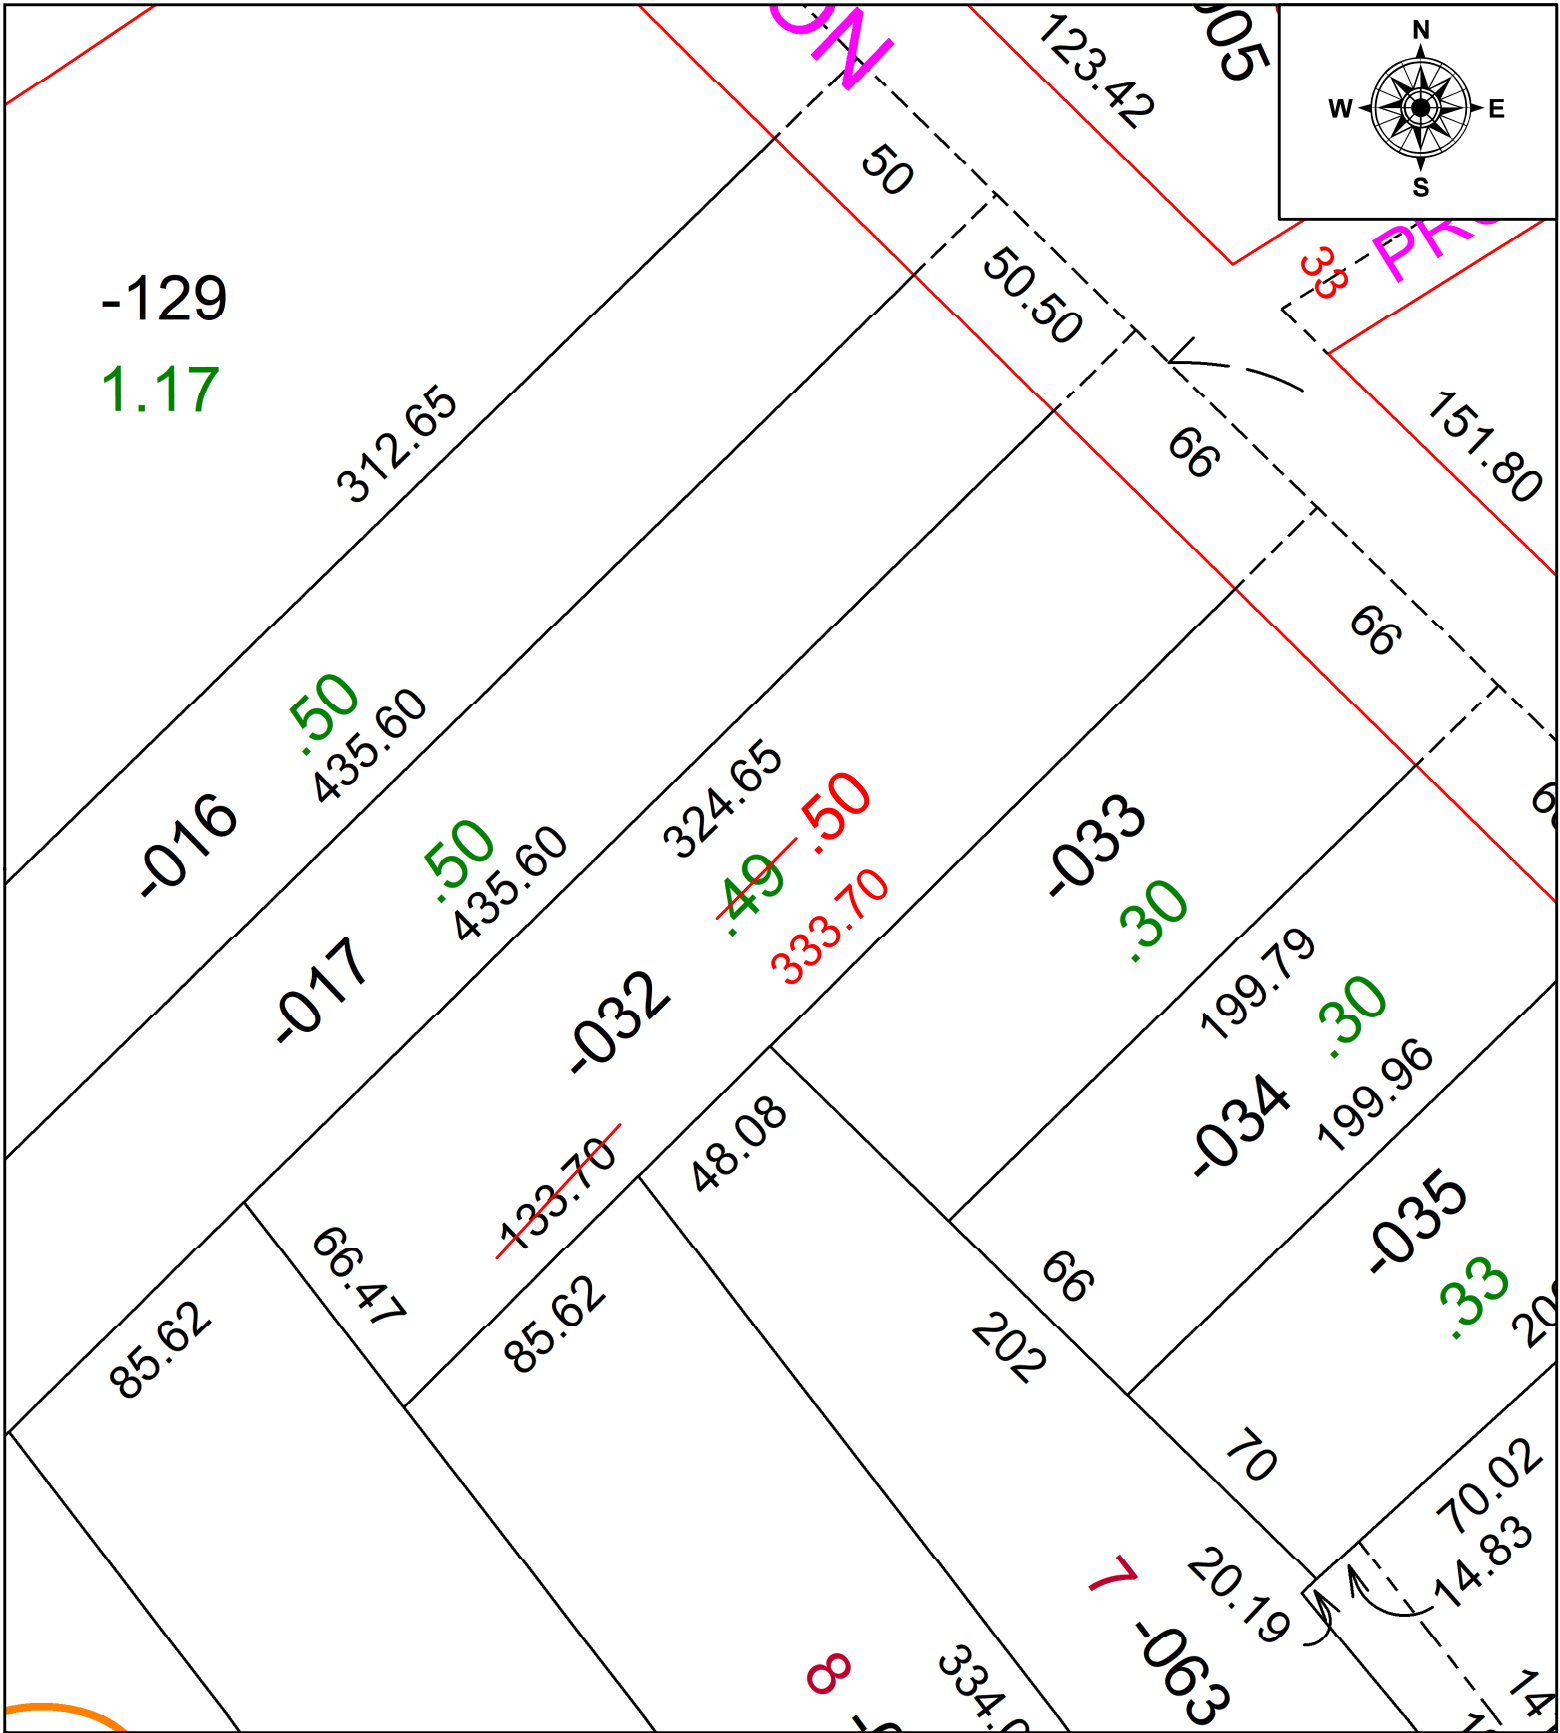

SPLITS/DEEDS PROCESSED
 LORAIN COUNTY TAX MAP DEPARTMENT
 226 MIDDLE AVE. ELYRIA, OH

SURVEYED BY:	N/A	SURVEY #:	N/A
CLOSURE:	N/A		
MAP PAGE(S):	10-00-006		
APPROVED BY:	DMA	DATE:	7/28/2022
SCALE:	1" = 50'	PRIOR INSTRUMENT:	2013-0464682