
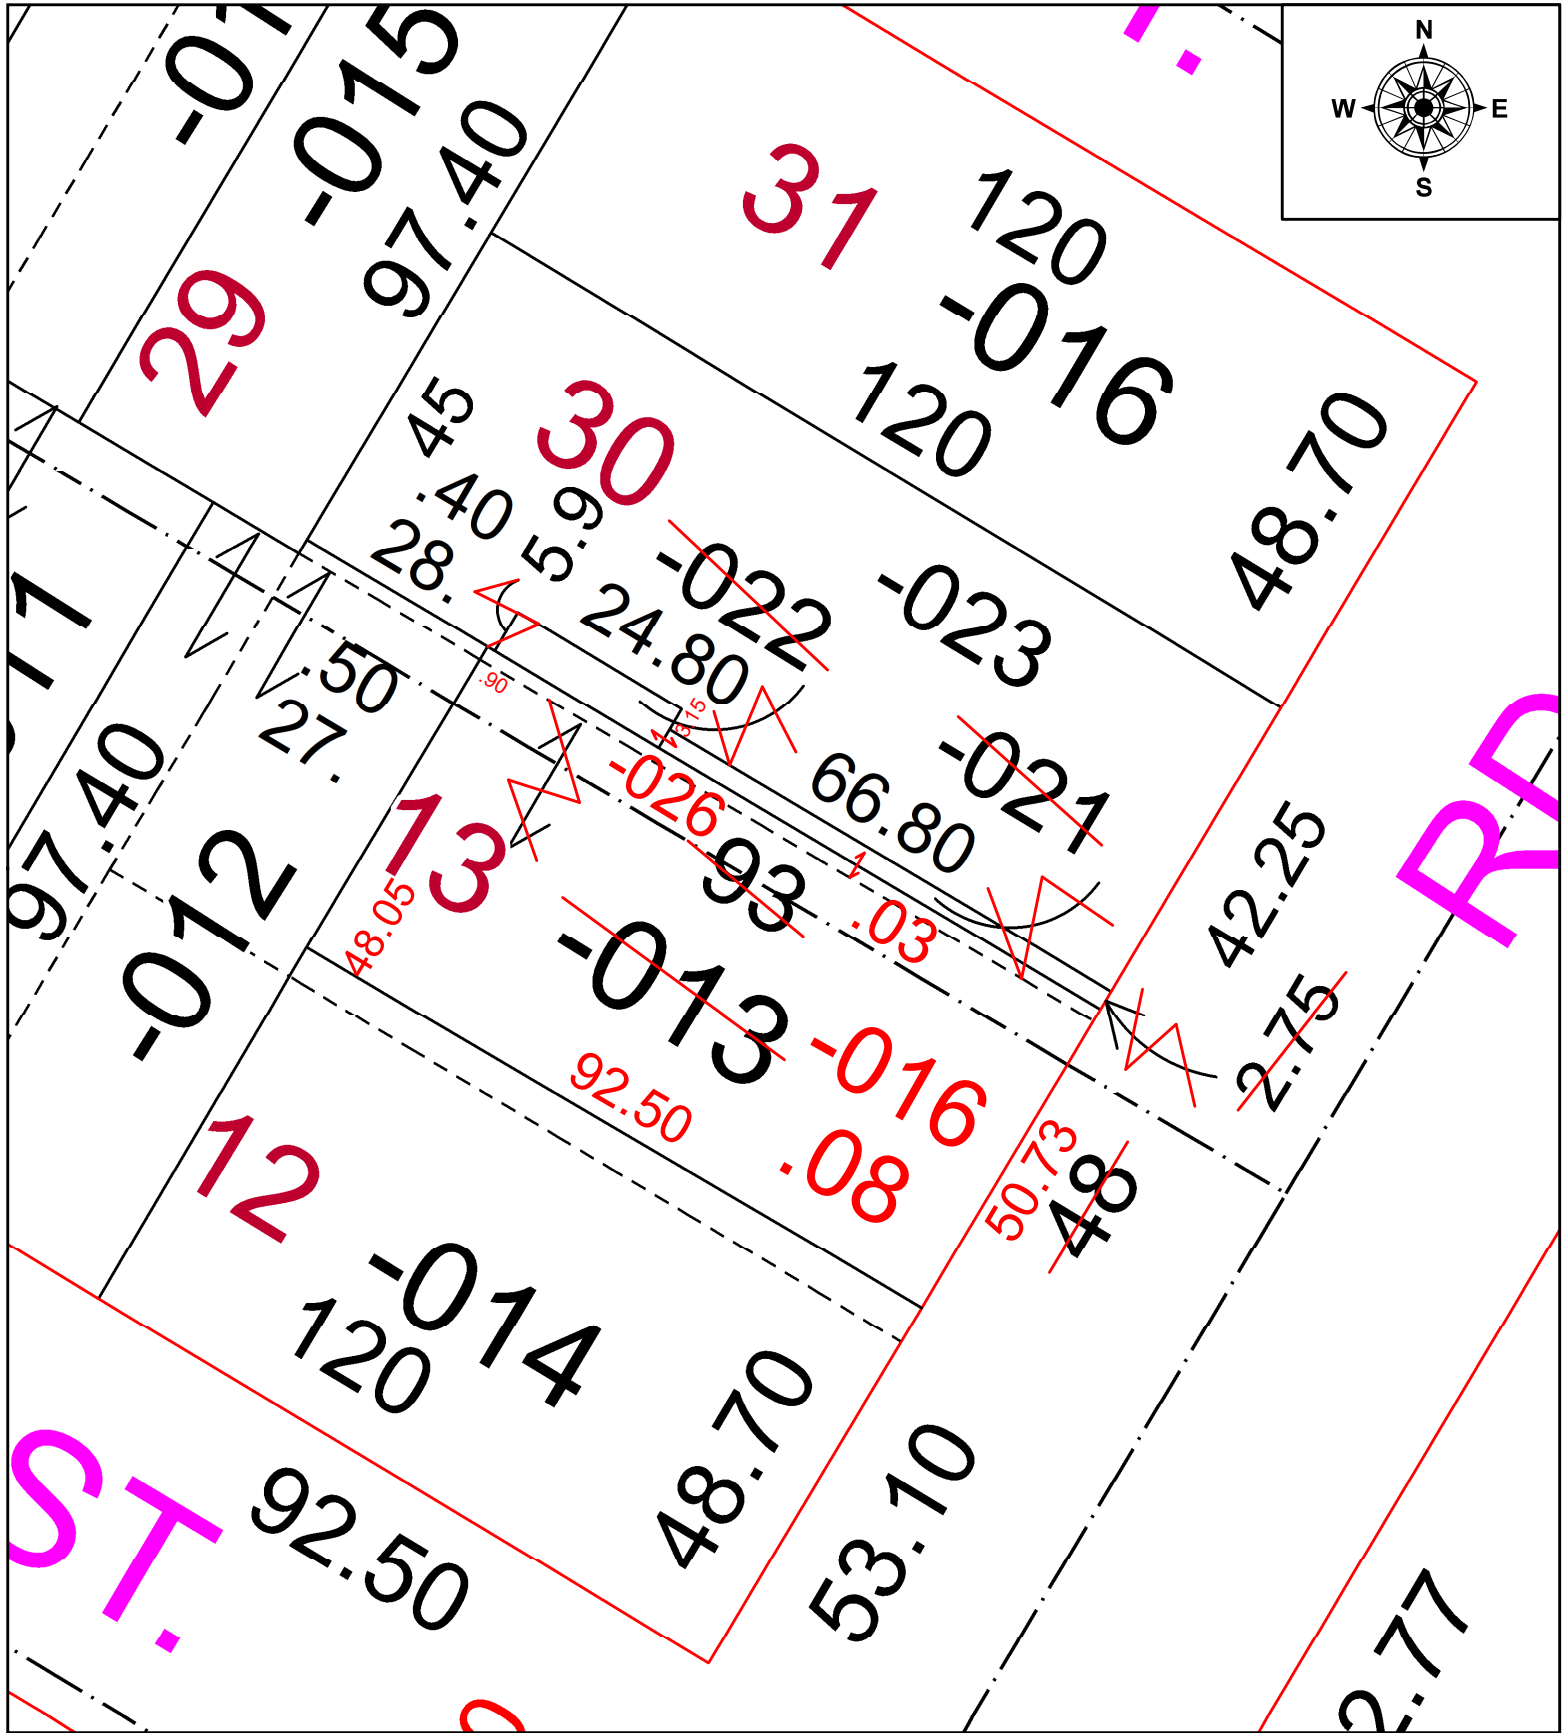


PARENT PARCEL: 06-25-101-000-013 & 06-25-102-000-021 & -022

CHILD PARCEL: 06-25-101-000-016 & 06-25-102-000-026

STARTING POINT: N.E. CORNER S/L 31 J.C. CRISP TRUSTEE'S ADDTION P.V. 5 PG. 8

22-04917-A

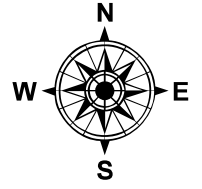

SPLITS/DEEDS PROCESSED
LORAIN COUNTY TAX MAP DEPARTMENT
226 MIDDLE AVE. ELYRIA, OH

SURVEYED BY:	THOMAS SIMON	SURVEY #:	50653
CLOSURE:	1:92024		
MAP PAGE(S):	06-25-101 & -102		
APPROVED BY:	DMA	DATE:	7/29/2022
SCALE:	1" = 25'	PRIOR INSTRUMENT:	D.V. 785 PG. 868