
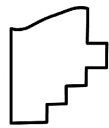


PARENT PARCEL: 06-23-008-104-066

CHILD PARCEL: 06-23-008-104-068 & 06-23-009-102-082

STARTING POINT: **AC CORR PER SURV BY JOHN A. DECHANT JR.**

22-04918-A

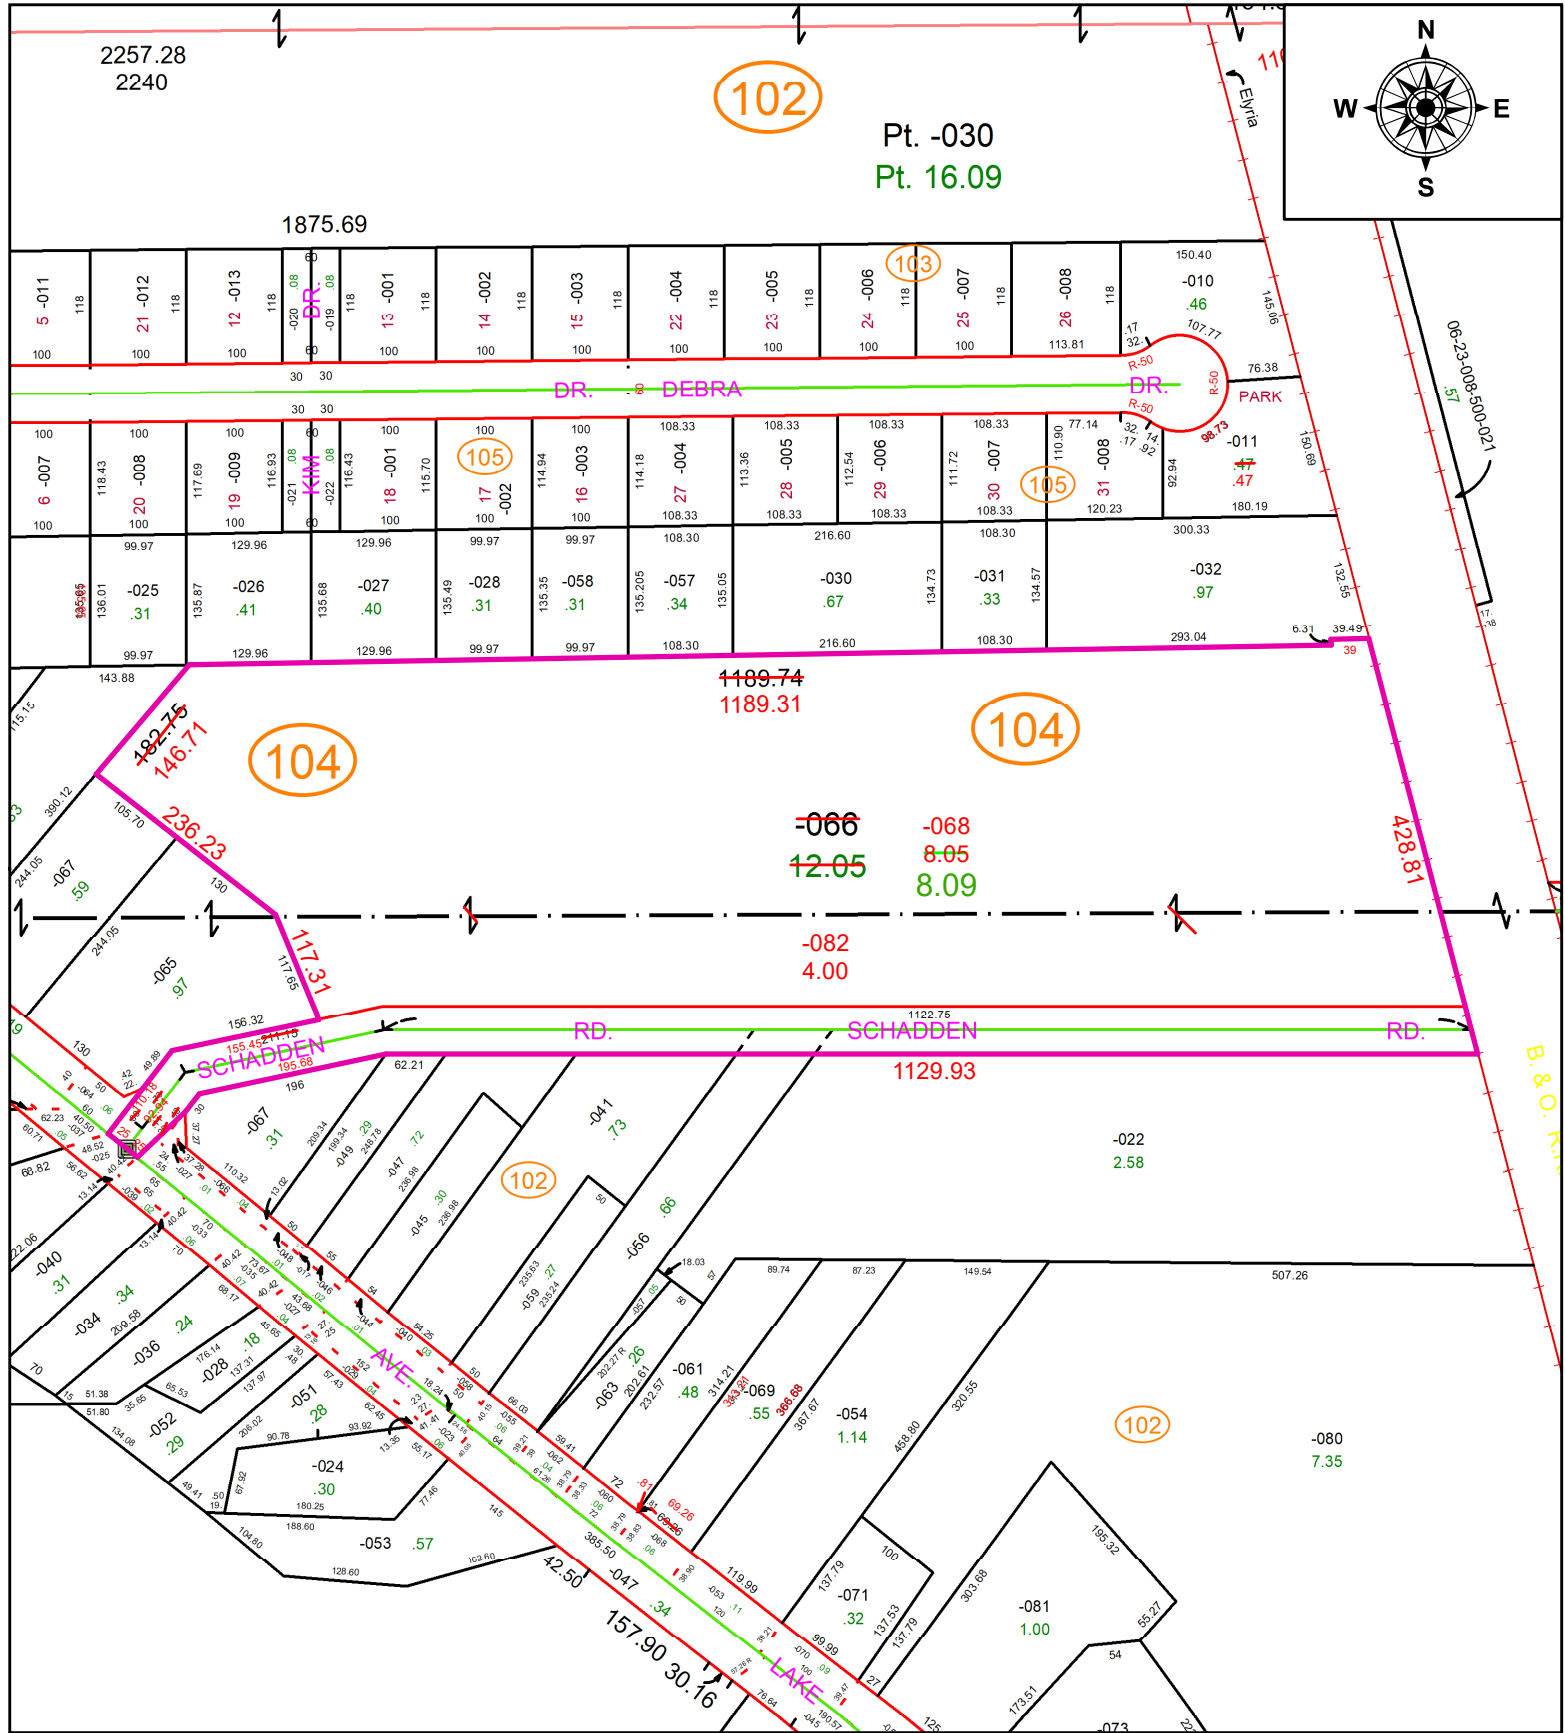

SPLITS/DEEDS PROCESSED
 LORAIN COUNTY TAX MAP DEPARTMENT
 226 MIDDLE AVE. ELYRIA, OH

SURVEYED BY: JOHN A. DECHANT JR.
CLOSURE: 1: 380255
MAP PAGE(S): 06-23-008
APPROVED BY: AC **DATE:** August 01, 2022
SCALE: 1" = 200 **PRIOR INSTRUMENT:** 2012- 0402307