


PARENT PARCEL: 14-00-003-00-014

CHILD PARCEL: 14-00-003-000-020 7 -021


STARTING POINT: INTERSECTION OF C/L HALLAUER RD & NORTH LINE OF O.L. 3

24-04919

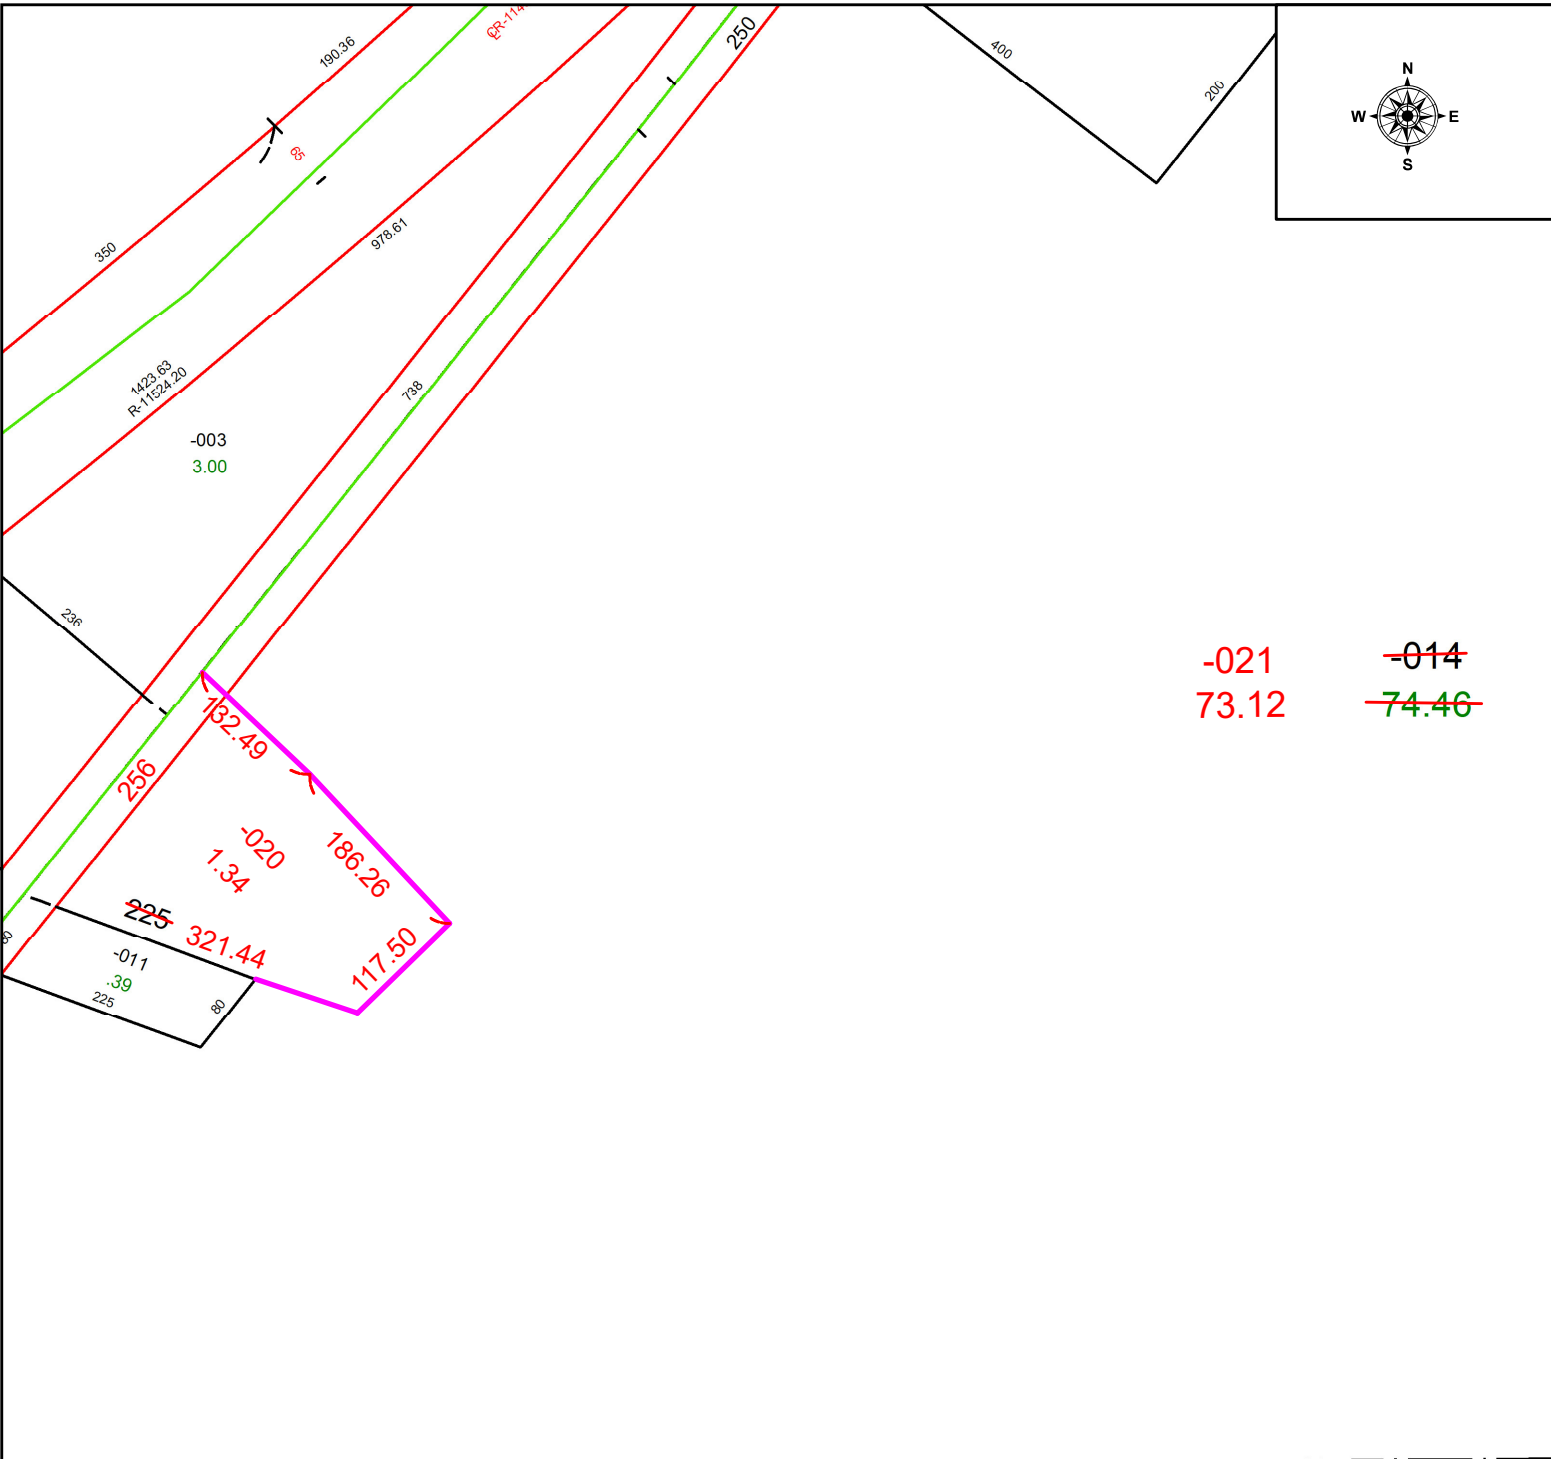

-021 ~~-014~~
 73.12 ~~74.46~~

940	-008	.65	30	528	517.52
940					

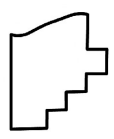 **SPLITS/DEEDS PROCESSED**
 LORAIN COUNTY TAX MAP DEPARTMENT
 226 MIDDLE AVE. ELYRIA, OH

SURVEYED BY: JAMES DEITRICK SURVEY # 51292
 CLOSURE: 1: 90725
 MAP PAGE(S): 14-00-003
 APPROVED BY: WRZ DATE: 10/2/2024
 SCALE: 1" = 175 PRIOR INSTRUMENT: #2015-0565114