
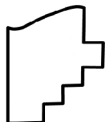
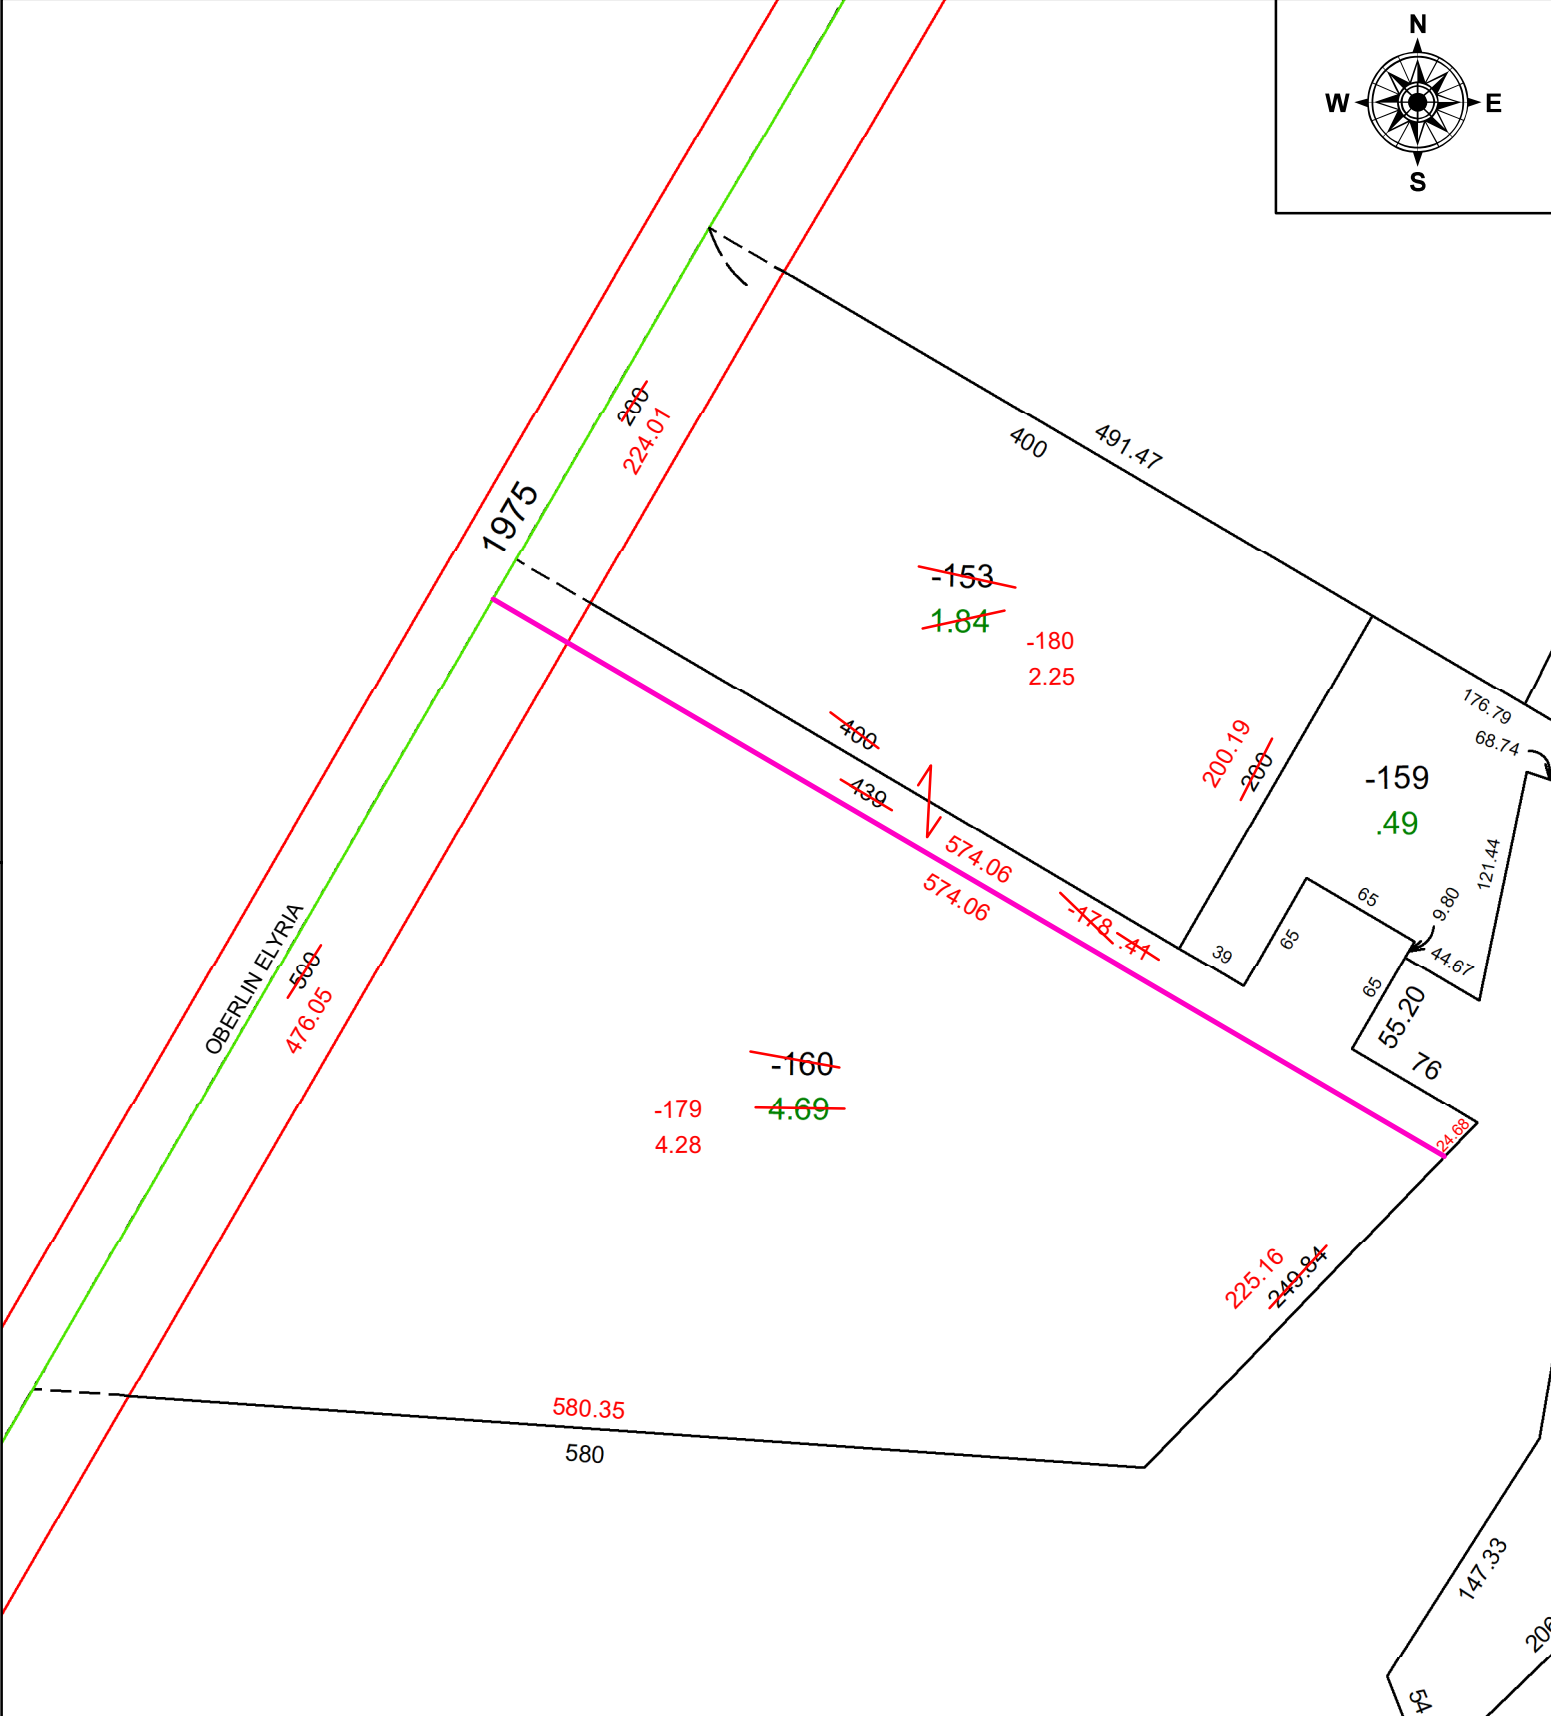


PARENT PARCEL: 10-00-012-000-153, -160

CHILD PARCEL: 10-00-012-000-178, -179, -180

STARTING POINT: INTERSECTION C/L OF BUTTERNUT RIDGE AND OBERLIN ROAD

24-04920

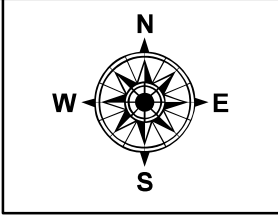

**SPLITS/DEEDS PROCESSED**  
LORAIN COUNTY TAX MAP DEPARTMENT  
226 MIDDLE AVE. ELYRIA, OH

**SURVEYED BY:** THOMAS A. SIMON      **SURVEY #:** 51294  
**CLOSURE:** 1:447684 1:564873 1:361888  
**MAP PAGE(S):** 1000012  
**APPROVED BY:** BB      **DATE:** 10/4/2024  
**SCALE:** 1" = 100'      **PRIOR INSTRUMENT:** #20240014911