
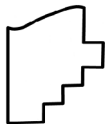


PARENT PARCEL: 03-00-004-000-094

CHILD PARCEL: 03-00-004-000-098 THRU -100

STARTING POINT: CL OF FRENCH CREEK RD. & EAST LINE OF O.L. 5

24-04924

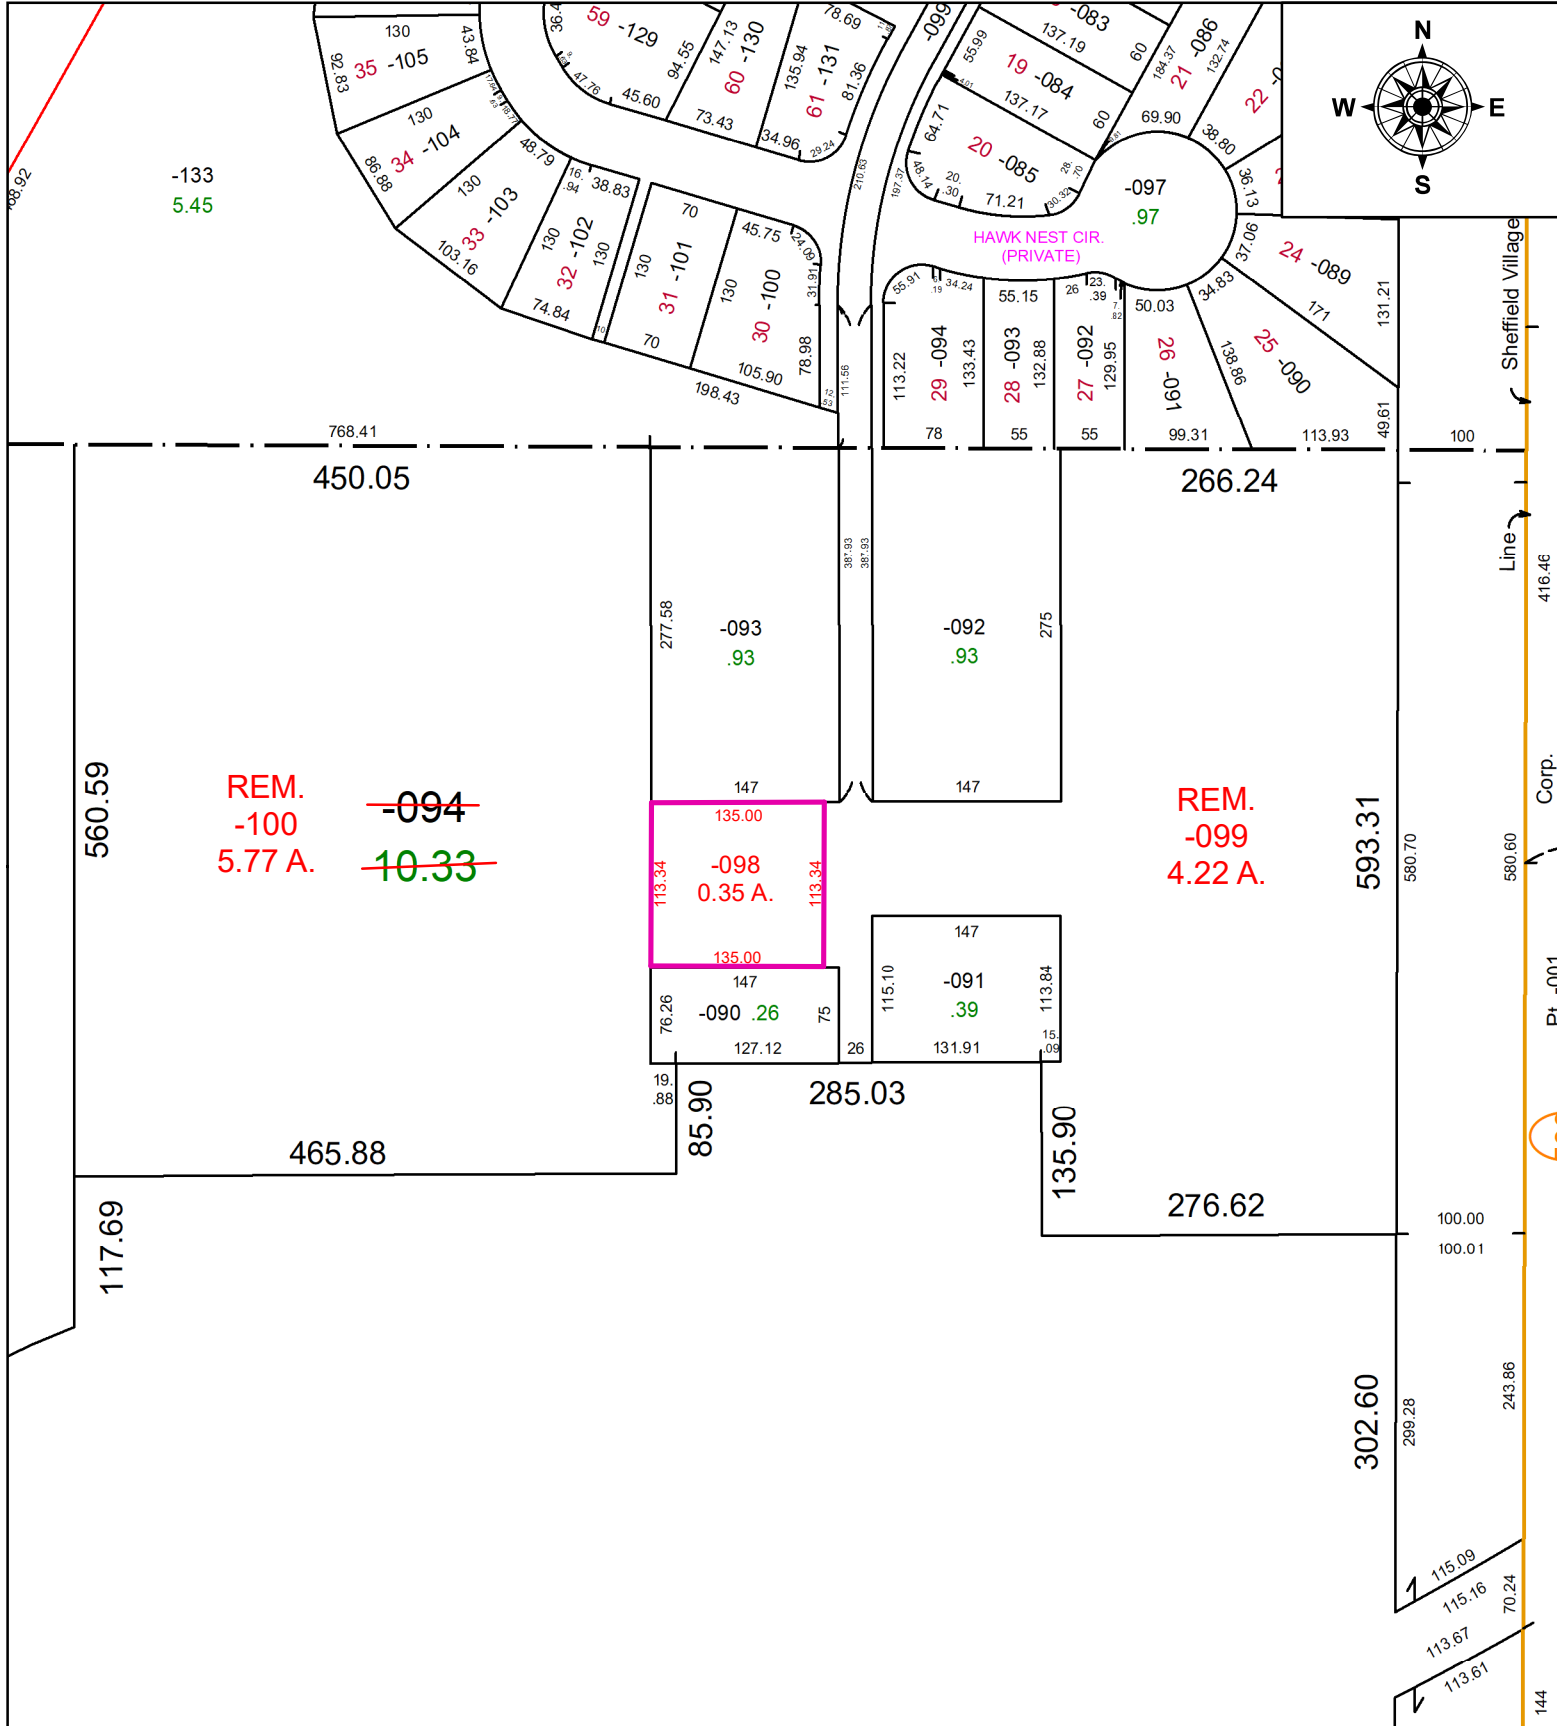

SPLITS/DEEDS PROCESSED
 LORAIN COUNTY TAX MAP DEPARTMENT
 226 MIDDLE AVE. ELYRIA, OH

SURVEYED BY: BRENT ANDERSON
CLOSURE: 1: INF
MAP PAGE(S): 03-00-004
APPROVED BY: TJS **DATE:** 10/17/2024
SCALE: 1" = 150' **PRIOR INSTRUMENT:** 2022-0888851