
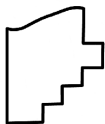


PARENT PARCEL: 07-00-033-121-007

CHILD PARCEL: **MAP CORRECTION ONLY**

STARTING POINT: C/L OF U.S 20 AND MADDOCK RD

22-04926-C

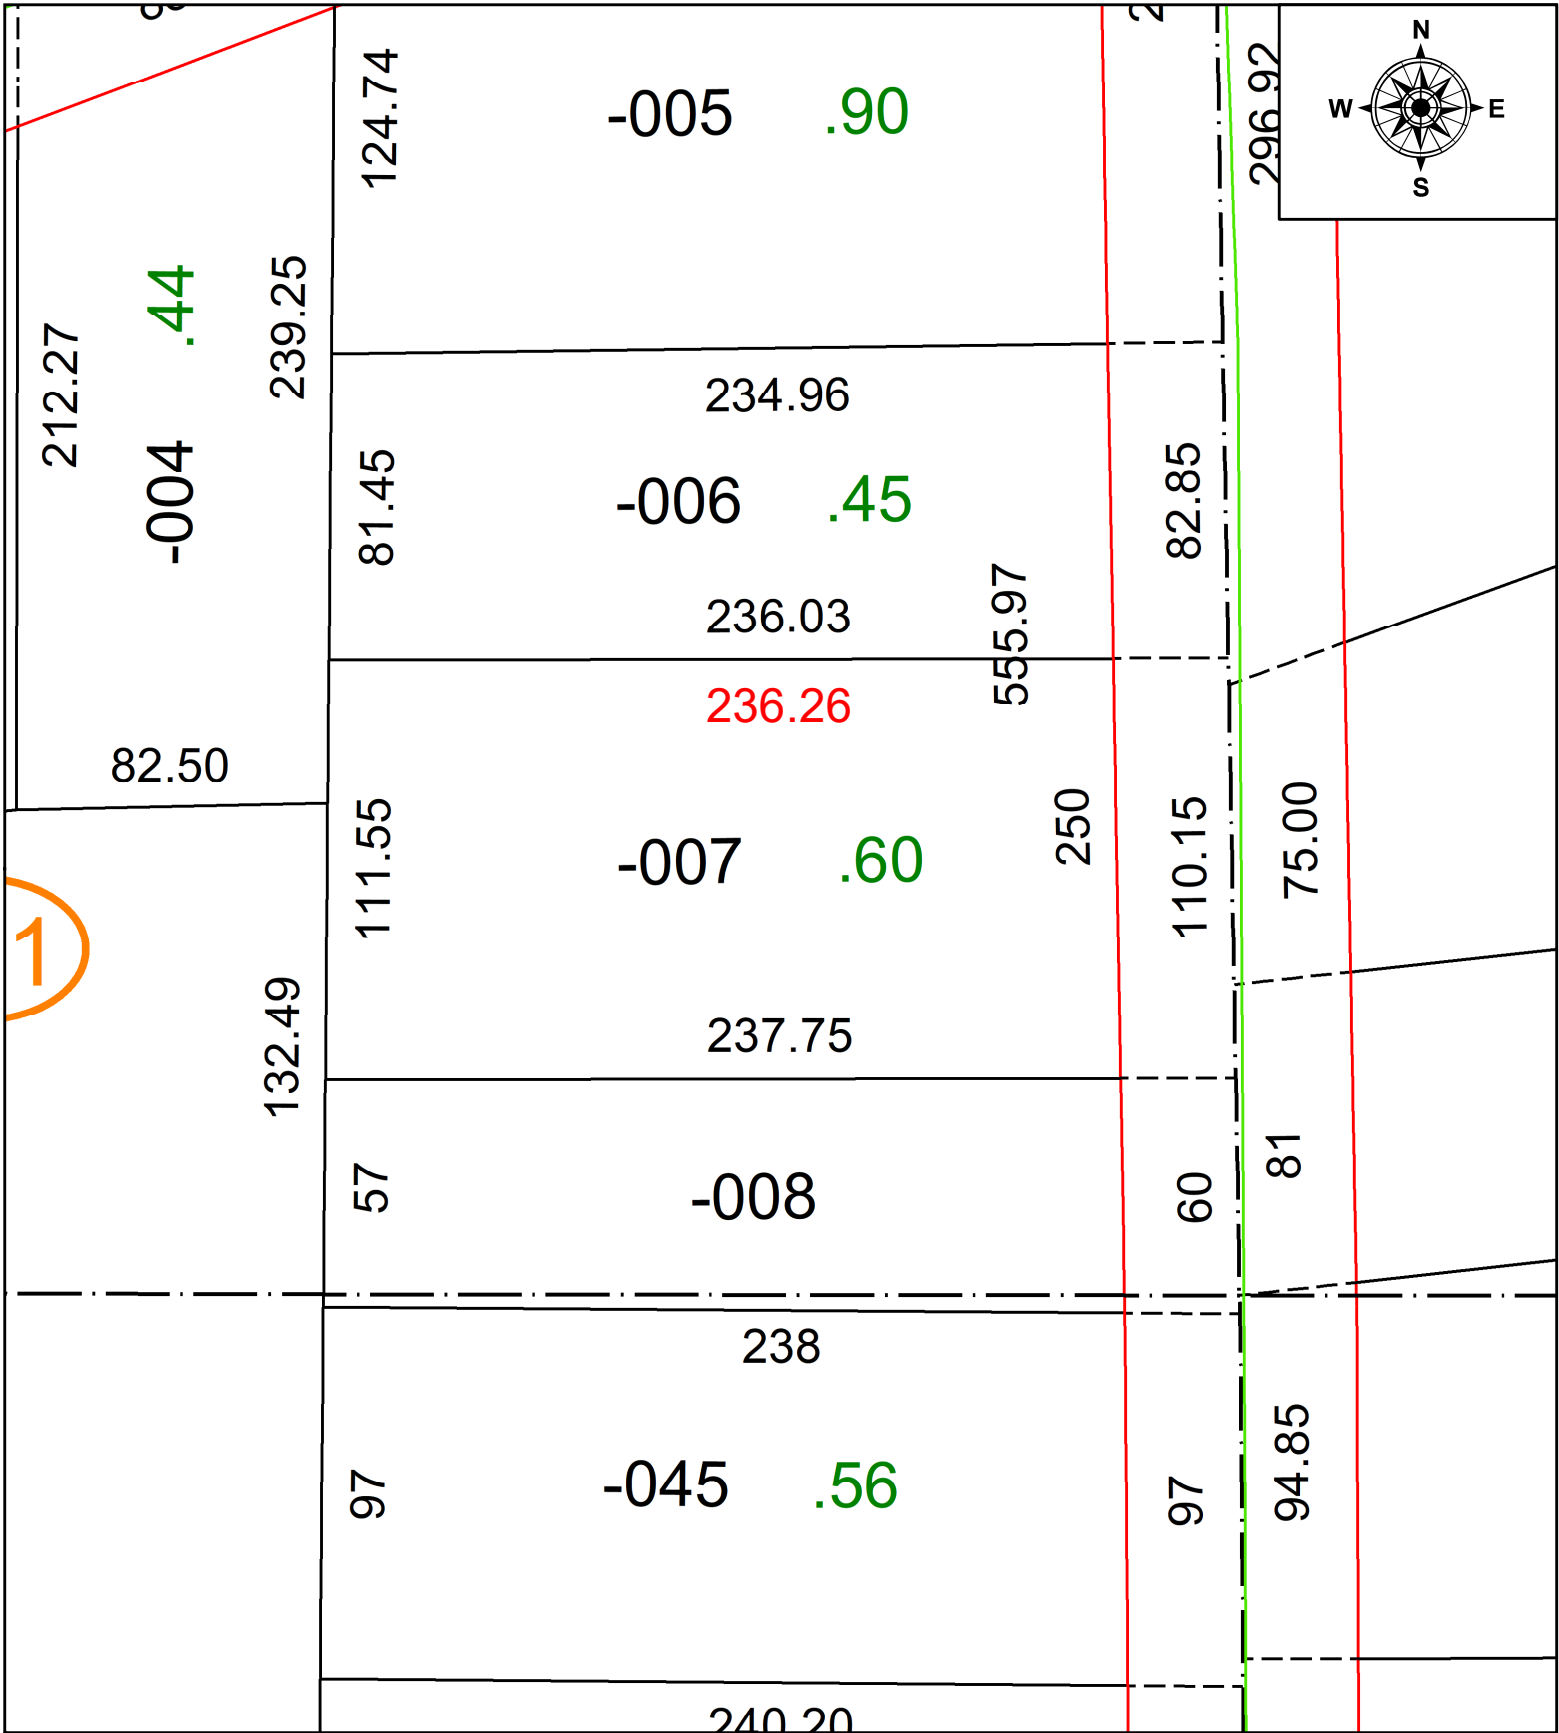

**SPLITS/DEEDS PROCESSED**  
 LORAIN COUNTY TAX MAP DEPARTMENT  
 226 MIDDLE AVE. ELYRIA, OH

SURVEYED BY: WILFREDO BARBOSA  
 CLOSURE: 1: 100789  
 MAP PAGE(S): 07-00-033-D  
 APPROVED BY: AC DATE: August 04, 2022  
 SCALE: 1" = 50' PRIOR INSTRUMENT: 2021-0824175