


PARENT PARCEL: 03-00-067-000-025

CHILD PARCEL: **AC CORR PER SURV BY SCOTT J. CASEY**

STARTING POINT: C/L OF FRENCH CREEK RD AND N LINE OF O/L 67

22-04929-A

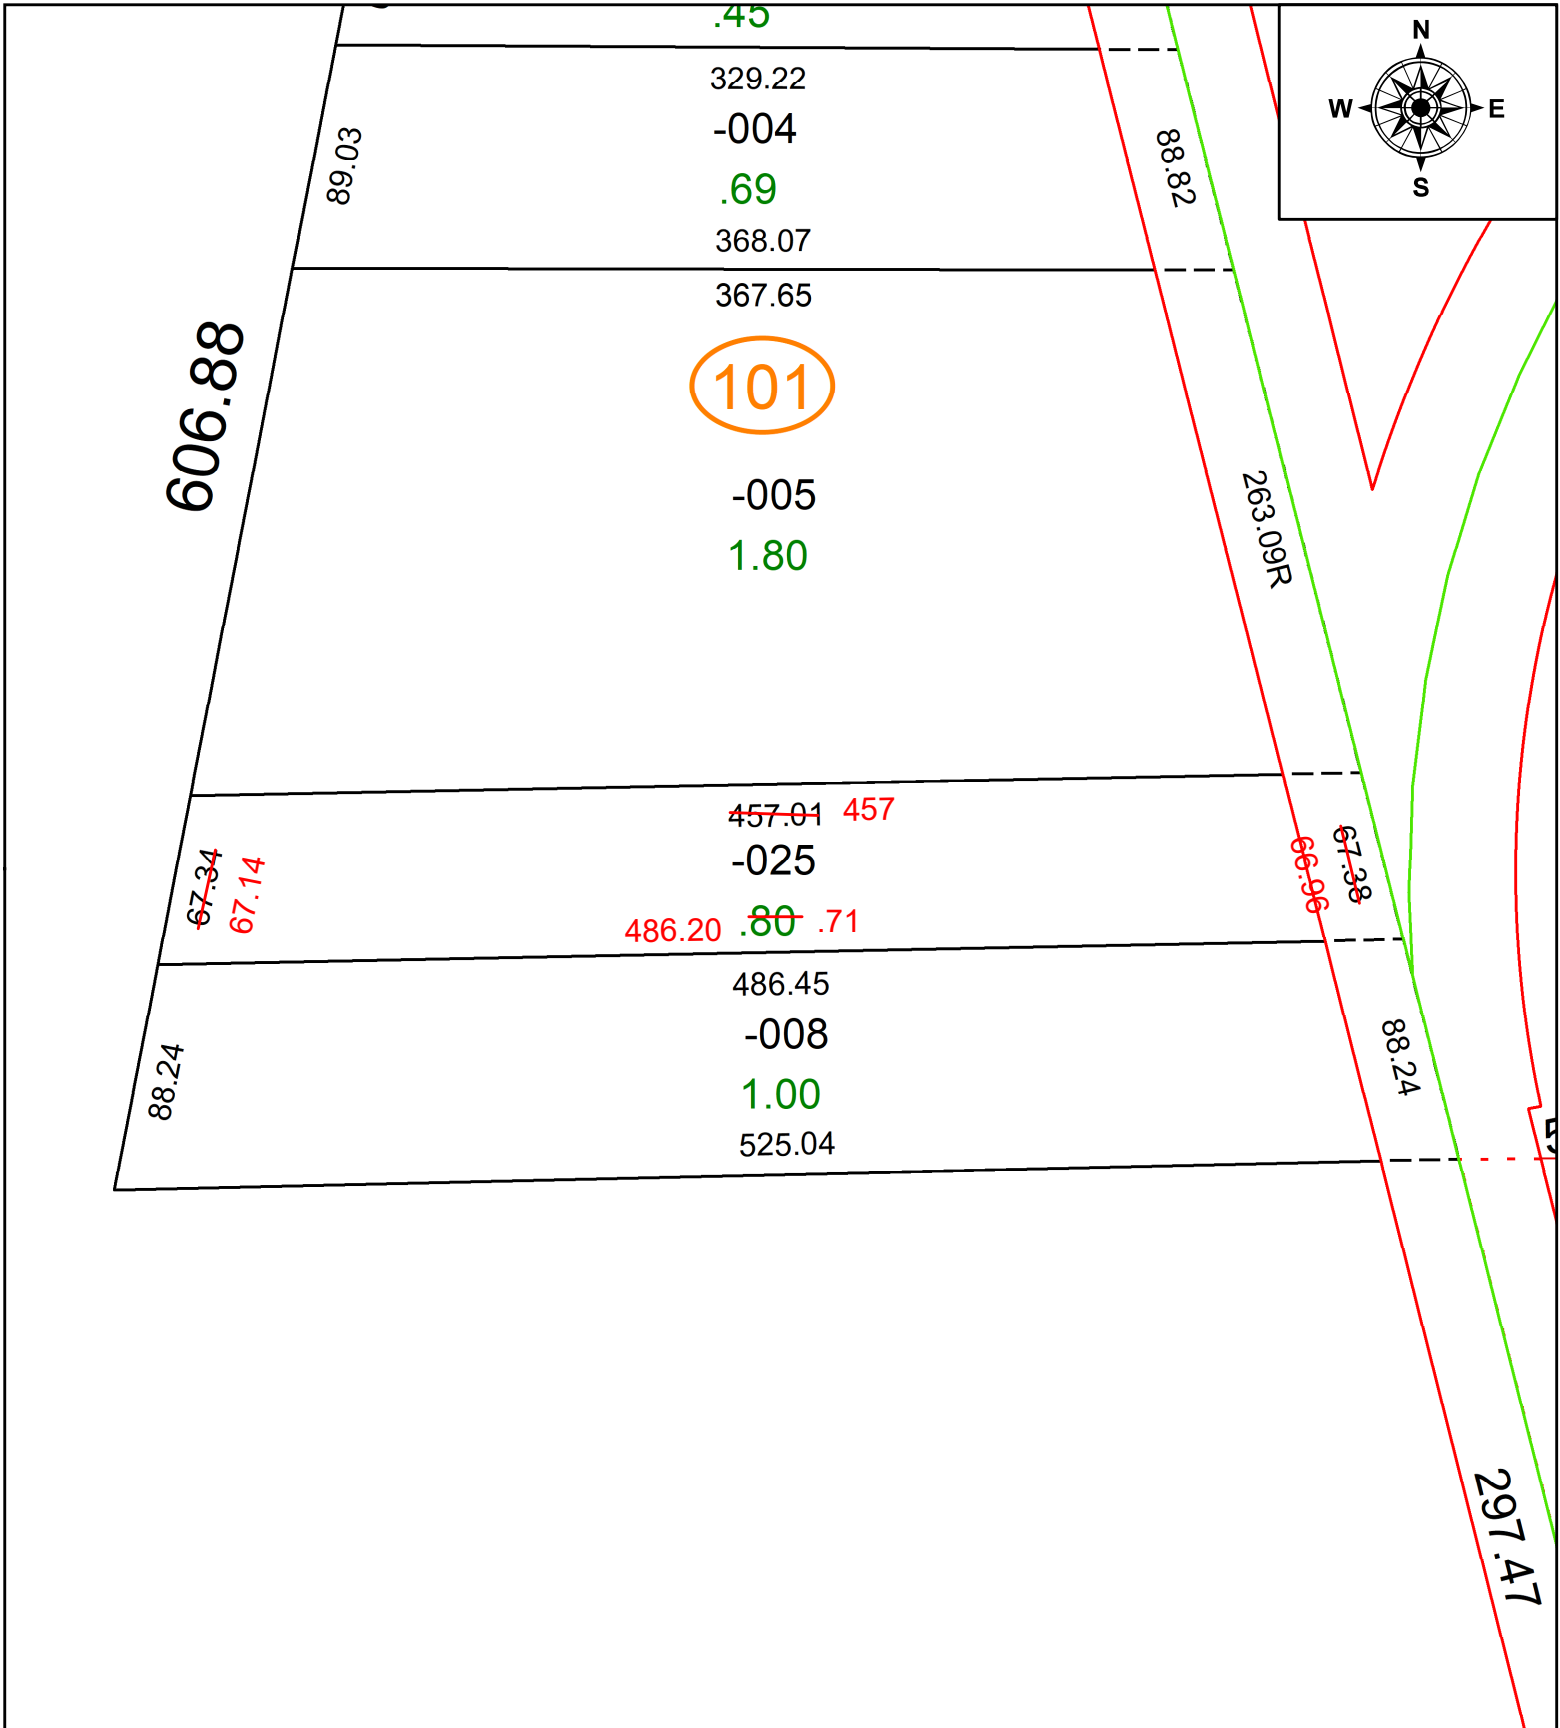

SPLITS/DEEDS PROCESSED
 LORAIN COUNTY TAX MAP DEPARTMENT
 226 MIDDLE AVE. ELYRIA, OH

SURVEYED BY: SCOTT J. CASEY

CLOSURE: 1: 259401

MAP PAGE(S): 03-00-067

APPROVED BY: AC DATE: August 11, 2022

SCALE: 1" = 75 PRIOR INSTRUMENT: 2022- 0867922