
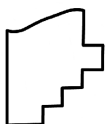


PARENT PARCEL: 02-02-005-108-030

CHILD PARCEL: **MAP CORR. ONLY PER SURVEY PATRICK MCGANNON**

STARTING POINT: CL OF OBERLIN AVE. & COOPER FOSTER PARK RD.

22-04933-C

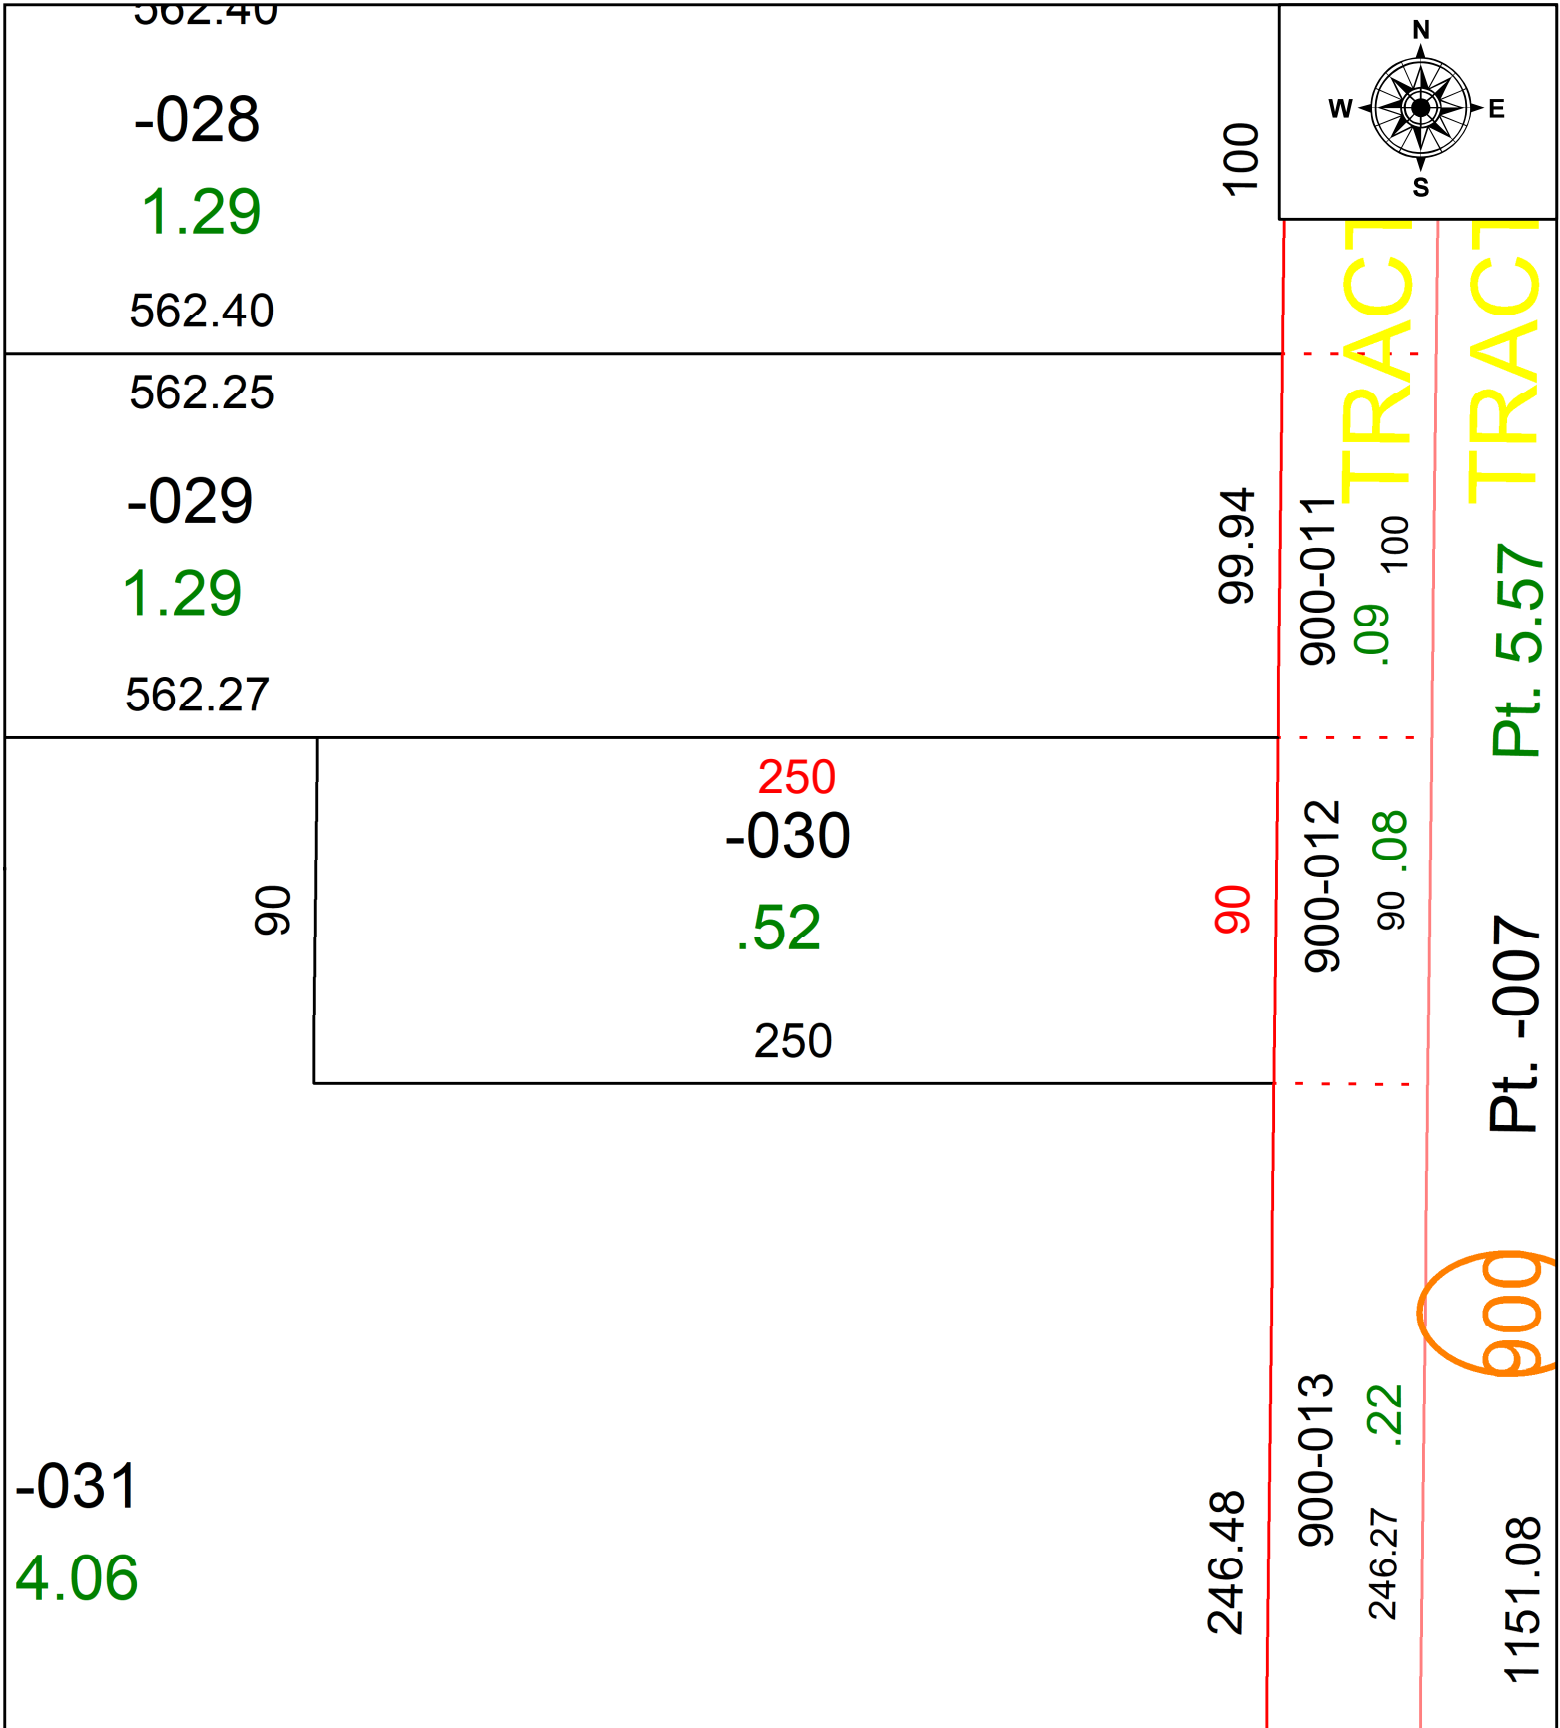

**SPLITS/DEEDS PROCESSED**  
LORAIN COUNTY TAX MAP DEPARTMENT  
226 MIDDLE AVE. ELYRIA, OH

SURVEYED BY: PATRICK MCGANNON	SURVEY #: 50671
CLOSURE: 1:-2147483648	
MAP PAGE(S): 02-02-005	
APPROVED BY: DMA	DATE: 8/17/2022
SCALE: 1" = 50'	PRIOR INSTRUMENT: 2020-0748316