


PARENT PARCEL: 07-00-005-108-001 & -003

CHILD PARCEL: 07-00-005-108-087, -088, & -089

STARTING POINT: **AC CORR PER SURV BY WILFREDO BARBOSA**

24-04936

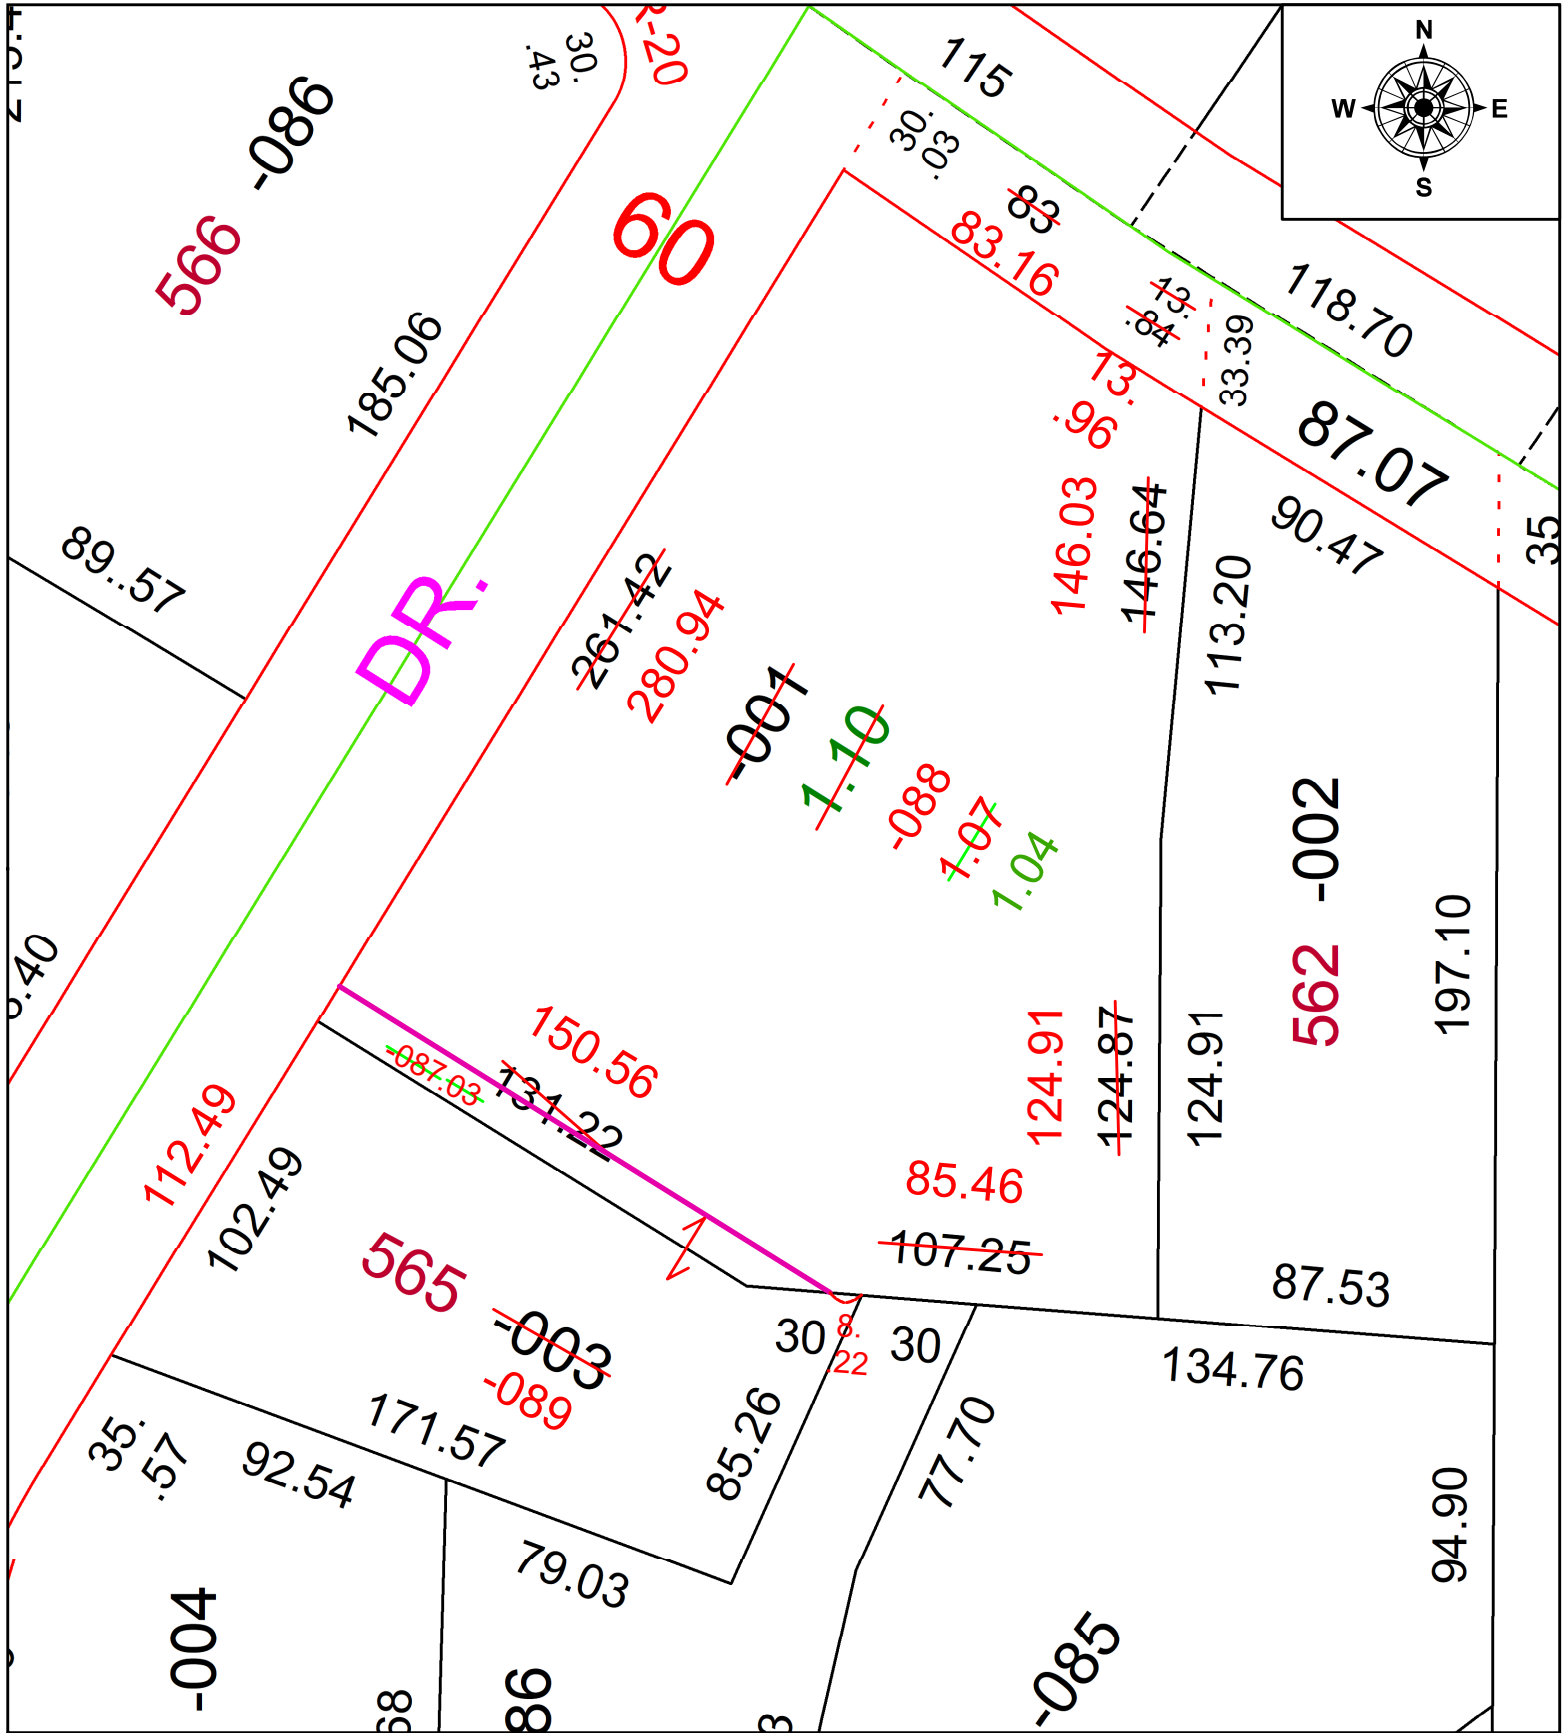

SPLITS/DEEDS PROCESSED
 LORAIN COUNTY TAX MAP DEPARTMENT
 226 MIDDLE AVE. ELYRIA, OH

SURVEYED BY: WILFREDO BARBOSA SURV # 51322
 CLOSURE: 1: 146639
 MAP PAGE(S): 07-00-005
 APPROVED BY: AC DATE: November 08, 2024
 SCALE: 1 in = 50 ft PRIOR INSTRUMENT: 2013-0487262