


PARENT PARCEL: 06-22-017-102-025

CHILD PARCEL: 06-22-017-102-026 & -027

STARTING POINT: INTERSECTION OF OG LOT 17 AND GLADYS AVE

24-04939

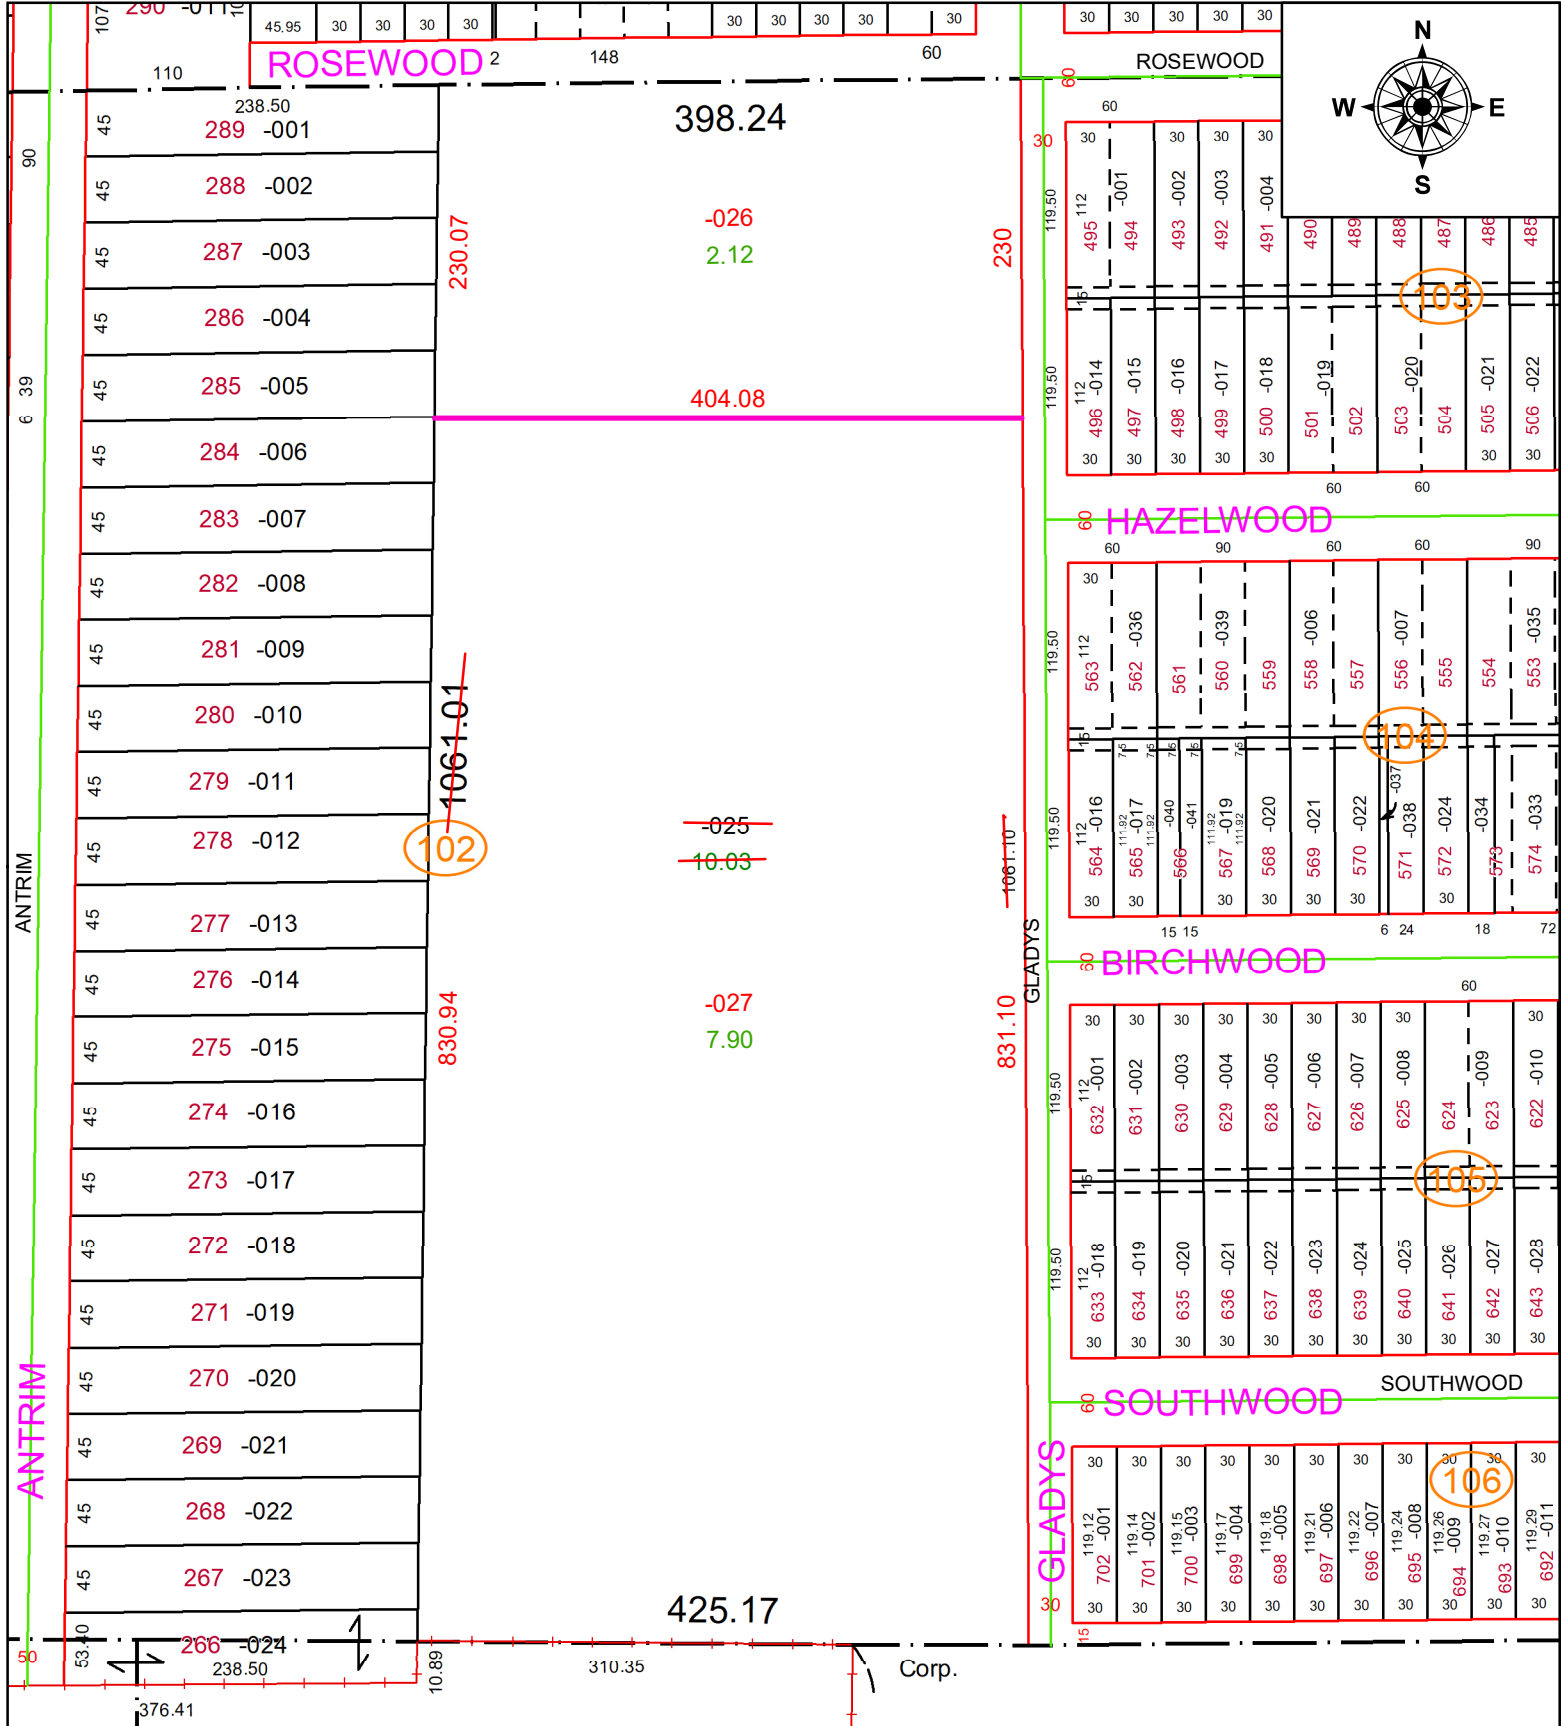

SPLITS/DEEDS PROCESSED
 LORAIN COUNTY TAX MAP DEPARTMENT
 226 MIDDLE AVE. ELYRIA, OH

SURVEYED BY: WILFREDO BARBOSA **SURVEY #:** 51326
CLOSURE: 1: 457070
MAP PAGE(S): 06-22-017
APPROVED BY: BB **DATE:** 11/15/2024
SCALE: 1" = 130' **PRIOR INSTRUMENT:** #20210827672